




PLAT OF SURVEY  
 OF  
 A PARCEL OF LAND LOCATED  
 IN FRACTIONAL SECTION 9  
 T4N R18E WAL. CO. WIS.  
 MARCH 1966

*Lloyd Jensen*  
 COUNTY SURVEYOR

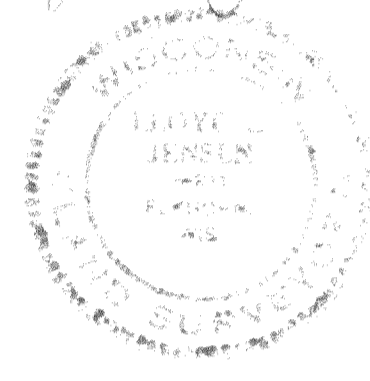

SCALE 1"=40'  
 U - IRON PIPE

SW COR. E. 1/2 OF NW 1/4 OF  
 SEC. 9 T4N R18E

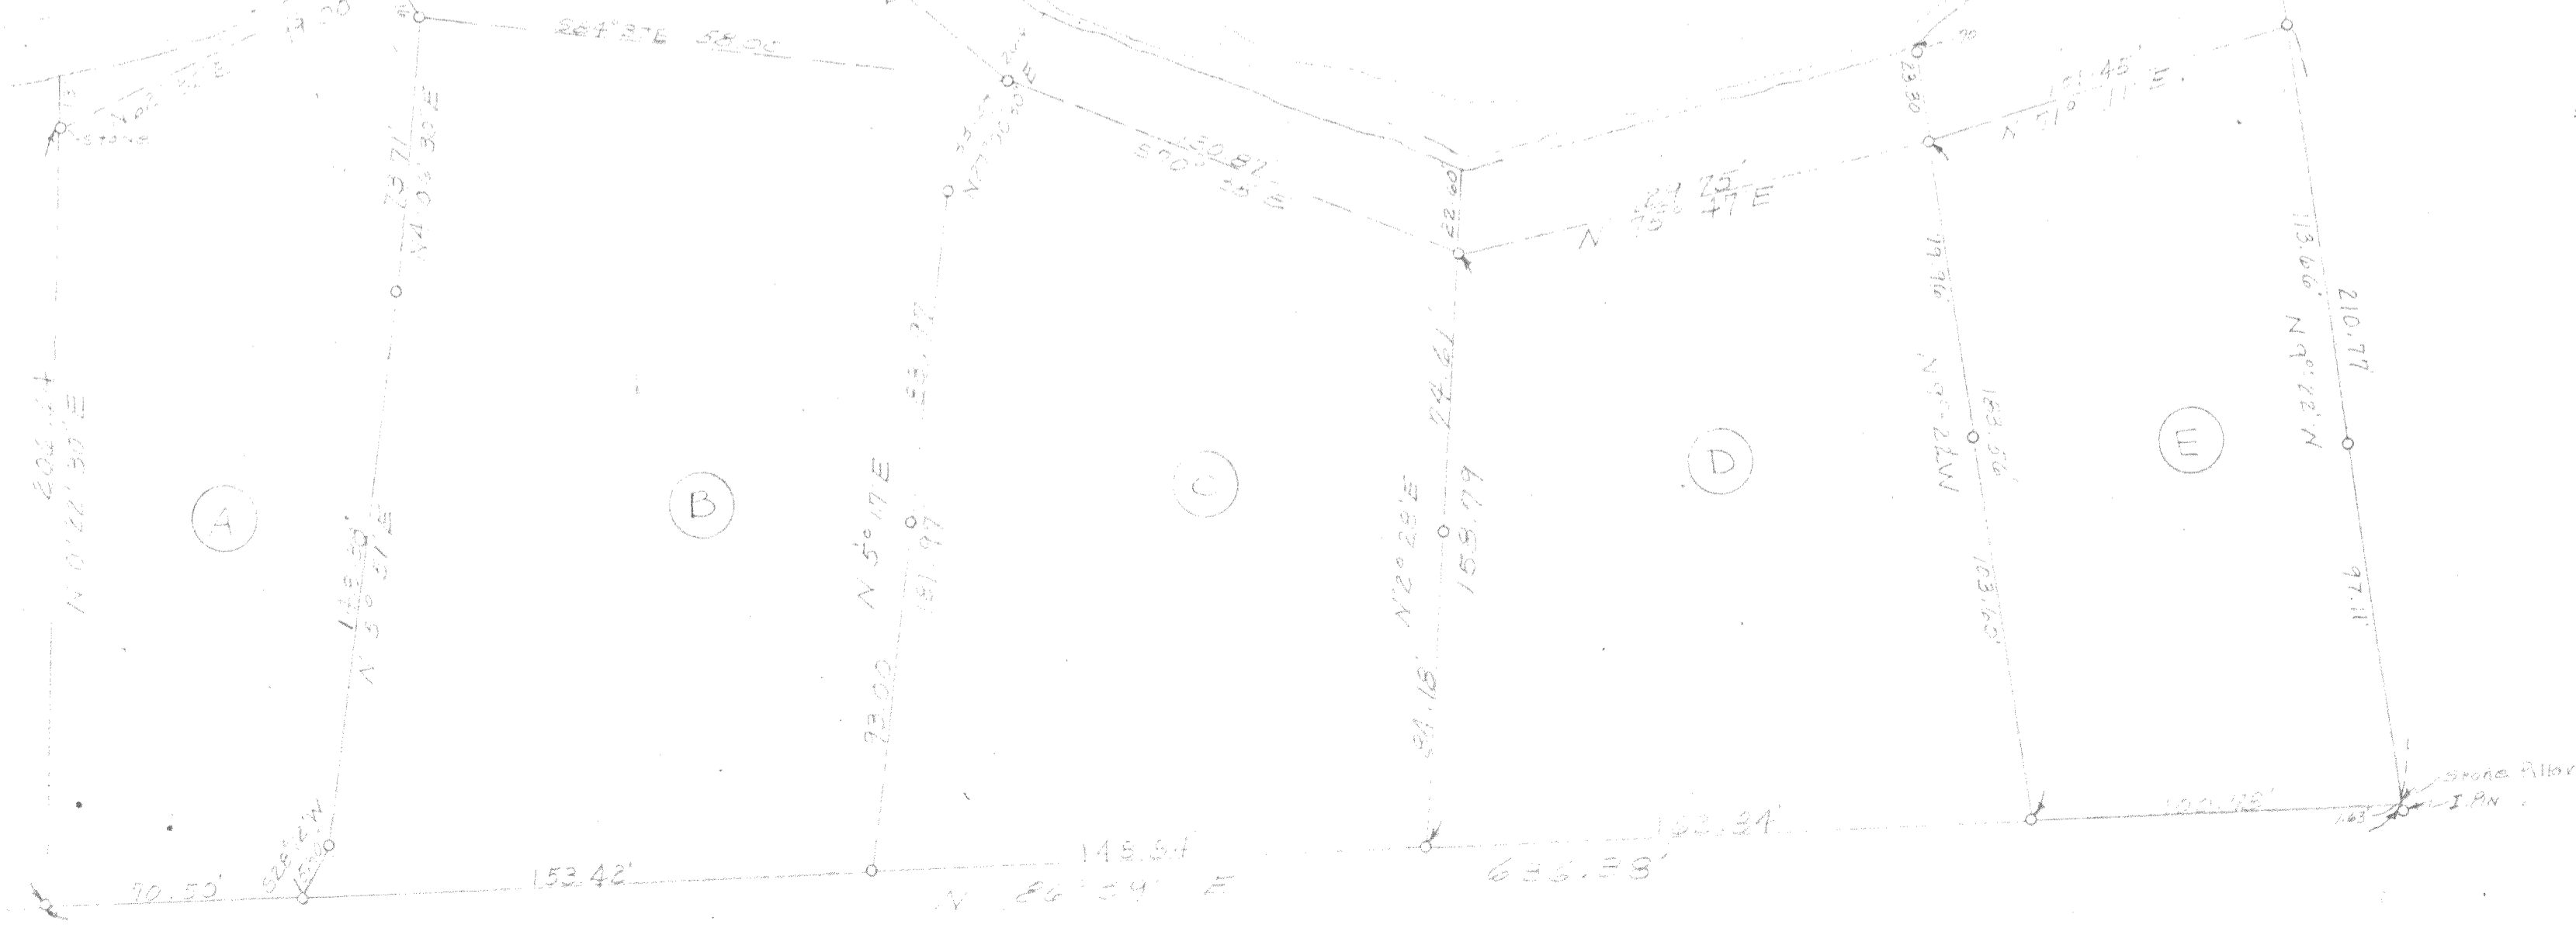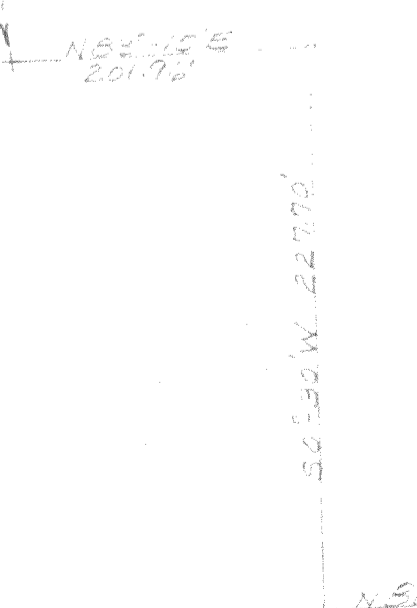

< 5 964, 930C, 30B, 30A

FT-9-29, 30, 30A, 30A+31

418-135J