SUBDIVIDING LOT SURVEYS

KUOKKANEN & ASSOCIATES, INC.

BUILDING SURVEYS LAND DIVISIONS

910 ELM GROVE RD.

ELM GROVE, WISCONSIN 53122

PHONE: 782-8690

99-696-367


PREPARED FOR: John & Sheila Schlump / LOCATION

FAX: 782-1770

Westridge Builders, Inc.

W1131 Hidden Oaks Drive (East Troy)
DESCRIPTION OF PROPERTY

Lot 13 in HIDDEN OAKS, being part of the NE 1/4, SE 1/4, NW 1/4 and SW 1/4 of the SW 1/4 of Section 3, Town 4 North, Range 18 East, Town of East Troy, Walworth County, Wisconsin.

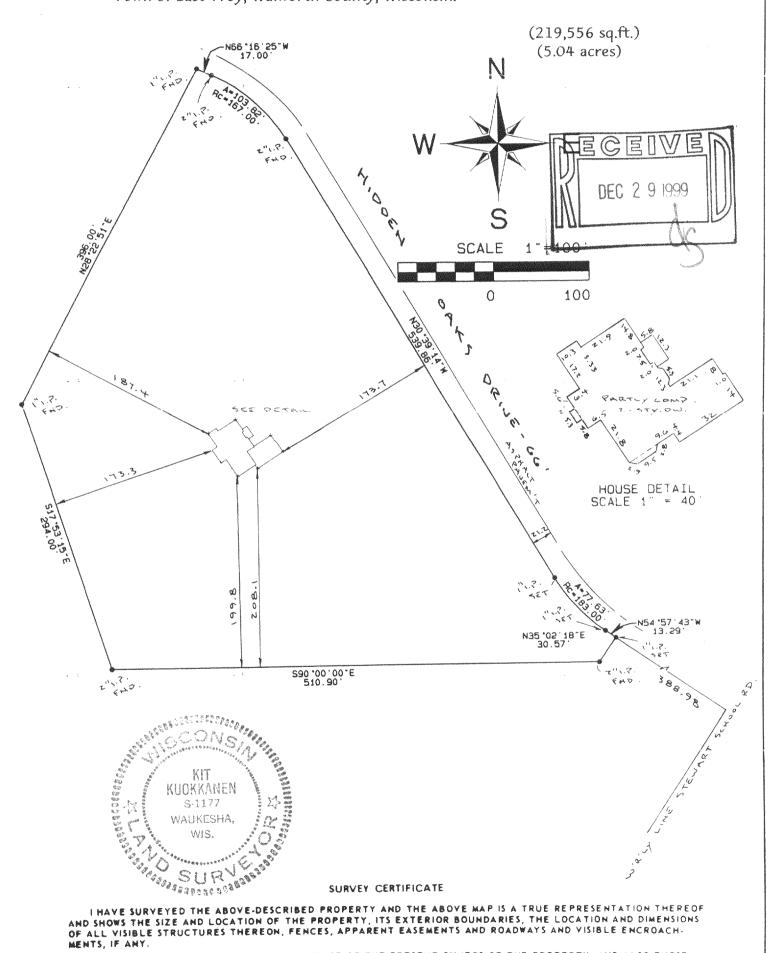

THIS SURVEY IS MADE FOR THE EXCLUSIVE USE OF THE PRESENT OWNERS OF THE PROPERTY, AND ALSO THOSE WHO PURCHASE, MORTGAGE, OR GUARANTEE THE TITLE THERETO WITHIN ONE (1) YEAR FROM DATE HEREOF.