



# PLAT OF SURVEY


LOT 8 OF BLOCK 1 OF CLEARVIEW  
A SUBDIVISION LOCATED IN SECTION  
18, TOWN 4 NORTH, RANGE 18 EAST,  
WALWORTH COUNTY, WISCONSIN

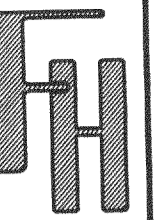

PLAT OF SURVEY  
LOT 8 OF BLOCK 1 OF CLEARVIEW SUBDIVISION  
TOWN OF EAST TROY  
WALWORTH COUNTY, WISCONSIN

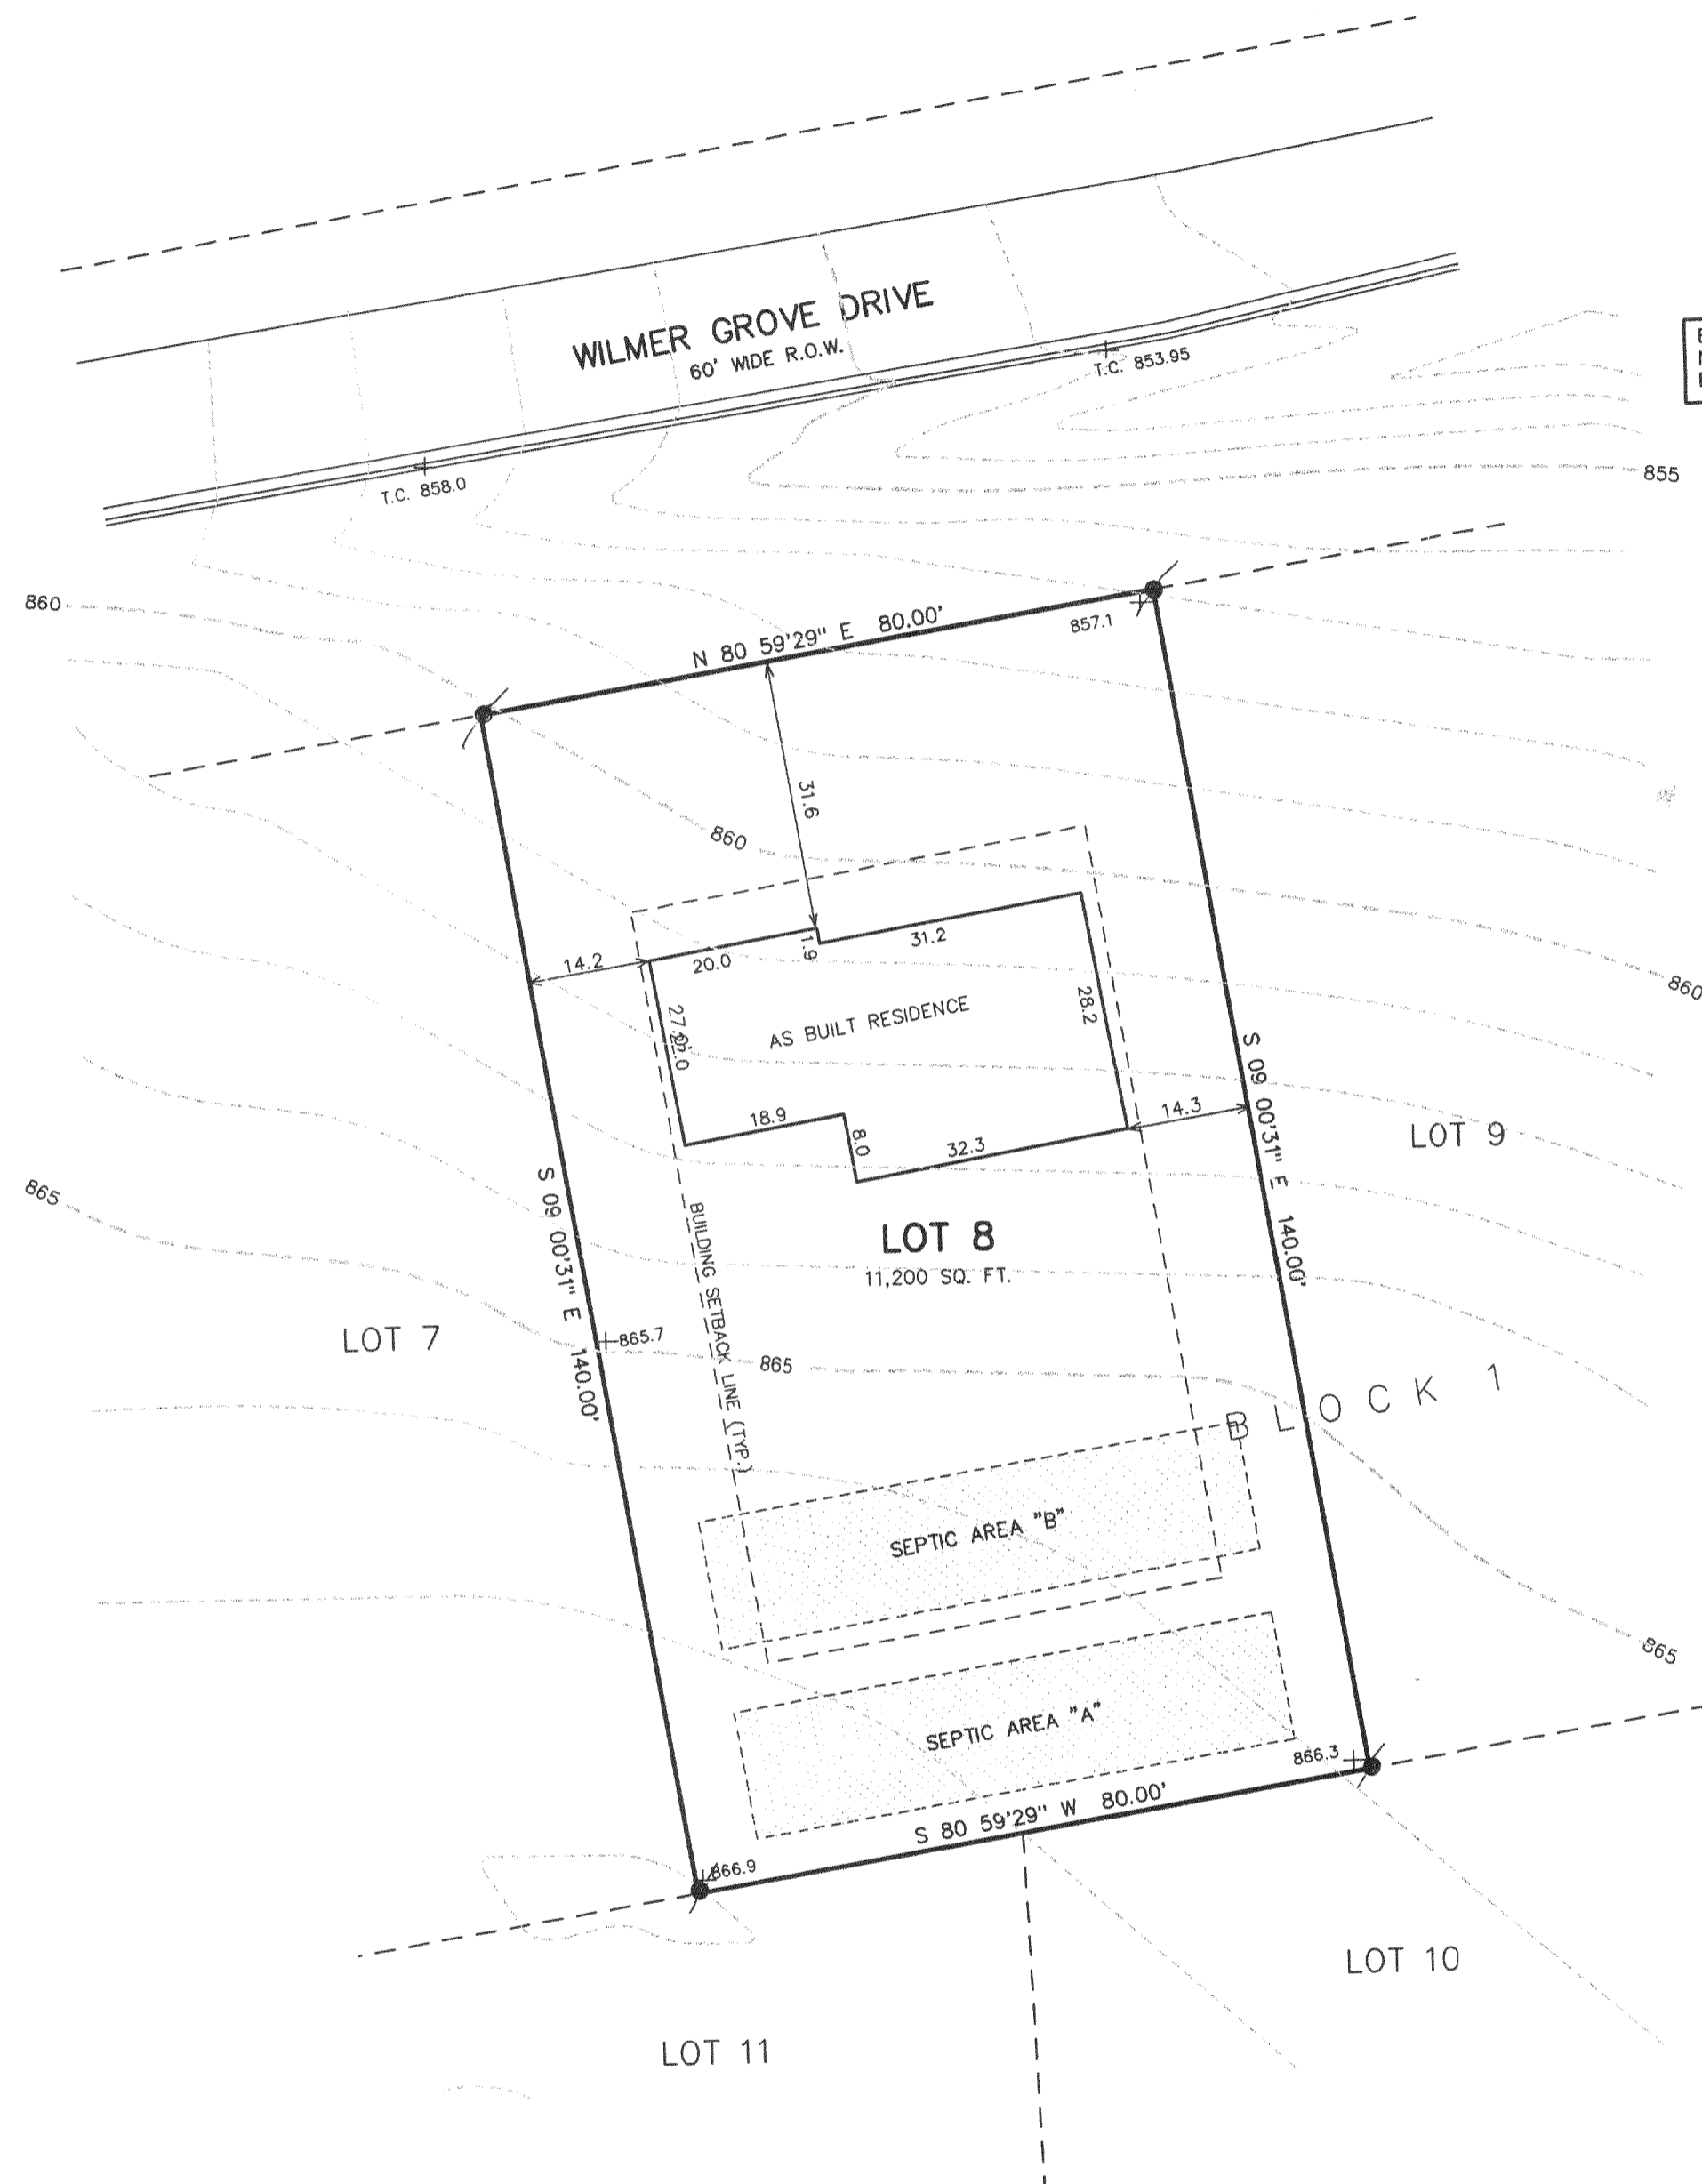

- LEGEND
- = FOUND IRON PIPE STAKE
  - ⦿ = FOUND IRON REBAR STAKE
  - = SET IRON REBAR STAKE
  - (XXX) = RECORDED AS
  - T.C. = TOP OF CURB
  - T.O.F. = TOP OF FOUNDATION WALL
  - G.E. = GARAGE ENTRY
  - = SILT FENCE
  - = PROPOSED FINISH ELEVATION

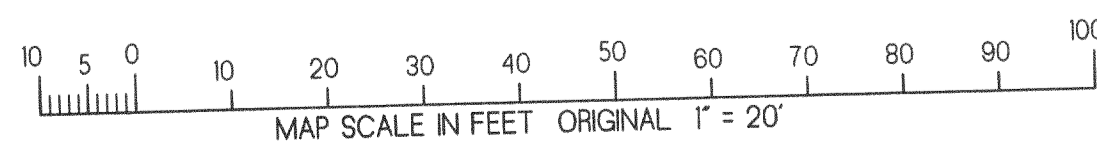


NOTE: COPIES OF THIS MAP TO WHICH THE FOLLOWING CERTIFICATE WILL APPLY SHOW THE SURVEYOR'S ORIGINAL SEAL AND SIGNATURE IN RED INK. COPIES BY ANY OTHER MEANS MAY HAVE ALTERATIONS WHICH DO NOT REPRESENT THE SURVEYOR'S WORK PRODUCT.

I HEREBY CERTIFY THAT THE ABOVE DESCRIBED PROPERTY HAS BEEN SURVEYED UNDER MY DIRECTION AND THAT THE ABOVE MAP IS A TRUE REPRESENTATION THEREOF AND SHOWS THE SIZE AND LOCATION OF THE PROPERTY AND ITS EXTERIOR BOUNDARIES. THIS SURVEY IS MADE FOR THE USE OF THE PRESENT OWNERS OF THE PROPERTY, AND ALSO THOSE WHO PURCHASE, MORTGAGE, OR GUARANTEE THE TITLE THERETO WITHIN ONE YEAR FROM THE DATE HEREOF.

DATED: 10-06-99

*Peter S. Gordon*  
PETER S. GORDON R.L.S. 2101

*Revised 12/21/89  
to show size & location  
of ASBUILT FOUNDATION.*

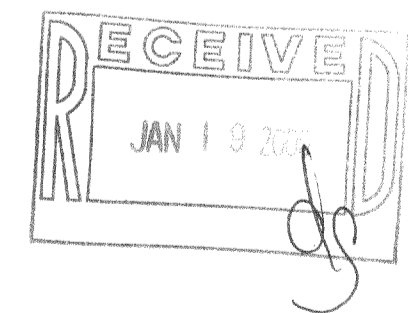

FARRIS, HANSEN & ASSOCIATES, INC.  
Engineering, Architecture, Surveying  
7 Ridgway Court P.O. Box 437  
ELKHORN, WISCONSIN 53121  
Office: (414) 723-2098  
Fax: (414) 723-5886

REVISIONS

PROJECT NO.  
4121.01-08  
DATE:  
09/17/99  
SHEET NO.  
1 OF 1

418-1367

PCV-8