
## **PLAT OF SURVEY**

LOCATION:

East Shore Road, East Troy, Wisconsin

**LEGAL DESCRIPTION:** Lot 50 in **FAIRWAY SUBDIVISION**, being a re-subdivision of part of Williams Park Subdivision, located in the Southwest 1/4 of the Northeast 1/4 and the Southeast 1/4 of the Northwest 1/4 of Section 4, Town 4 North, Range 18 East, Town of East Troy, Walworth County, Wisconsin.

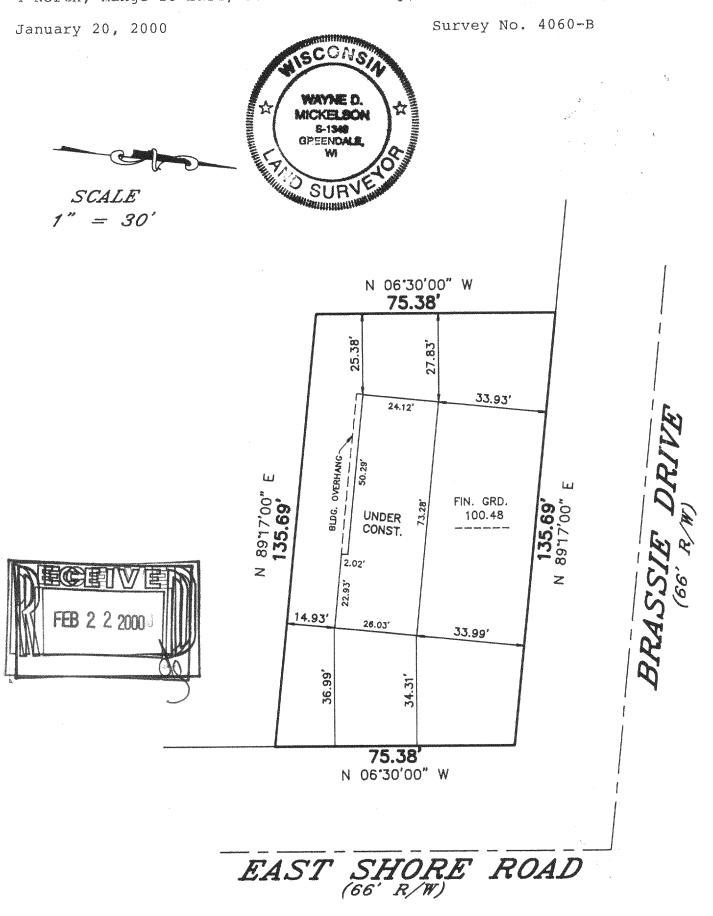

## METROPOLITAN ENTERPRISES, INC.

REGISTERED LAND SURVEYORS
9415 W. POREST HOME AVE., SUITE 202, HALES CORNERS, WI 53130
PH. 529-6380 FAX 529-6787

I HEREBY CERTIFY THAT I HAVE SURVEYED THE ABOVE DESCRIBED PROPERTY AND THAT THE ABOVE MAP IS A TRUE REPRESENTATION THEREOF AND SHOWS THE SIZE AND LOCATION OF THE PROPERTY. ITS EXTERIOR BOUNDARIES, THE LOCATION OF ALL VISIBLE STRUCTURES AND DIMENSIONS OF ALL PRINCIPAL BUILDINGS THEREON, BOUNDARY FENCES, APPARENT EASEMENTS AND ROADWAYS AND VISIBLE ENCROACHMENTS, IF ANY.

THIS SURVEY IS MADE FOR THE EXCLUSIVE USE OF THE PRESENT OWNERS OF THE PROPERTY, AND ALSO THOSE WHO PURCHASE, MORTGAGE, OR GUARANTEE THE TITLE THERETO WITHIN ONE (1) YEAR PRIOR DATE HEREOF.

418-1374 DC-50 Wayne D. Mickelson
Residered Land Surveyor S-1346