


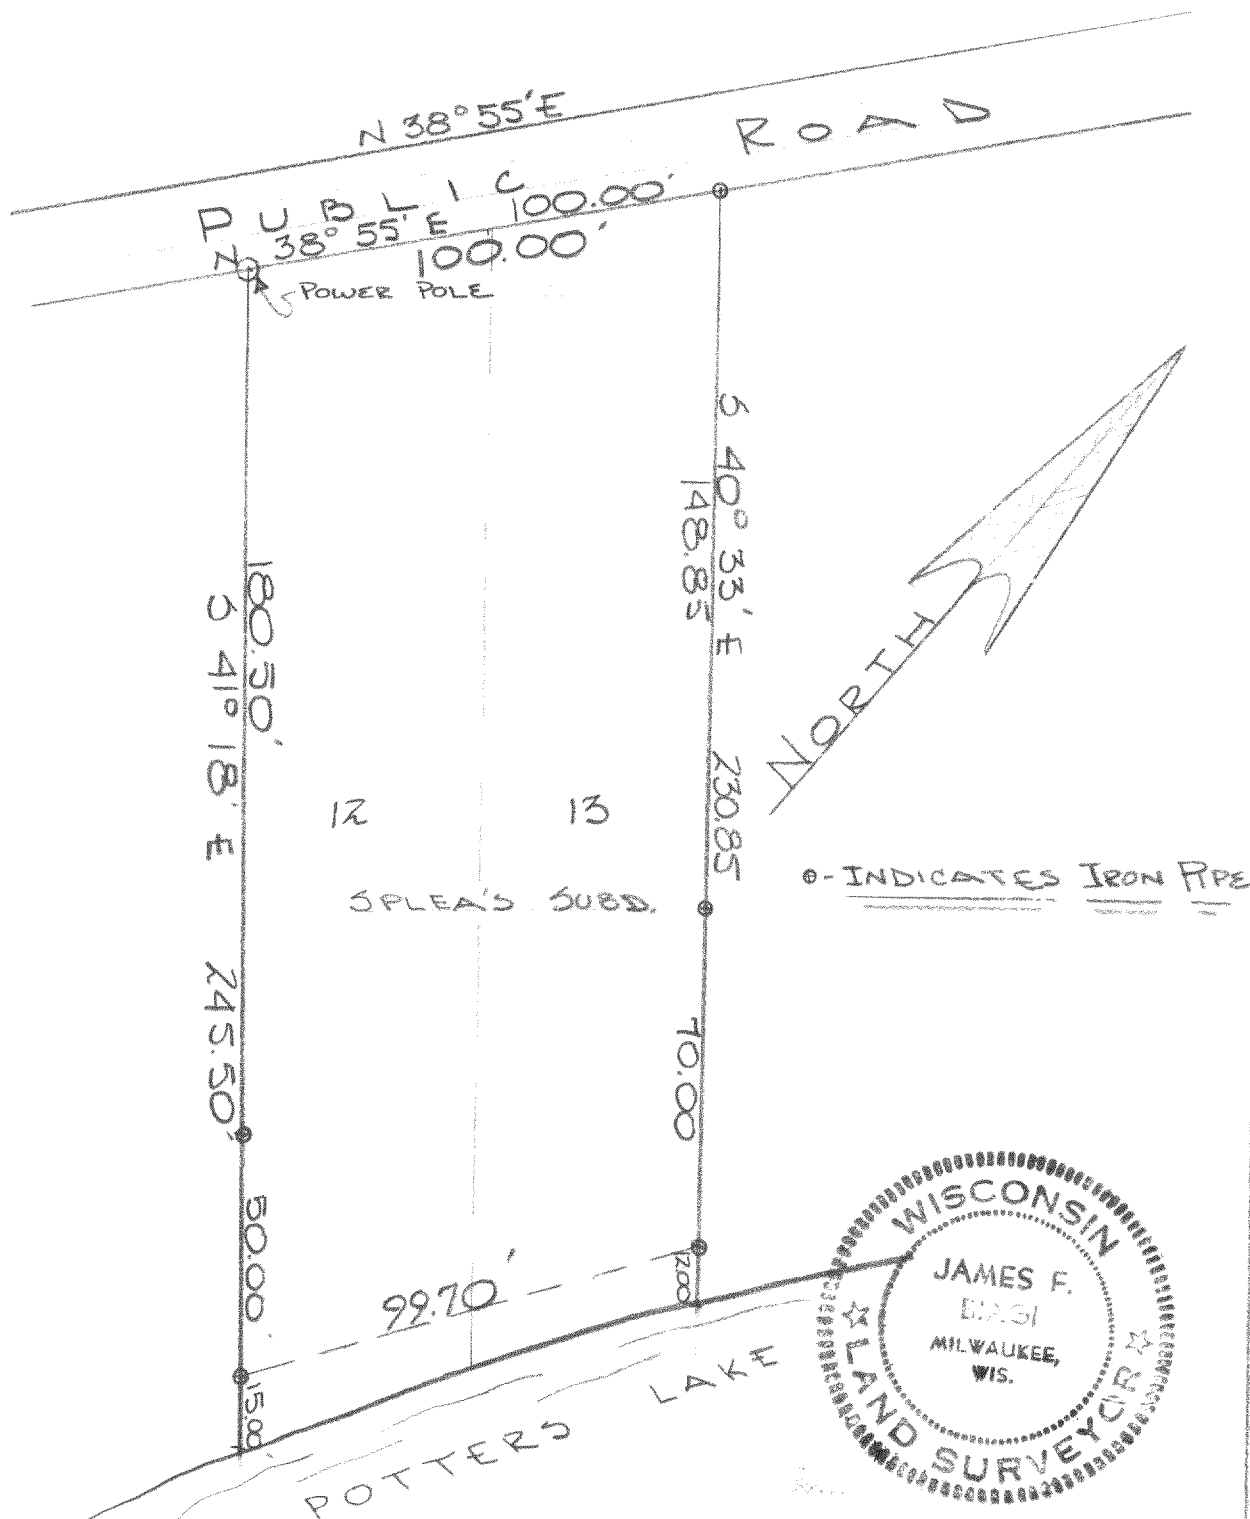

DESCRIPTION: Lots 12 & 13 of Spleas Subdivision located in T. 4 N., R. 18 E. Walworth County, Wisconsin.

CERTIFICATE: I, James F. Biagi, Surveyor, do hereby certify that I have surveyed the property hereon described on this 8th day of September of 1961.

James F. Biagi
James F. Biagi RLS 272