

PLAT OF SURVEY

RSV ENGINEERING, INC
ENGINEERS, PLANNERS, SURVEYORS
CONSTRUCTION MANAGERS
ENVIRONMENTAL SCIENTISTS
801 MAIN STREET, MUKWONAGO, WISCONSIN 53149 (262) 363-2004

FOR: BERNICE A. PAULY


DATE: 11-29-00

DESCRIPTION:

PART OF LOTS 134 AND 135 OF THE PLAT OF BEULAH HEIGHTS SUBDIVISION, WALWORTH COUNTY, WISCONSIN, WHICH SUBDIVISION IS LOCATED IN SECTIONS 7, 8, 17, AND 18 OF TOWN 4 NORTH, RANGE 18 EAST, DESCRIBED AS FOLLOWS: BEGINNING AT THE NORTHWESTERLY CORNER OF SAID LOT 134; THENCE S89°36'05"E, A DISTANCE OF 41.73' TO A POINT; THENCE S14°15'57"E, A DISTANCE OF 143.25' TO A POINT; THENCE S75°44'03"W, A DISTANCE OF 34.22' TO A POINT; THENCE S14°15'57"E, A DISTANCE OF 109.13' TO A POINT ON A MEANDER LINE OF LAKE BEULAH; THENCE N87°34'02"W, A DISTANCE OF 43.10' TO A POINT; THENCE N14°15'57"W, A DISTANCE OF 260.03' TO A POINT; THENCE S89°10'56"E, A DISTANCE OF 36.38' TO THE POINT OF BEGINNING; ALSO INCLUDING ALL THE LANDS BETWEEN THE MEANDER LINE AND THE SHORELINE OF LAKE BEULAH.

LEGEND

- IRON PIPE FOUND
- ∅ IRON PIPE SET

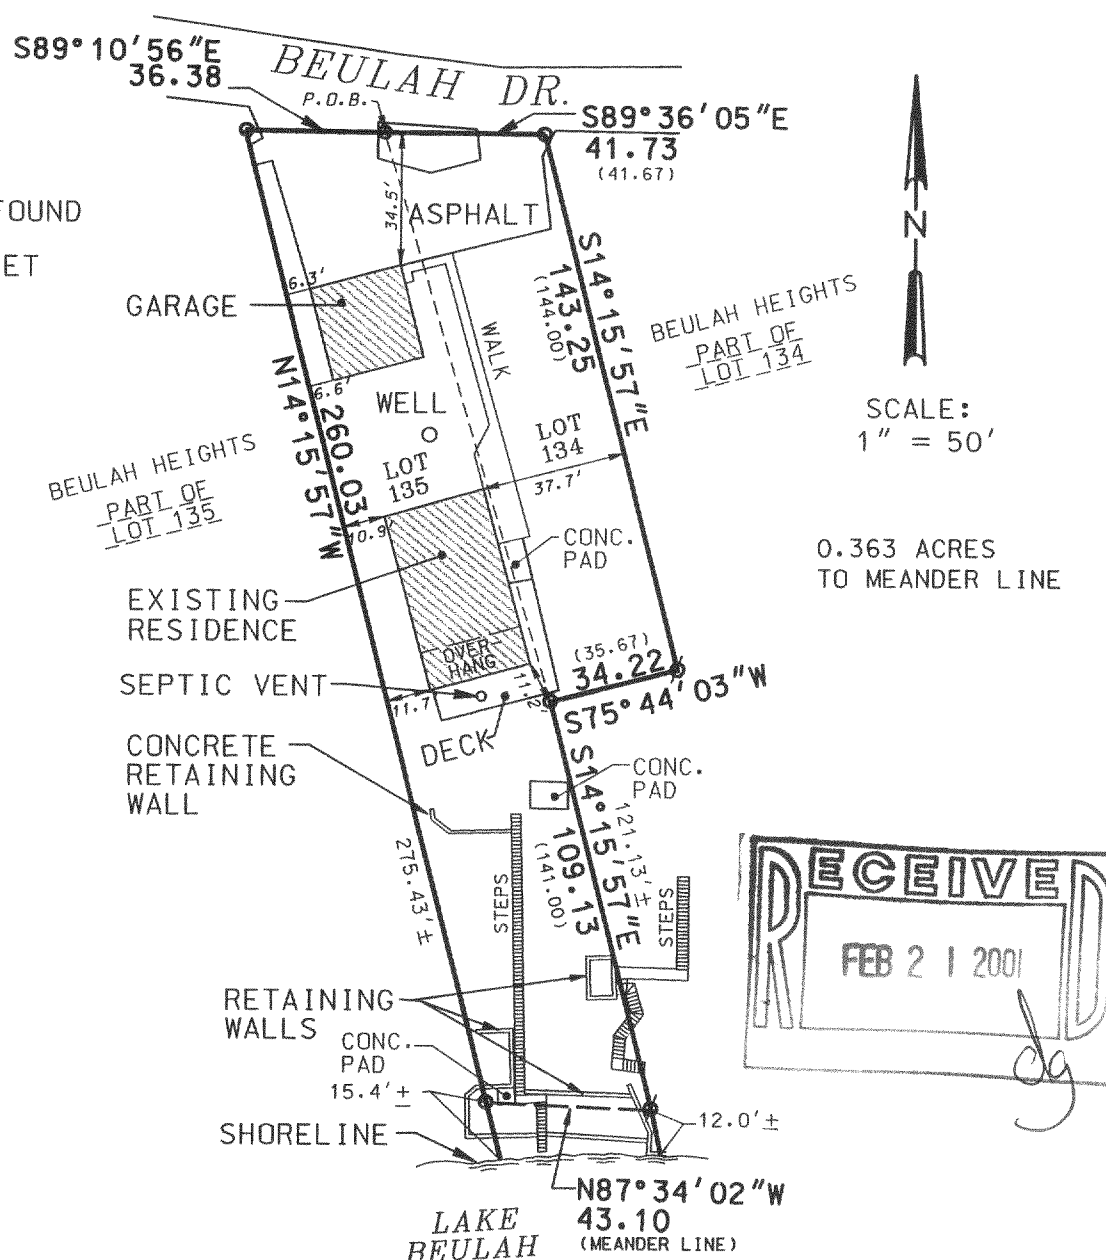

THE ABOVE MAP IS A TRUE REPRESENTATION THEREOF AND SHOWS THE SIZE AND LOCATION OF ALL THE PROPERTY, EXTERIOR BOUNDARIES, THE LOCATION OF ALL VISIBLE BOUNDARY FENCES, APPARENT EASEMENTS, ROADWAYS AND VISIBLE ENCROACHMENTS, IF ANY.

THIS SURVEY IS MADE FOR THE USE OF THE PRESENT OWNERS OF THE PROPERTY, AND ALSO THOSE WHO PURCHASE, MORTGAGE OR GUARANTEE TITLE THERETO WITHIN ONE (1) YEAR FROM DATE HERETO.

BRADFORD L. SPENCER, R.L.S. 2069
RSV#00250

THIS IS ORIGINAL
PRINT ONLY IF
SEAL IS IMPRINTED
IN RED



418-1442

PBH-18