



LOT 25, FAIRWAY SUBDIVISION, being a redivision of part of Williams Park Subdivision, located in the Southwest $\frac{1}{4}$, Northeast $\frac{1}{4}$ and Southeast $\frac{1}{4}$ of the Northwest $\frac{1}{4}$ of Section 4, Town 4 North, range 18 East, Town of East Troy, Walworth County, Wisconsin.

Surveyed for: Bielinski Bros. Builders/Scott and Marolyn Komperud

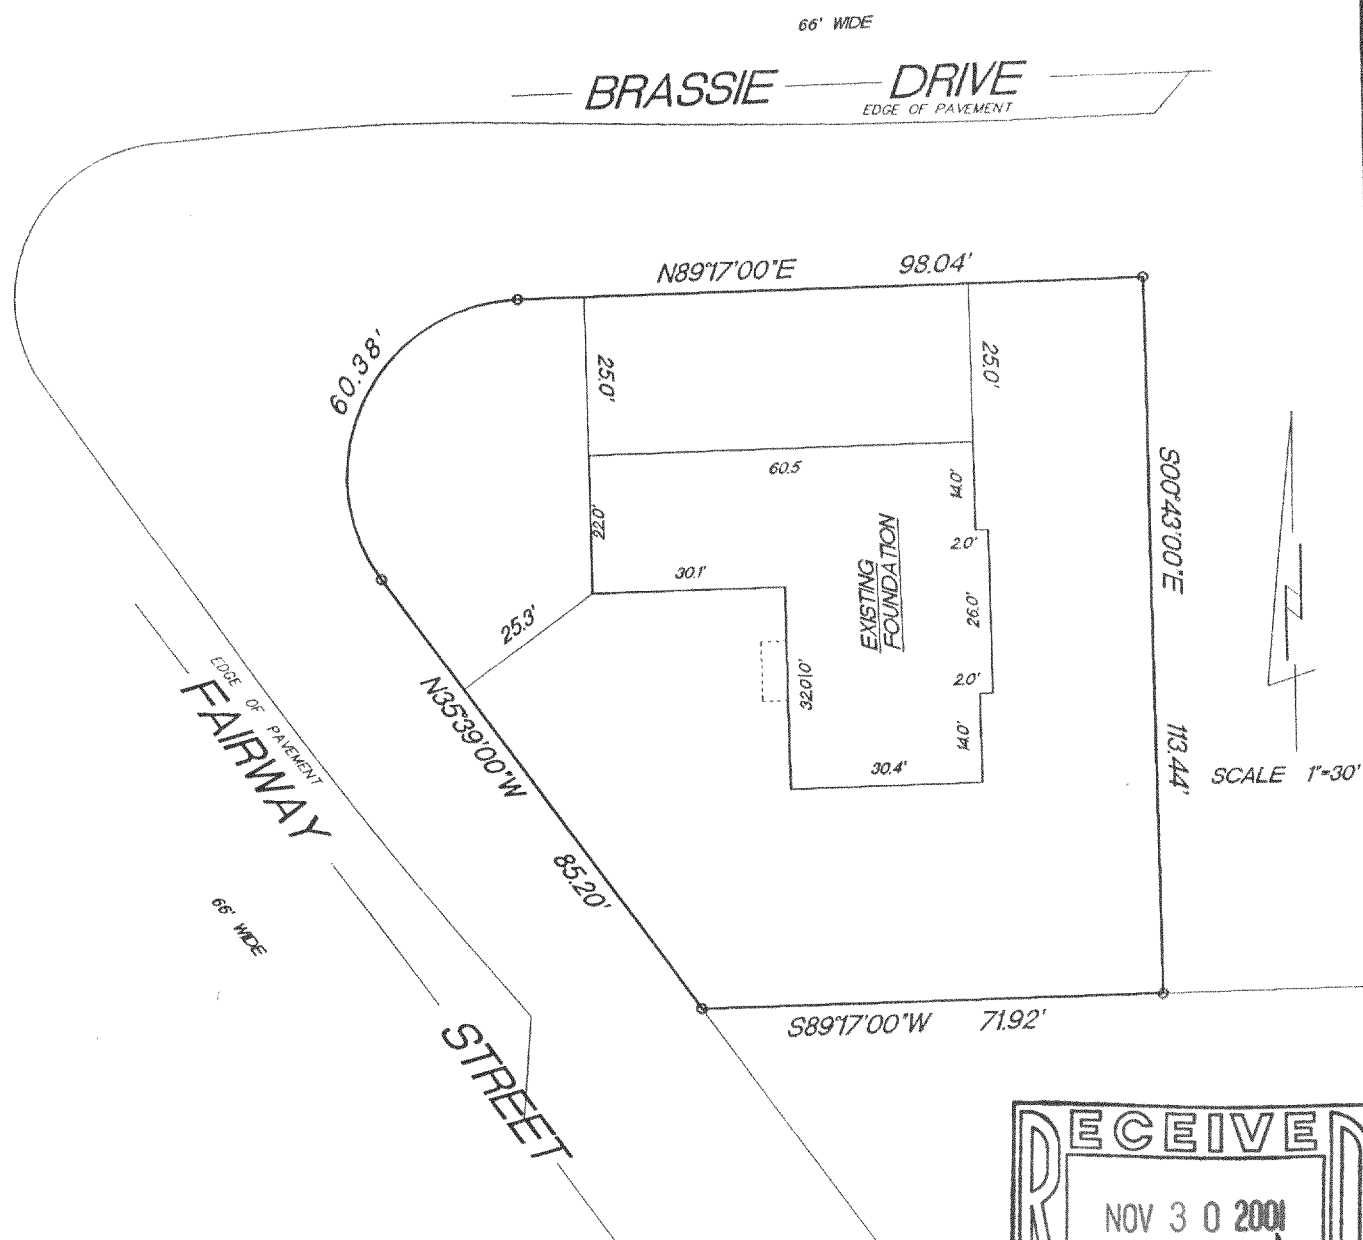

o FOUND 1 1/2" IRON PIPE

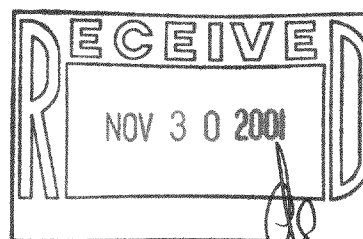


RADIUS	LENGTH	CHORD	BEARING	DELTA
27.72'	60.38'	49.13'	N26°45'28"E	124°48'26"

"I hereby certify that I have surveyed the above described property and that the above map is a true representation thereof and shows the size and location of the property, its exterior boundaries, the location of all visible structures and dimension of all principal buildings thereon, boundary fences, apparent easements, roadways and encroachments if any."

"This survey is made for the use of the present owners of the property, and also those who purchase, mortgage or guarantee the title thereto within one year from date hereof."

KETTLE MORaine SURVEYING
W356 S9050 Godfrey Lane
Eagle Wisconsin 53119
P.O. Box 357
(262) 594-3484

Terrance E. Pisarek R.L.S.

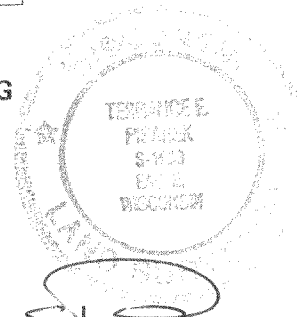

THIS IS NOT AN ORIGINAL SURVEY UNLESS THE SEAL IS RED.

REV. 11/27/01
10/4/01

TEP/DW

TEP

01176

DATE _____

FIELD WORK BY



DRAWN BY

JOB NUMBER

PF-25 ✓ 418-1511

LOT 25, FAIRWAY SUBDIVISION, being a redivision of part of Williams Park Subdivision, located in the Southwest $\frac{1}{4}$, Northeast $\frac{1}{4}$ and Southeast $\frac{1}{4}$ of the Northwest $\frac{1}{4}$ of Section 4, Town 4 North, range 18 East, Town of East Troy, Walworth County, Wisconsin.

Suggested yard grade: 101.5 (to be verified by owner or others)

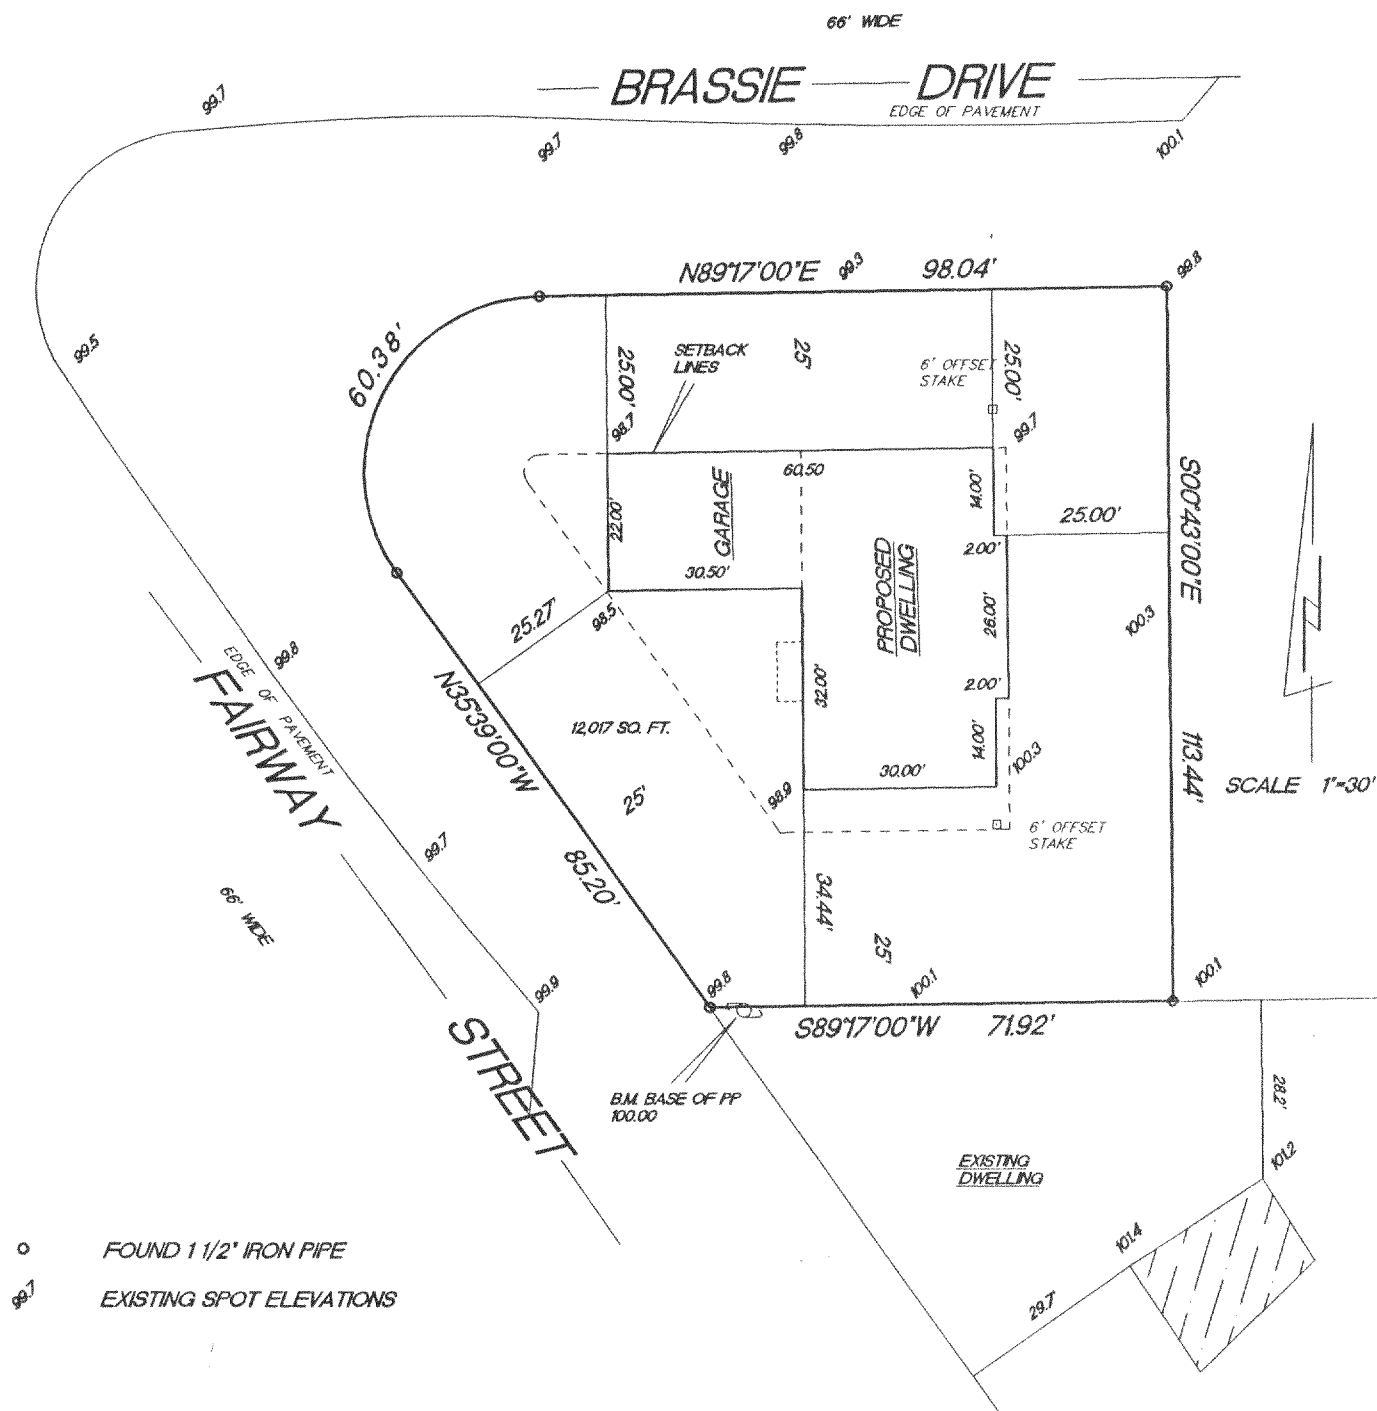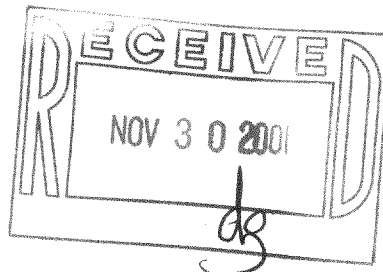

RADIUS	LENGTH	CHORD	BEARING	DELTA
27.72'	60.38'	49.13'	N26°45'28"E	124°48'26"

"This survey is made for the use of the present owners of the property, and also those who purchase, mortgage or guarantee the title thereto within one year from date hereof."

RECEIVED
FBI
JAN 10 1968

THIS IS NOT AN ORIGINAL SURVEY UNLESS THE SEAL IS RED.

DATE _____

FIELD WORK BY

DRAWN BY

JOB NUMBER

PF-25 ✓ 418-1511