ABERNATHY and ASSOCIATES

Kenneth B. Abernathy Jr.

Wisconsin Registered Land Surveyor

W4056 BRAY RD. ELKHORN, WI. 53121

PHONE: (262) 723-4260 (OFFICE)

(262) 723-7209 (FAX)


Email: abernathy@elknet.net

PLAT OF SURVEY

S-1594

LOT 4, IN BLOCK 19, IN MIRAMAR SUBDIVISION ADDITION NO. 1, BEING A SUBDIVISION OF A PART OF THE NORTHWEST 1/4 AND THE SOUTHWEST 1/4 OF THE NORTHEAST 1/4 OF SECTION 10, TOWN 4 NORTH, RANGE 18 EAST, EAST TROY TOWNSHIP, WALWORTH COUNTY, WISCONSIN.

ORDERED BY: SCHAUDER BUILDING, INC. 4115 HIGHWAY 51 NORTH

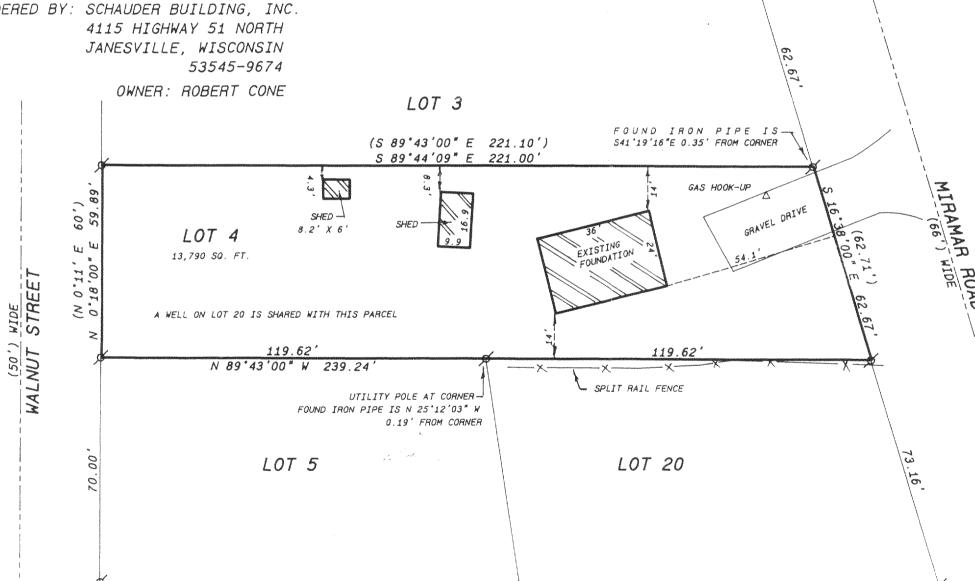

REVISED APRIL 17, 2002 TO SHOW EXISTING FOUNDATION



Legend

A FOUND IRON PIPE

FOUND IRON ROD

FOUND BRASS CAPPED MONUMENT

FOUND CONCRETE MONUMENT

CHISEL CUT IN CONCRETE

SET IRON ROD, 24" LONG, WEIGHING 1.5 LBS./LINEAL FT., 3/4" DIA.

SET IRON ROD, 30" LONG, WEIGHING 4.5 LBS./LINEAL FT., 1-11/16" DIA.

(xx) RECORDED AS DIMENSION

EXISTING FENCE

\$691-S AL YHTAMRIBBA KENNELH B.

"I hereby certify that the above described property has been surveyed. by me or under/my direction and that the above map is a true representation the eof and shows the size and location of the property, its exterior boundaries, the location of all visible structures and dimensions of all principal buildings thereon, boundary fences, apparent easements, roadways and visible encroachments, if any.

"This survey is made for the use of the present owners of the property, and also those who purchase, mortgage, or guarantee the

KENNETH B. ABERNATHY, JR. WISCONSIN REGISTERED LAND SURVEYOR.

Date: 12-21-2001 Job No. 01.1206

418-1535