

PLAT OF SURVEY

RSV

ENGINEERING, INC.


Engineers • Land Surveyors • Environmental Scientists
801 MAIN STREET MUKWONAGO, WISCONSIN 53149 (262)363-2004

FOR: DON & JUDY KRENKE

DATE: 5/29/02

DESCRIPTION:


LOT 47 OF SHOREWOOD HEIGHTS. A SUBDIVISION IN PART OF SECTIONS
10, 11, 14, & 15, TOWN 4 NORTH, RANGE 18 EAST,
TOWN OF EAST TROY, WALWORTH COUNTY, WISCONSIN

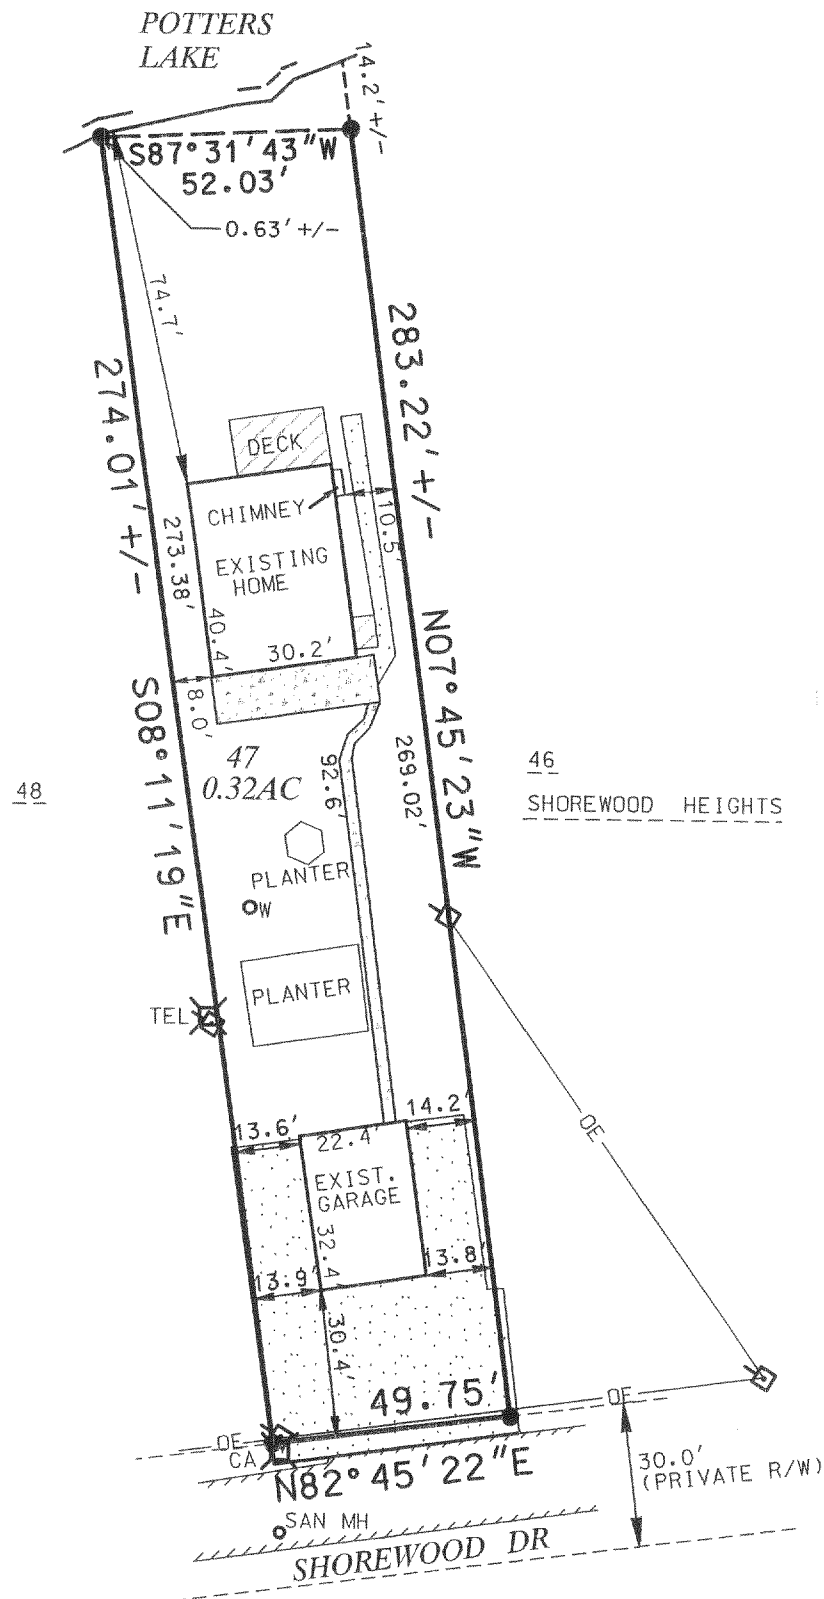

SCALE 1" = 40'

LEGEND


- 1" FOUND IRON PIPE
- W WELL
- DE □ POWER POLE WITH OVERHEAD ELECTRIC
- CA □ UTILITY PEDESTAL
TEL □ CA=CABLE
TEL=TELEPHONE
- EDGE OF PAVEMENT
- CONCRETE
- GRAVEL

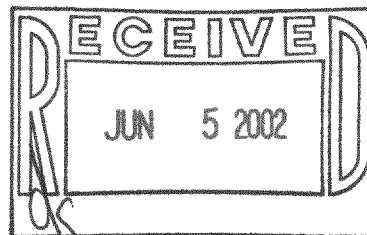

THE ABOVE MAP IS A TRUE REPRESENTATION THEREOF AND SHOWS THE SIZE AND LOCATION OF ALL THE PROPERTY, EXTERIOR BOUNDARIES, THE LOCATION OF ALL VISIBLE BOUNDARY FENCES, APPARENT EASEMENTS, ROADWAYS AND VISIBLE ENCROACHMENTS, IF ANY.

THIS SURVEY IS MADE FOR THE USE OF THE PRESENT OWNERS OF THE PROPERTY, AND ALSO THOSE WHO PURCHASE, MORTGAGE OR GUARANTEE TITLE THERETO WITHIN ONE (1) YEAR FROM DATE HERETO.

THIS IS ORIGINAL
PRINT ONLY IF
SEAL IS IMPRINTED
IN RED

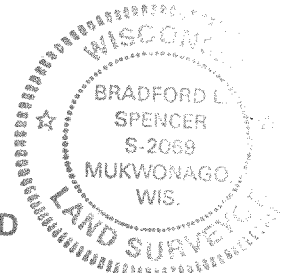

BRADFORD L. SPENCER, R.L.S. 2069
RSV#02188

PS-45A

418-1539