
Plat of Survey

Lot 36 of Shorewood,

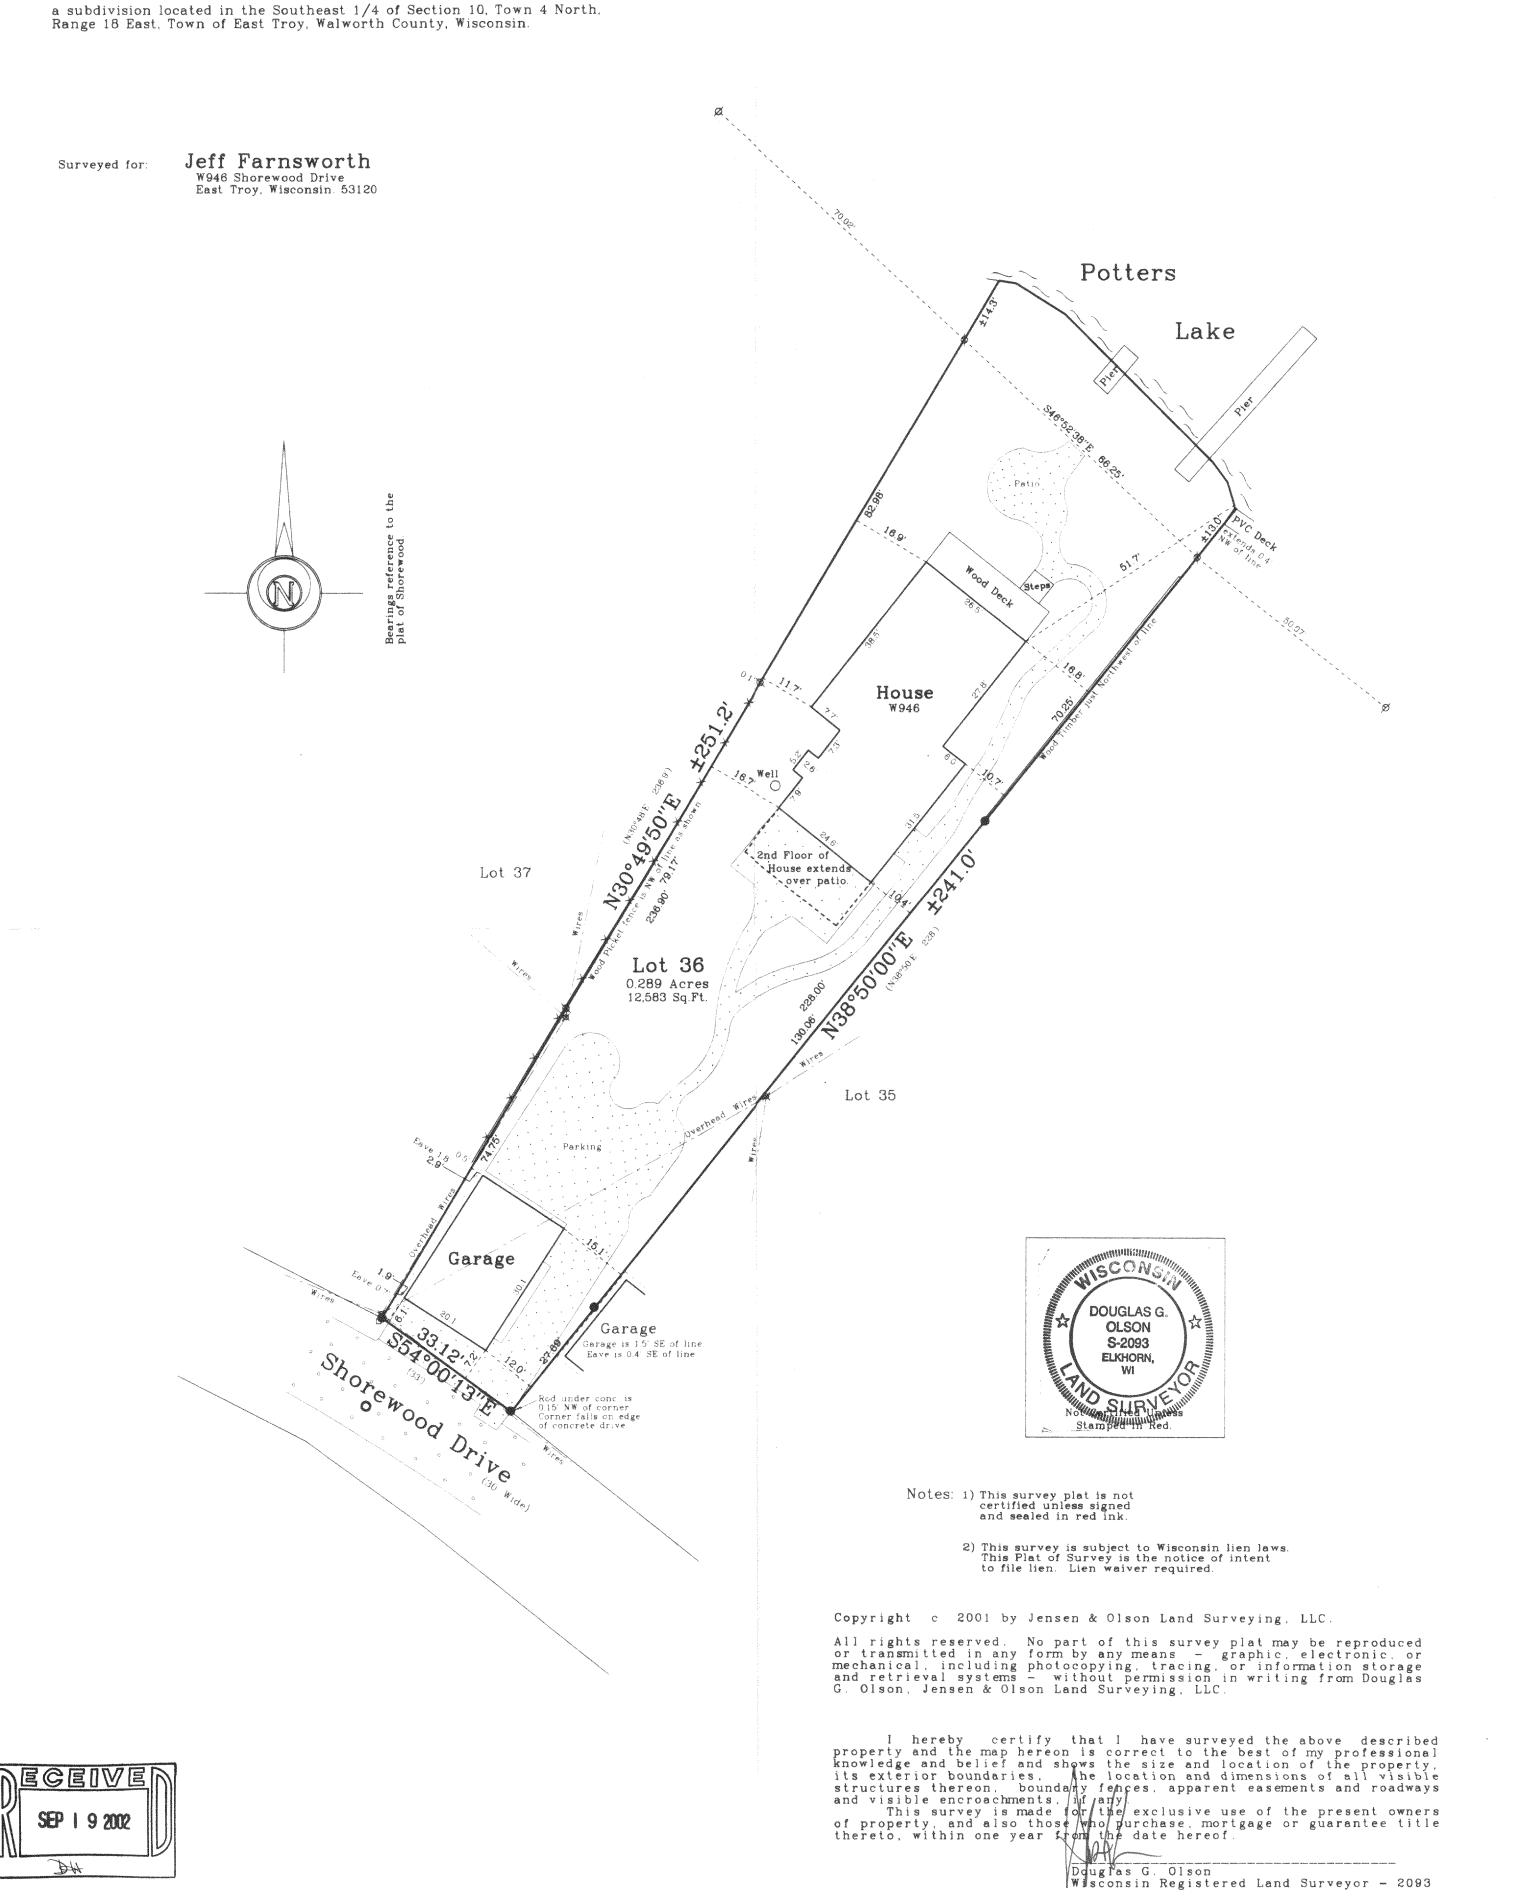

200 Sheet 1 of 1 Sheets Job Reference Number

2001.114

Legend Ø Found Iron Pipe
Found Iron Rod
() Recorded Information
W Utility Pole
Utility Pedestal
Concrete Surface Concrete Surfac

Jensen & Olson Land Surveying, LLC

45 South Wisconsin Street P.O. Box 322 Elkhorn, Wisconsin. 53121 Telephone (262) 723-3434 Facsimile (262) 723-8044

Scale in Feet 1'' = 20'10' 20'

Survey Date: August 17, 2001. Revisions: