


LOT 19 OF OAKWOOD PARK, BEING A
SUBDIVISION IN PART OF GOVERNMENT
LOT 2, IN THE NORTHEAST 1/4 OF
FRACTIONAL SECTION 8, TOWNSHIP 4
NORTH, RANGE 18 EAST, IN THE TOWN
OF EAST TROY, WALWORTH COUNTY,
WISCONSIN.


RECEIVED
JUN - 9 2003
DRP

"I hereby certify that I have surveyed the above described property and that the above map is a correct representation thereof and shows the size and location of the property, its exterior boundaries, the location of all visible structures and dimensions of all principal buildings thereon, boundary fences, apparent easements, roadways and encroachments, if any."

"This survey is made for the use of the present owners of the property, and those who purchase, mortgage, or guarantee the title thereto within one year from date hereof."

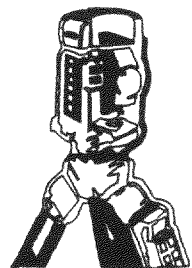


LAND SURVEYS
MAPPING AND PLANNING
412 N. PINE STREET
BURLINGTON, WI 53105
(262)-767-0225

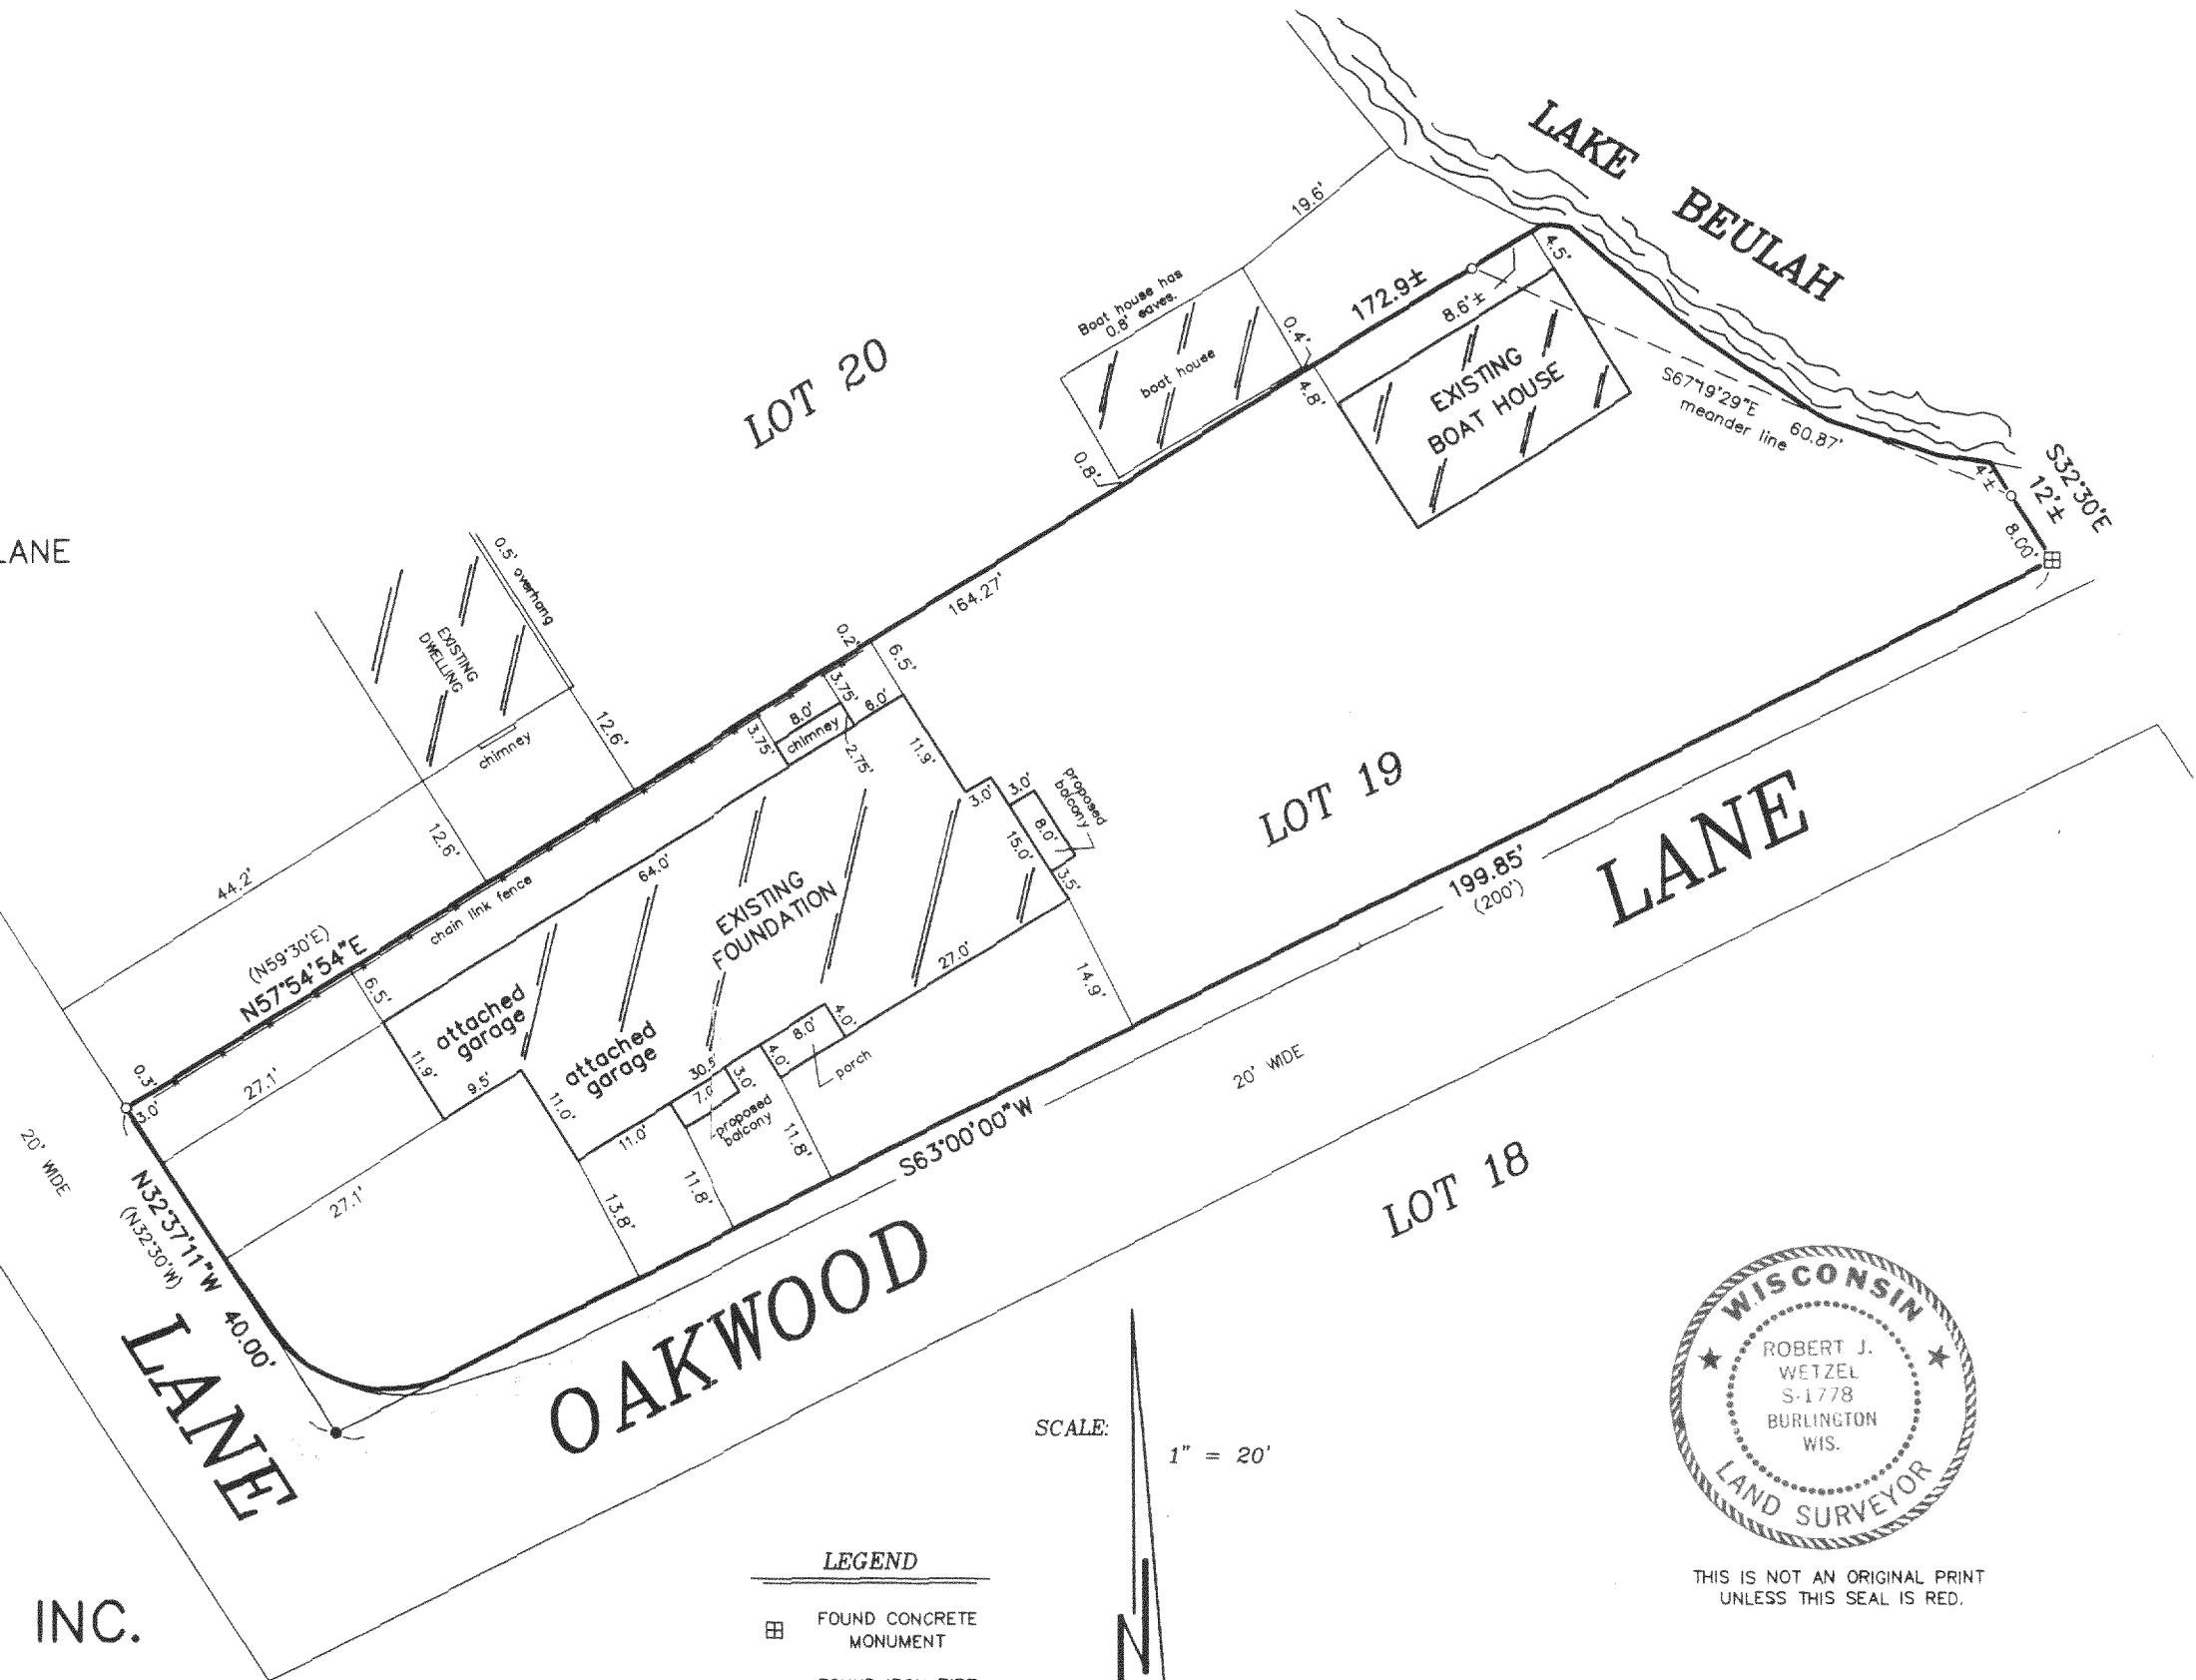

SCALE: $1'' = 20'$

LEGEND

	FOUND CONCRETE MONUMENT
	FOUND IRON PIPE
	FOUND P.K. NAIL
()	RECORDED AS
100.0	EXISTING ELEVATION

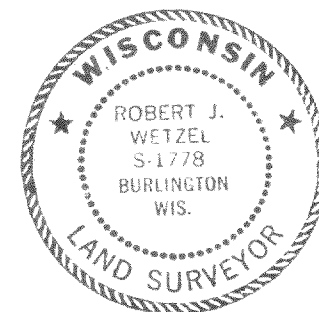

THIS IS NOT AN ORIGINAL PRINT
UNLESS THIS SEAL IS RED.

Robert J. Wetzel
ROBERT J. WETZEL S-1778

MAY 19, 2003 5544
DATE JOB NUMBER