
Commencing at a point where the easterly shore of Army Lake, intersects the southwesterly line of Lot #20, 0ak Park Subdivision of a portion of Section 16, Town 14 north, Range 18 east of the 14th P.M., thence S. 1470 E., 213.75 feet to an iron stake, thence S. 560 50' W., 300.00 feet to an iron stake, the place of beginning of this description, thence S. 240 52' W., 814.9 feet to an iron stake, thence N. 790 02' W., 1143.50 feet to an iron stake, thence N. 100 57 20" E., 200.07 feet to an iron stake, thence S. 430 08' E., 202.55 feet to the place of beginning. Also a right of way over, in along and across, the following tract of land; Commencing at the place of beginning of the property hereinbefore described, thence S. 240 52' W., 216.37 feet, to the northerly line of Sawyer Road, thence S. 680 40' E., 19.45 feet, thence N. 240 52' E. 207.68 feet, thence N. 430 08' W., 20.0 feet to the place of beginning. Also a right of way to the lake, over, in, along and across the following described property, Commencing at an iron stake that is 202.55 feet; N. 430 08' W., of the place of beginning of the property hereinbefore described, thence S. 100 57' 20" W., 340.0 feet, to a point in the northerly line of Sawyer Road, thence S. 680 10'W. 23.7 feet, thence N. 100 57' 20" E., 309.65 feet to the shore of Army Lake, thence northeasterly along the shore of Army Lake to the place of beginning.

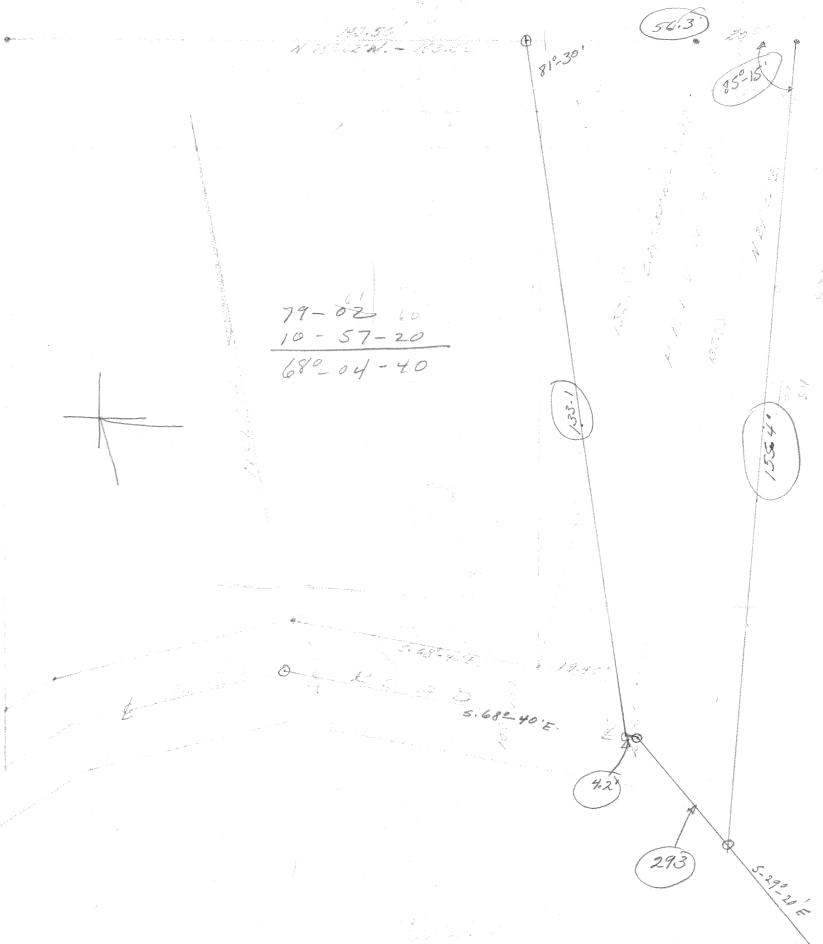

CERTIFICATE: I, hereby certify that I have on this the 9th day of December 1957, surveyed the abovesdescribed property and find that no encroachments exist.

SIGNED AND SEALED ON THIS THE 11TH DAY OF DECEMBER 1957.

Joseph M. Biagi. Registered Surveyor Elkhorn Wisconsin.

PO-12A

PO# 7