

PLAT OF SURVEY

LOT 22, MIRAMAR ADDITION NO. 2. Being a Subdivision of Northeast ¼ of Section 10, and the Northwest ¼ of Section 11, in Township 4 North, Range 18 east, in the Town of East Troy, Walworth County, Wisconsin.

Surveyed for: Bob Zinda

Survey address: W993 Harmony Lane

DEC - 5 2003

KW

66' WIDE

HARMONY LANE

(S89°34'55"E) (213.29') (N89°05'30"E) (62.12')
S89°36'29"E 213.28' N89°09'54"E 65.31'

MIRAMAR

N15°40'06"W
(N15°40'06"W)

ROAD

66' WIDE

305.66'
(305.66')

EXISTING DWELLING

CONC. PORCH

CONC. PATIO

SEPTIC TANK

SEPTIC VENT

PROPOSED SHED
(10'X14')

33.9'

58.0'

204.79'
(204.83')

S75°13'44"W
(S75°12'00"W)

500°28'16"E

(500°31'06"E)

241.59'

(241.46')

- FOUND 2" IRON PIPE
- FOUND 1" IRON PIPE
- ⊙ FOUND 3/4" IRON PIPE
- () RECORDED AS DIMENSIONS


LOT DOES NOT CLOSE AS PLATTED
.04' NORTH AND SOUTH, 3.00' EAST
AND WEST.

"I hereby certify that I have surveyed the above described property and that the above map is a true representation thereof and shows the size and location of the property, its exterior boundaries, the location of all visible structures and dimension of all principal buildings thereon, boundary fences, apparent easements, roadways and encroachments if any."

"This survey is made for the use of the present owners of the property, and also those who purchase, mortgage or guarantee the title thereto within one year from date hereof."

KETTLE MORaine SURVEYING INC.
W356 S9050 Godfrey Lane
Eagle Wisconsin 53119
P.O. Box 357
(262) 594-3484

Terrance E. Pisarek R.L.S.

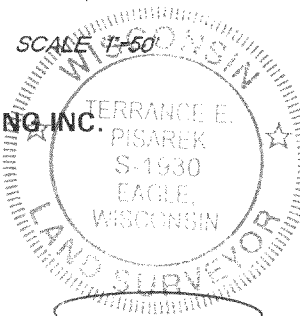

THIS IS NOT AN ORIGINAL SURVEY UNLESS THE SEAL IS RED.

11/20/03

DATE

TEP/DW

FIELD WORK BY

TEP

DRAWN BY

03240

JOB NUMBER

✓ PMR2-22

418-1710