

# PLAT OF SURVEY


**RSV**  
ENGINEERING, INC.

Engineers • Land Surveyors • Environmental Scientists  
801 MAIN STREET SUKWONAGO, WISCONSIN 53149 (262)363-2004

FOR: COELLO ASSOCIATES, INC.

DATE: 7/14/2003

DESCRIPTION: BEING LOT 17 OF EASTWOOD ESTATES,  
PART OF THE SE<sup>1</sup>/<sub>4</sub> AND SW<sup>1</sup>/<sub>4</sub> OF THE NW<sup>1</sup>/<sub>4</sub> AND PART  
OF THE NW<sup>1</sup>/<sub>4</sub> OF THE SW<sup>1</sup>/<sub>4</sub> OF SECTION 11, TOWN 4 NORTH,  
RANGE 18 EAST, TOWN OF EAST TROY, WALWORTH COUNTY, WISCONSIN

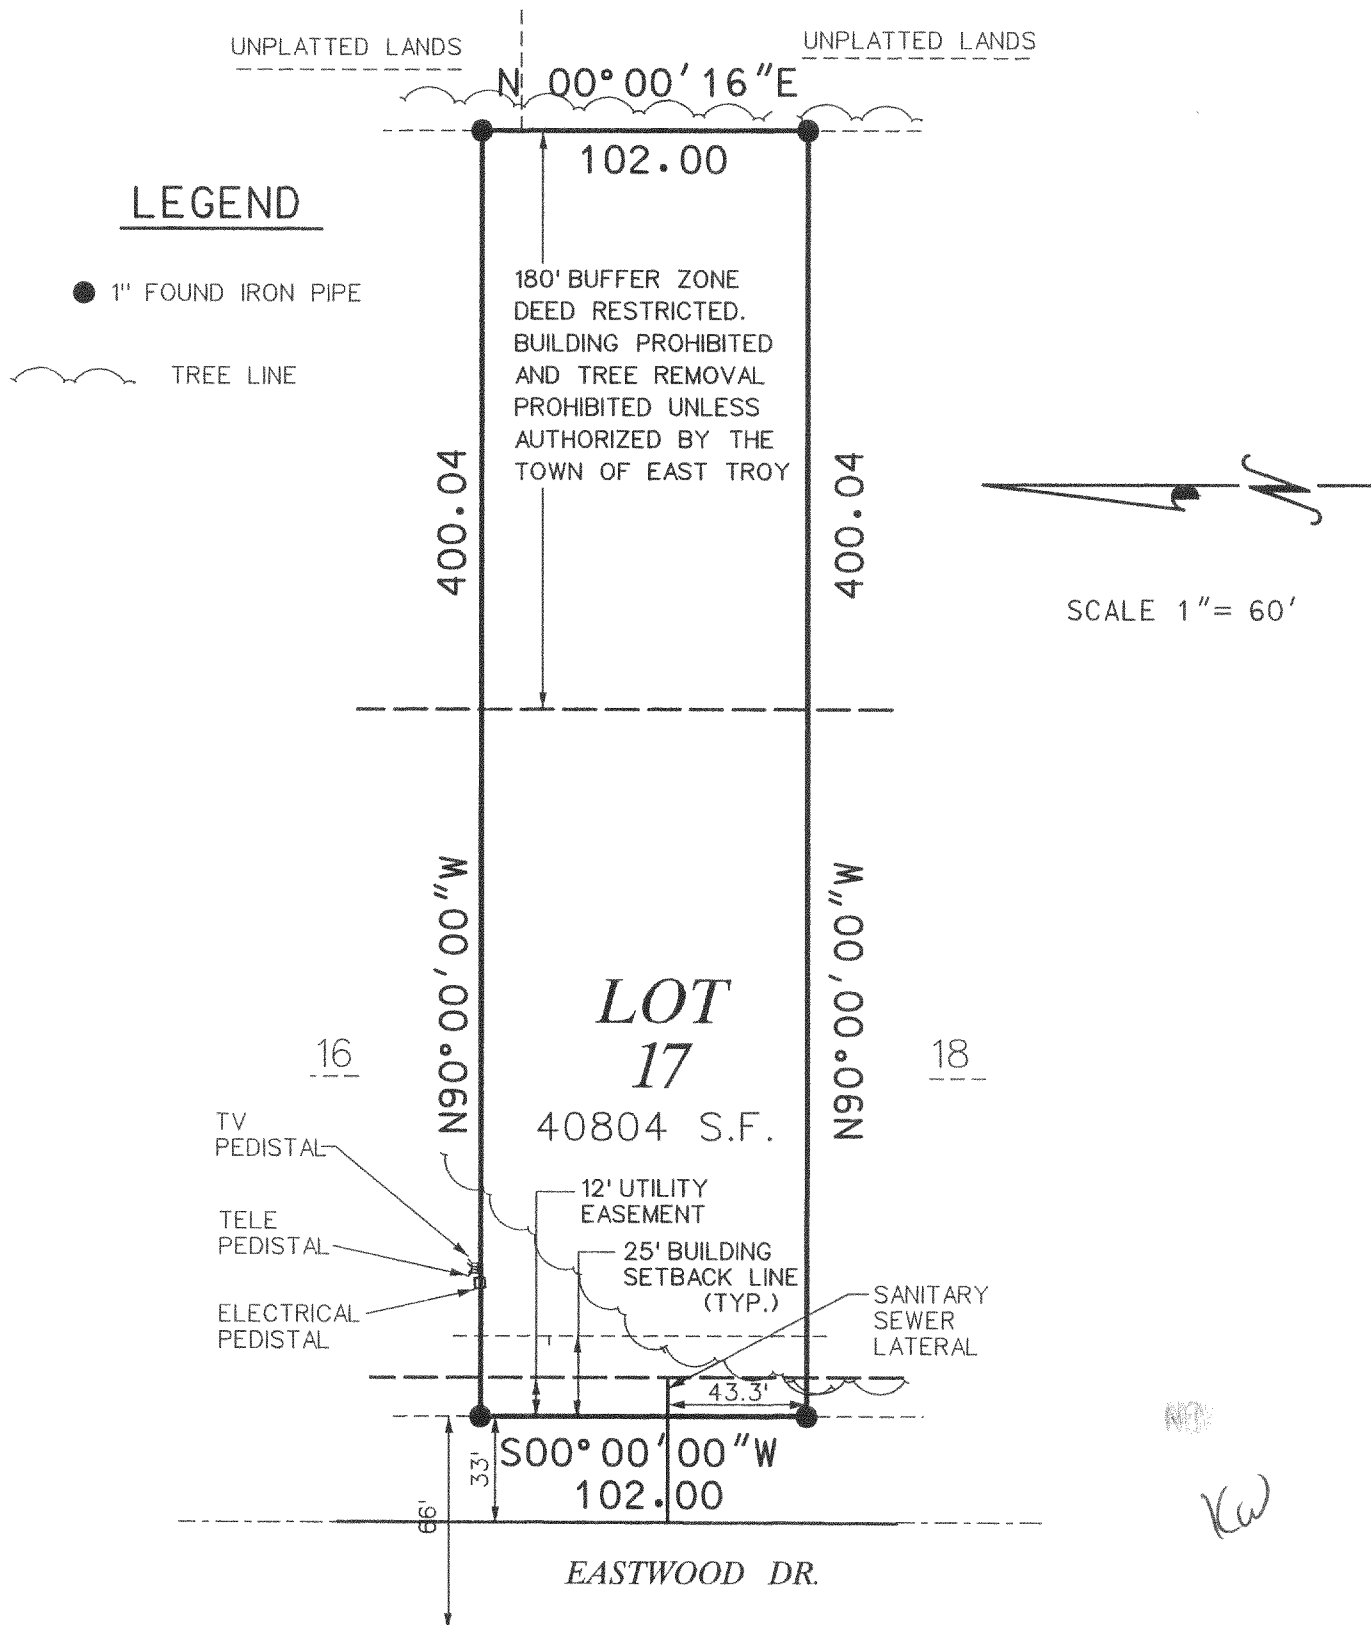

THE ABOVE MAP IS A TRUE REPRESENTATION THEREOF AND SHOWS THE SIZE AND LOCATION OF ALL THE PROPERTY, EXTERIOR BOUNDARIES, THE LOCATION OF ALL VISIBLE BOUNDARY FENCES, APPARENT EASEMENTS, ROADWAYS AND VISIBLE ENCROACHMENTS, IF ANY.

THIS SURVEY IS MADE FOR THE USE OF THE PRESENT OWNERS OF THE PROPERTY, AND ALSO THOSE WHO PURCHASE, MORTGAGE OR GUARANTEE TITLE THERETO WITHIN ONE (1) YEAR FROM DATE HERETO.

*Paul H. Van Henkelum* 7/14/03  
PAUL H. VAN HENKELUM R.L.S. 1931  
RSV#03232LOT17.DGN

