

PLAT OF SURVEY  
PROPOSED REZONE

J.K. SURVEYING INC.  
N3705 WILLOWBEND LANE  
LAKE GENEVA, WI, 53147  
262-248-3697

PREPARED FOR :

LARRY AND GRACE PAYNE  
W1532 HONEY CREEK ROAD  
EAST TROY, WI, 53120

- OF -

PARCEL " A " OF WALWORTH COUNTY CERTIFIED SURVEY MAP NO. 766,  
ACCORDING TO THE PLAT THEREOF RECORDED MARCH 14TH, 1978,  
IN VOLUME 3 OF CERTIFIED SURVEYS ON PAGES 292-293, AS DOCUMENT  
No. 30063 BEING A PART OF THE NW 1\4 OF SECTION 33, TOWN 4 NORTH,  
RANGE 18 EAST, TOWN OF EAST TROY, WALWORTH COUNTY,  
WISCONSIN.

5.00 acres  
CURRENTLY ZONED A-5  
PROPOSED ZONING A-4



( ) = recorded as

○ = iron pipe  
found

● = iron pipe  
set

SCALE 1" = 40'

JOB # 03-651


TAX ID # PA 76600001

COMPARE LEGAL DESCRIPTION ABOVE AND DRAWING WITH DEED. FOR BUILDING RESTRICTIONS AND  
EASEMENTS NOT SHOWN REFER TO DEED, ABSTRACT SOURCES AND LOCAL MUNICIPAL CODES. NOTIFY  
THE SURVEYOR IMMEDIATELY OF ANY DISCREPANCY.

"I hereby certify that I have surveyed the above described property and that  
the above map is a true representation thereof and shows the size and  
location of all visible structures, apparent easements and encroachments  
if any."

This survey is made for the present owners of the property, and those who  
purchase, mortgage, or guarantee the title thereto, within one year from  
the date hereof.

DATED THIS 8 TH, DAY OF OCTOBER 20 03

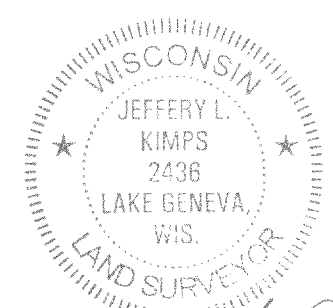

JEFFERY L. KIMPS S-2436  
Wisconsin Registered Land Surveyor  
(original if signed in red)

418-1757