


BROOKFIELD, WISCONSIN

Note: Relative elevations are indicated by underlined figures.

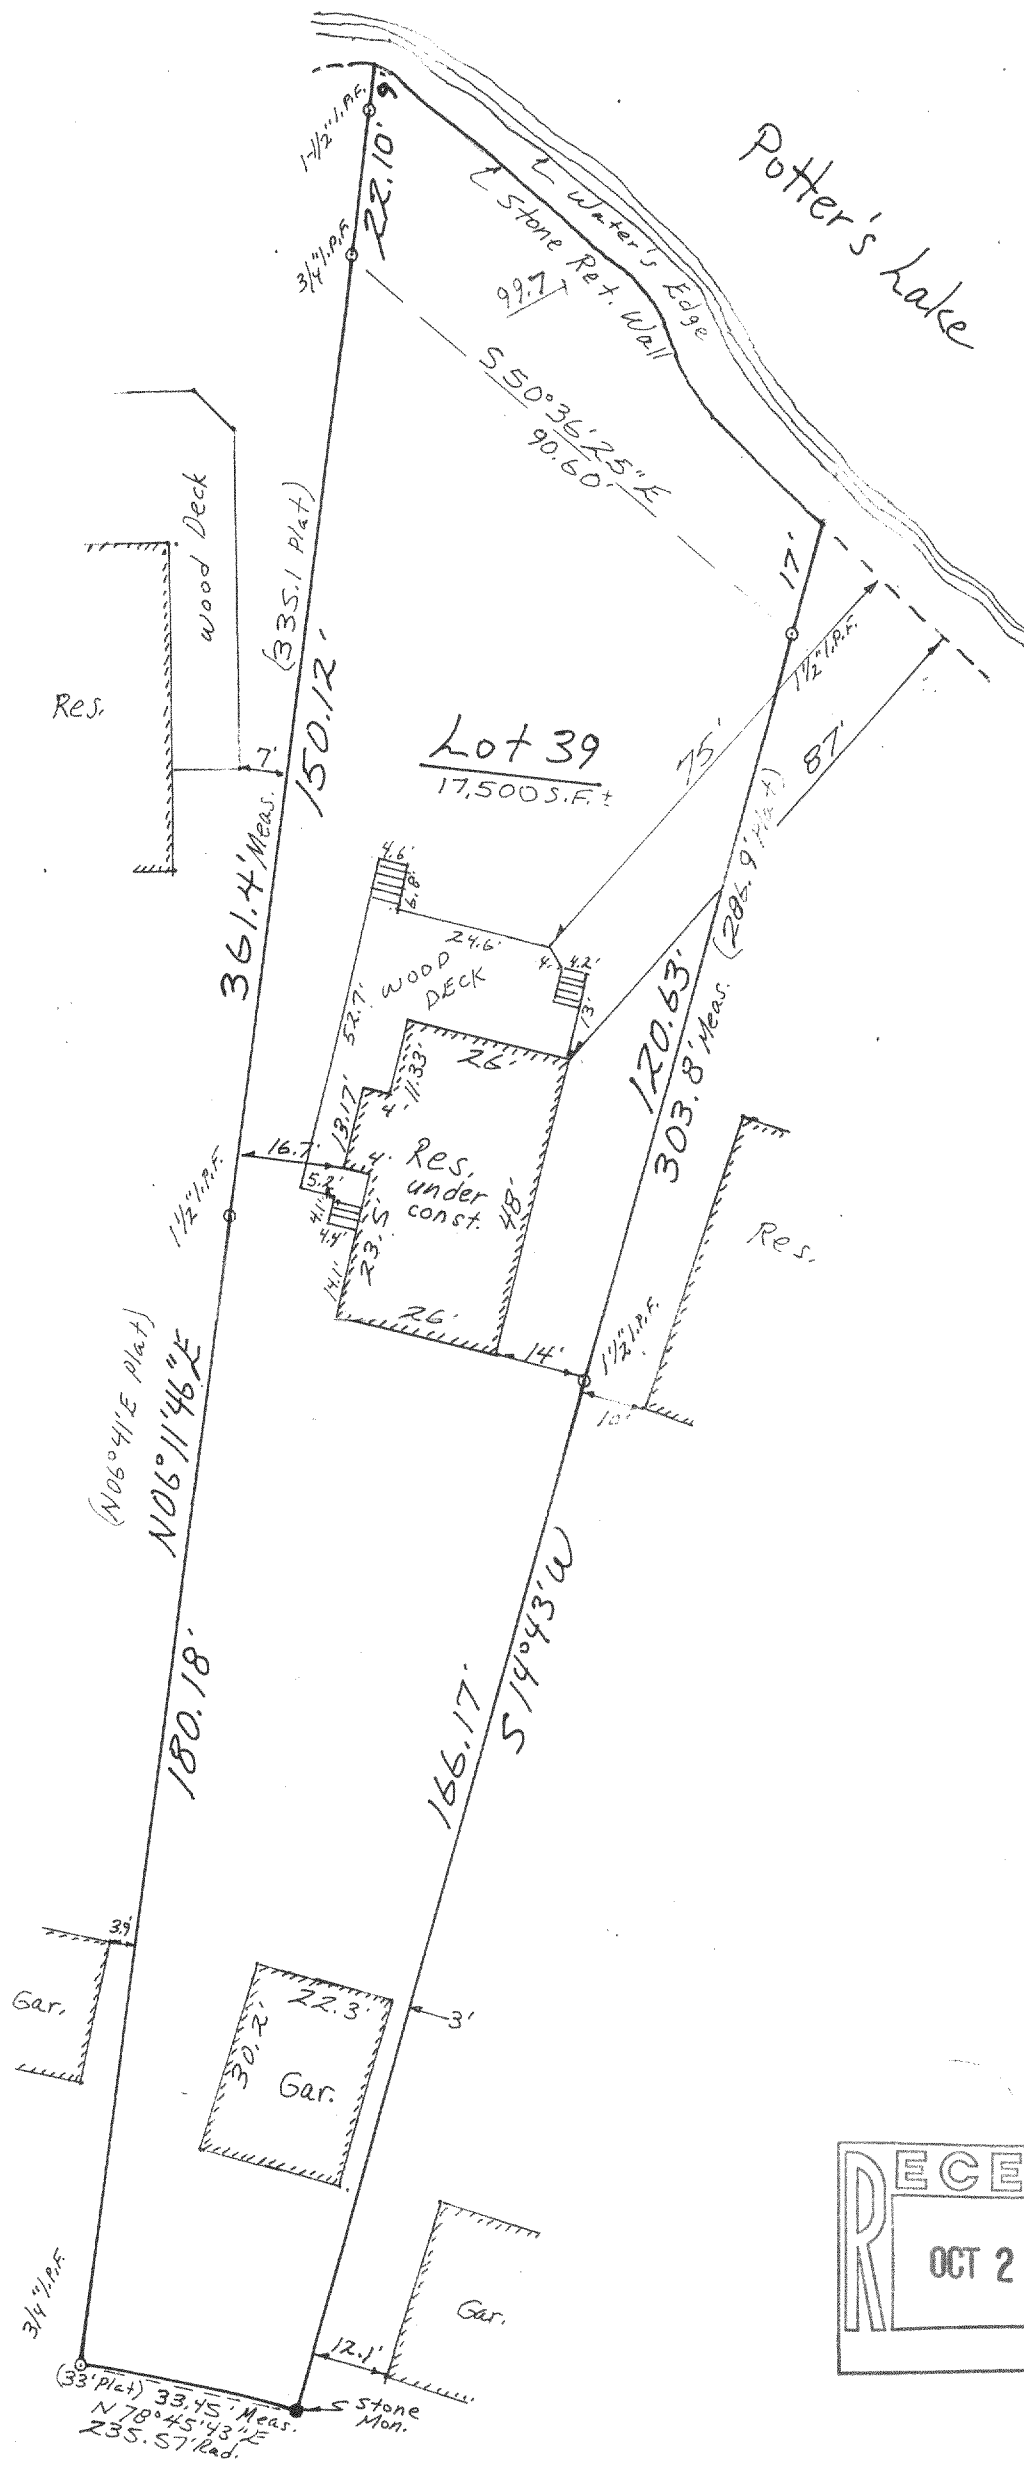

Revised to show
wood deck 10/7/04

THIS SURVEY IS MADE FOR THE EXCLUSIVE USE OF THE PRESENT OWNERS OF THE PROPERTY, AND ALSO THOSE WHO PURCHASE, MORTGAGE, OR GUARANTEE THE TITLE THERETO WITHIN ONE (1) YEAR FROM DATE HEREOF. *And resurveyed 2/11/04. E.G.H.*

REGISTERED WISCONSIN LAND SURVEYOR NO. 1000

RECEIVED
OCT 21 2004

DS-39