

PLAT OF SURVEY


-OF-

LOT 1 OF CERTIFIED SURVEY MAP NO. 3683,
BEING PART OF THE NORTHWEST 1/4 OF THE
NORTHEAST 1/4 OF SECTION 34, TOWNSHIP 4
NORTH, RANGE 18 EAST OF THE FOURTH
PRINCIPAL MERIDIAN, IN THE TOWNSHIP OF
EAST TROY, WALWORTH COUNTY, WISCONSIN.

SURVEY FOR: KERKMAN BROTHERS
CONSTRUCTION
PROPOSED TOP OF FOUNDATION: _____


I HEREBY CERTIFY THAT THE EXISTING FOUNDATION
AS SHOWN ON THIS PLAT OF SURVEY IS LOCATED AS
SHOWN THUS (). DATED THIS 13TH DAY OF
OCTOBER, 2004.

Robert J. Wetzel
ROBERT J. WETZEL S-1778

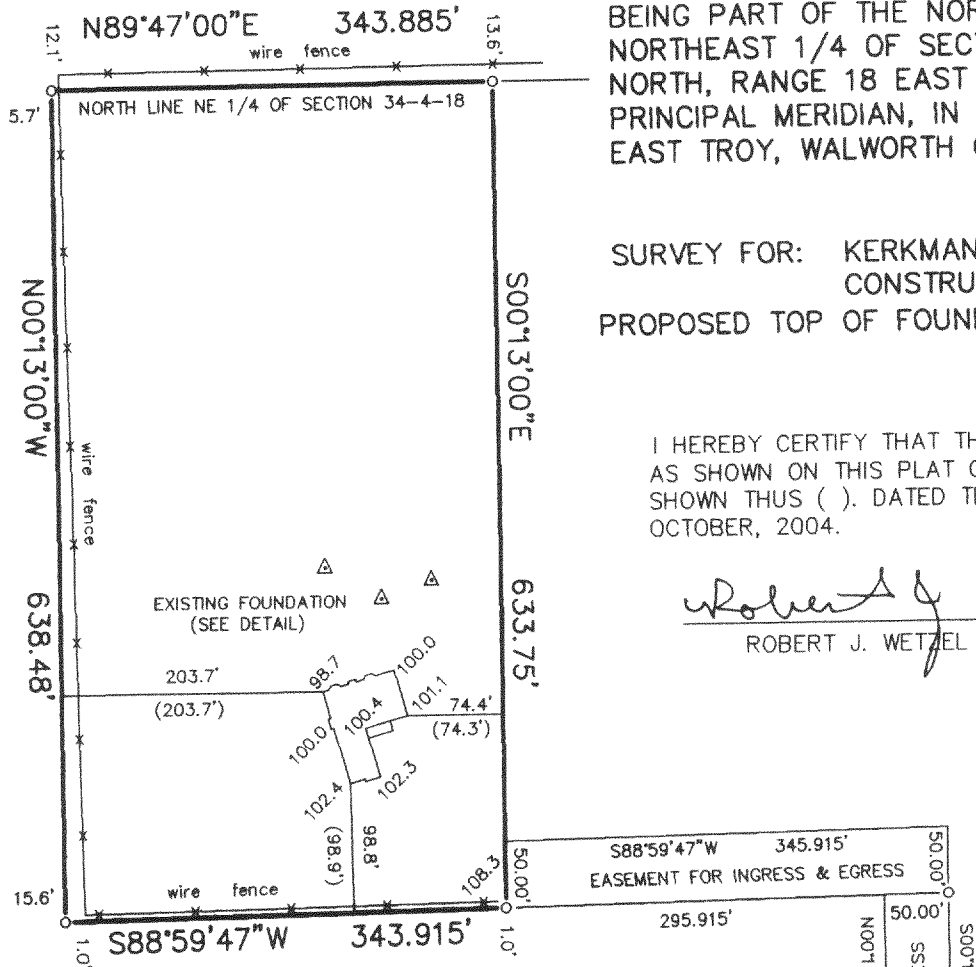

DETAIL

SCALE: 1" = 30'

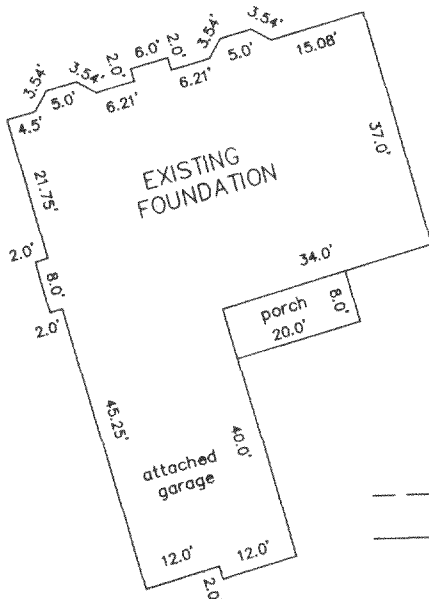

SCALE: 1" = 150'


LEGEND

- FOUND IRON PIPE
- △ SOIL BORING PER C.S.M.
- 100.0 EXISTING ELEVATION


HONEY CREEK ROAD
66' WIDE

"I hereby certify that I have surveyed the above described property and that the above map is a correct representation thereof and shows the size and location of the property, its exterior boundaries, the location of all visible structures and dimensions of all principal buildings thereon, boundary fences, apparent easements, roadways and encroachments, if any."

"This survey is made for the use of the present owners of the property, and those who purchase, mortgage, or guarantee the title thereto within one year from date hereof."

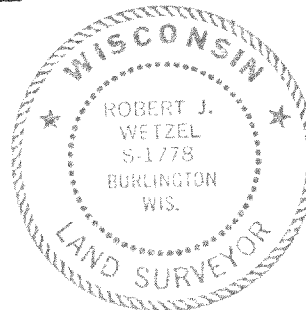

THIS IS NOT AN ORIGINAL PRINT
UNLESS THIS SEAL IS RED.

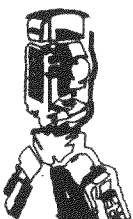

B.W. SURVEYING, INC.

412 N. PINE STREET
BURLINGTON, WI 53105
(262)-767-0225

Robert J. Wetzel
ROBERT J. WETZEL S-1778

AUGUST 26, 2004
DATE

6520
JOB NUMBER

PA368300001

418-1803