

# PLAT OF SURVEY




Engineers • Land Surveyors • Environmental Scientists  
801 MAIN STREET MUKWONAGO, WISCONSIN 53149 (262) 363-2004

RECERTIFICATION: 03/15/2005  
DATE: 11/05/2004

FOR: DEBORAH & ROBERT F. JANSEN

DESCRIPTION: BEING A PARCEL OF LAND LOCATED IN THE NW<sup>1</sup>/<sub>4</sub> OF SECTION 4, TOWN 4 NORTH, RANGE 18 EAST, TOWN OF EAST TROY, WALWORTH COUNTY, WISCONSIN. BEING A PARCEL OF LAND LOCATED IN PART OF SECTION 4, TOWN 4 NORTH, RANGE 18 EAST, TOWN OF EAST TROY, WALWORTH COUNTY, WISCONSIN. BEING MORE COMPLETELY DESCRIBED AS FOLLOWS: COMMENCING AT THE NW CORNER OF TAX KEY #WP-3A SAID POINT BEING THE POINT OF BEGINNING; THENCE S87°45'00"W, A DISTANCE OF 12.96' TO A POINT; THENCE S11°09'22"W, A DISTANCE OF 265.35' TO A POINT ON THE MEANDER LINE, OF MILL LAKE; THENCE S73°22'05"E ALONG SAID MEANDER LINE, A DISTANCE OF 12.67' TO A POINT; THENCE S68°33'45"E, A DISTANCE OF 87.94' TO A POINT; THENCE N00°44'31"W, A DISTANCE OF 61.66' TO POINT; THENCE N14°17'40"E, A DISTANCE OF 247.23' TO A POINT; THENCE S87°03'38"W, A DISTANCE OF 90.06' TO THE POINT OF BEGINNING. SAID PARCEL CONTAINS 0.61 ACRES MORE OR LESS. SAID PARCEL CONTAINS LAND BETWEEN THE MEANDER LINE AND THE ORDINARY HIGH WATER LINE OF MILL LAKE.

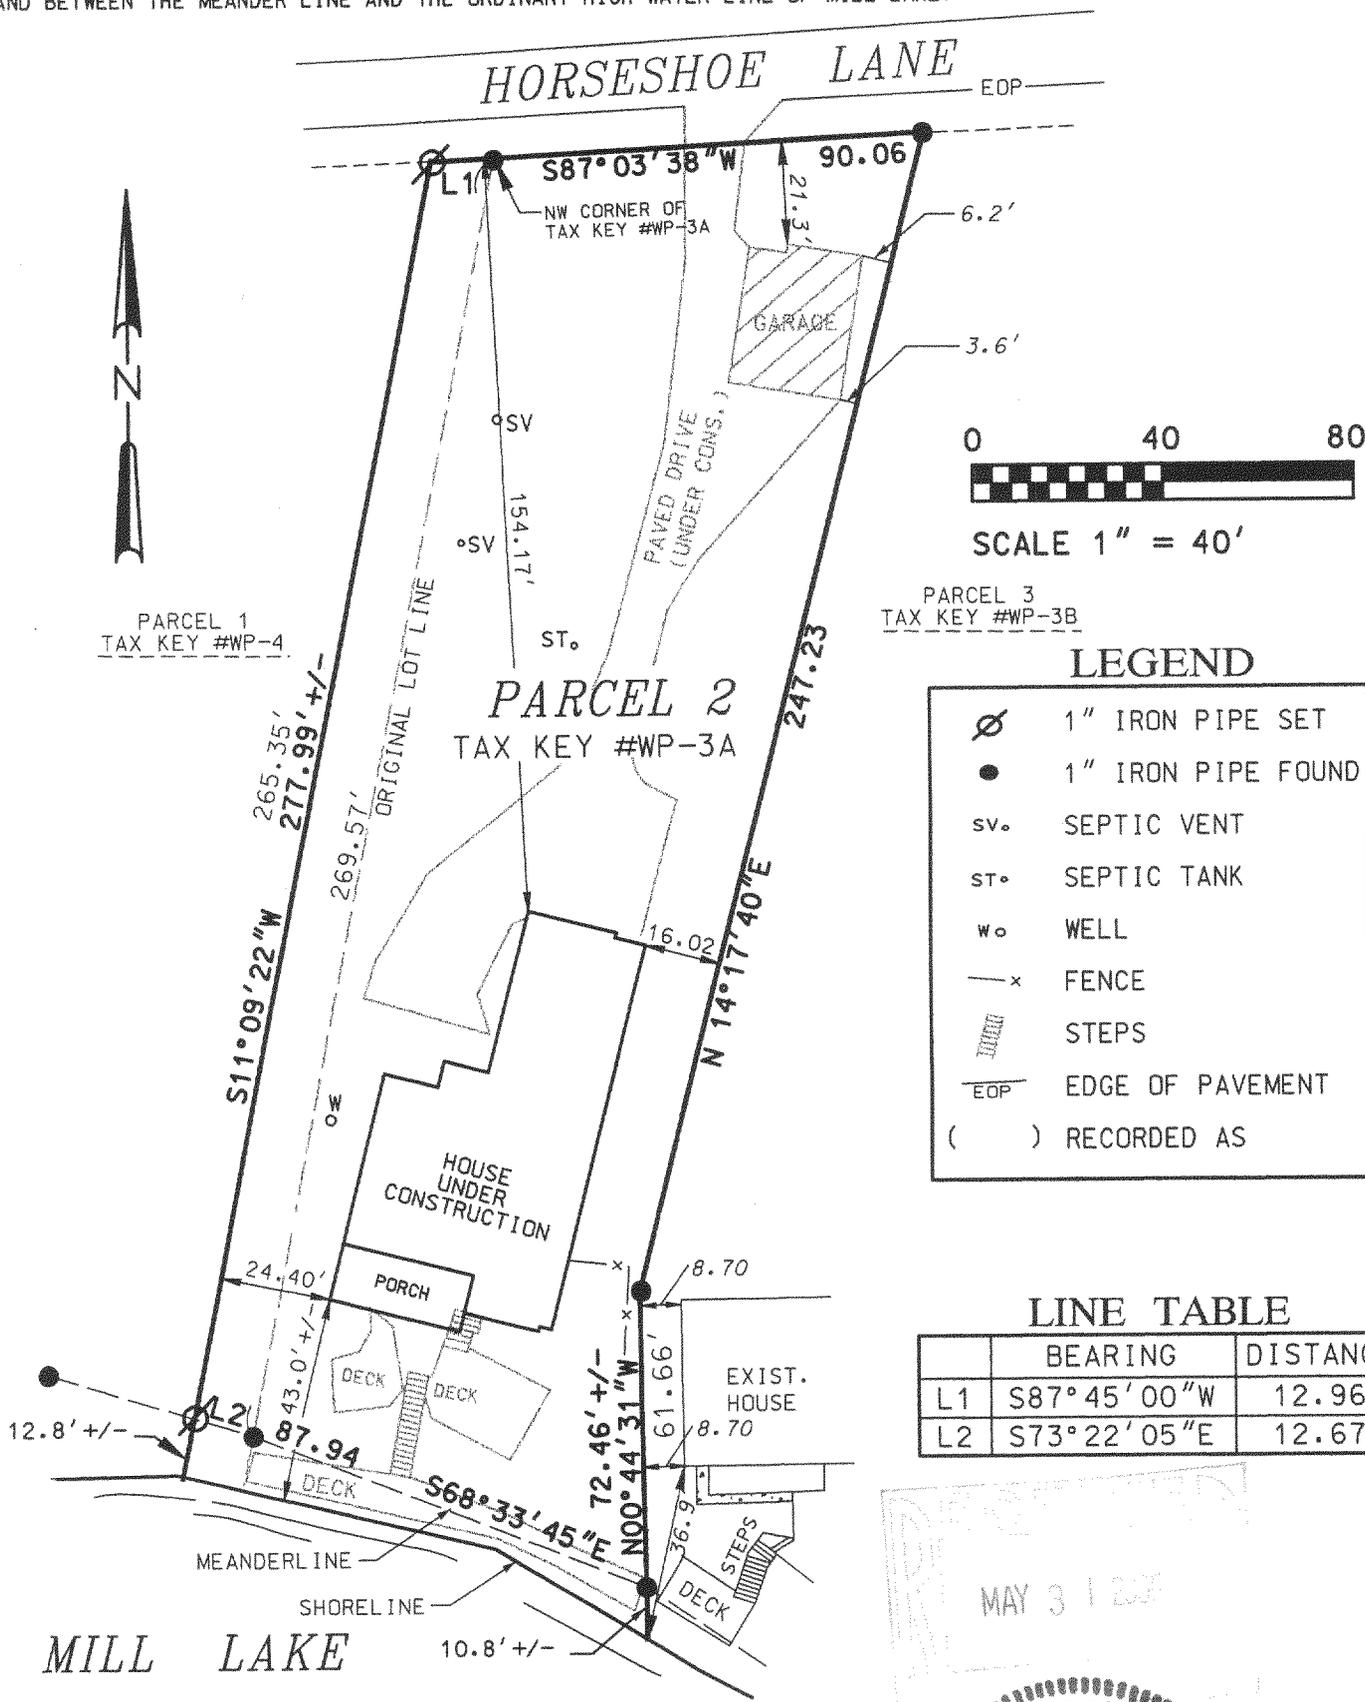


PARCEL 3  
TAX KEY #WP-3B

### LEGEND

- ⊘ 1" IRON PIPE SET
- 1" IRON PIPE FOUND
- SV. SEPTIC VENT
- ST. SEPTIC TANK
- W. WELL
- x- FENCE
- ▨ STEPS
- EOP- EDGE OF PAVEMENT
- ( ) RECORDED AS

### LINE TABLE

	BEARING	DISTANCE
L1	S87°45'00"W	12.96'
L2	S73°22'05"E	12.67'

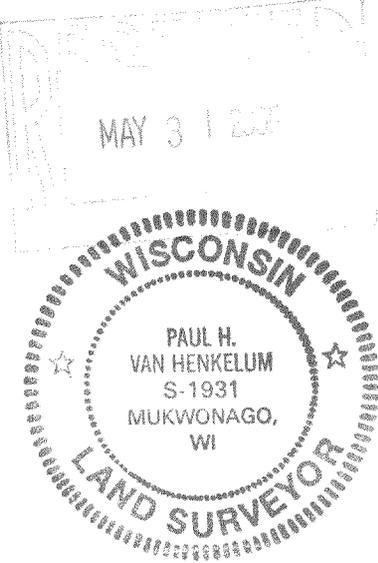

I PAUL H. VAN HENKELUM R.L.S. # 1931 HEREBY CERTIFY THAT THIS SURVEY WAS MADE IN ACCORDANCE WITH THE MINIMUM STANDARDS FOR PROPERTY SURVEYS (CHAPTER A-E7) STATE OF WISCONSIN AND HAS BEEN PREPARED UNDER MY DIRECTION AND CONTROL AND IS CORRECT TO THE BEST OF MY KNOWLEDGE AND BELIEF.

*Paul H. Van Henkelum* 3/14/05  
PAUL H. VAN HENKELUM, R.L.S. # 1931  
RSV DATA6/ 04surveys/01041/01041rec.dgn

PWP 0003A

4B-1837