

PLAT OF SURVEY


FOR: ZACK CLAYTON

DATE: 12/29/2003

DESCRIPTION: BEING PART OF LOTS 6 & 7 OF ROMADKA PARK SUBDIVISION, LOCATED IN SECTION 4, TOWN 4 NORTH RANGE 18 EAST, WALWORTH COUNTY, WISCONSIN. DESCRIBED AS FOLLOWS: BEGINNING AT A POINT 22.11' N60°51'00"W OF THE ORIGINAL NW CORNER OF LOT 7; THENCE CONTINUING N60°51'00"W, A DISTANCE OF 44.36' TO A FOUND CONCRETE MONUMENT; THENCE S06°10'30"E, A DISTANCE OF 380.39' TO A MEANDER POINT ON THE SHORE OF LAKE BEULAH; THENCE ALONG SAID MEANDER LINE N71°54'11"E, A DISTANCE OF 49.98' TO A POINT; THENCE N60°01'30"E, A DISTANCE OF 51.55' TO A POINT; THENCE N16°39'30"W, A DISTANCE OF 329.11' TO THE POINT OF BEGINNING.



I PAUL H. VAN HENKELUM R.L.S. # 1931 HEREBY CERTIFY THAT THIS SURVEY WAS MADE IN ACCORDANCE WITH THE MINIMUM STANDARDS FOR PROPERTY SURVEYS (CHAPTER A-E7) STATE OF WISCONSIN AND HAS BEEN PREPARED UNDER MY DIRECTION AND CONTROL AND IS CORRECT TO THE BEST OF MY KNOWLEDGE AND BELIEF.

Paul H. Van Henkelum
 PAUL H. VAN HENKELUM R.L.S. #1931
 RSVDATA6/BRADTDS03/J03427.PRO

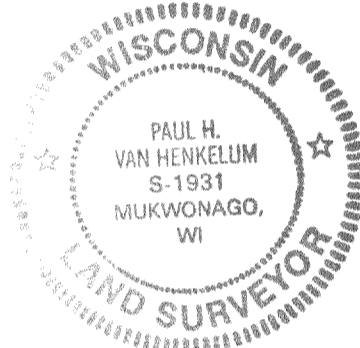

NOTE: THE R.O.W. LINE OF LAKE ROAD WAS TAKEN TO BEAR N60°51'00"W

SCALE 1"=30'

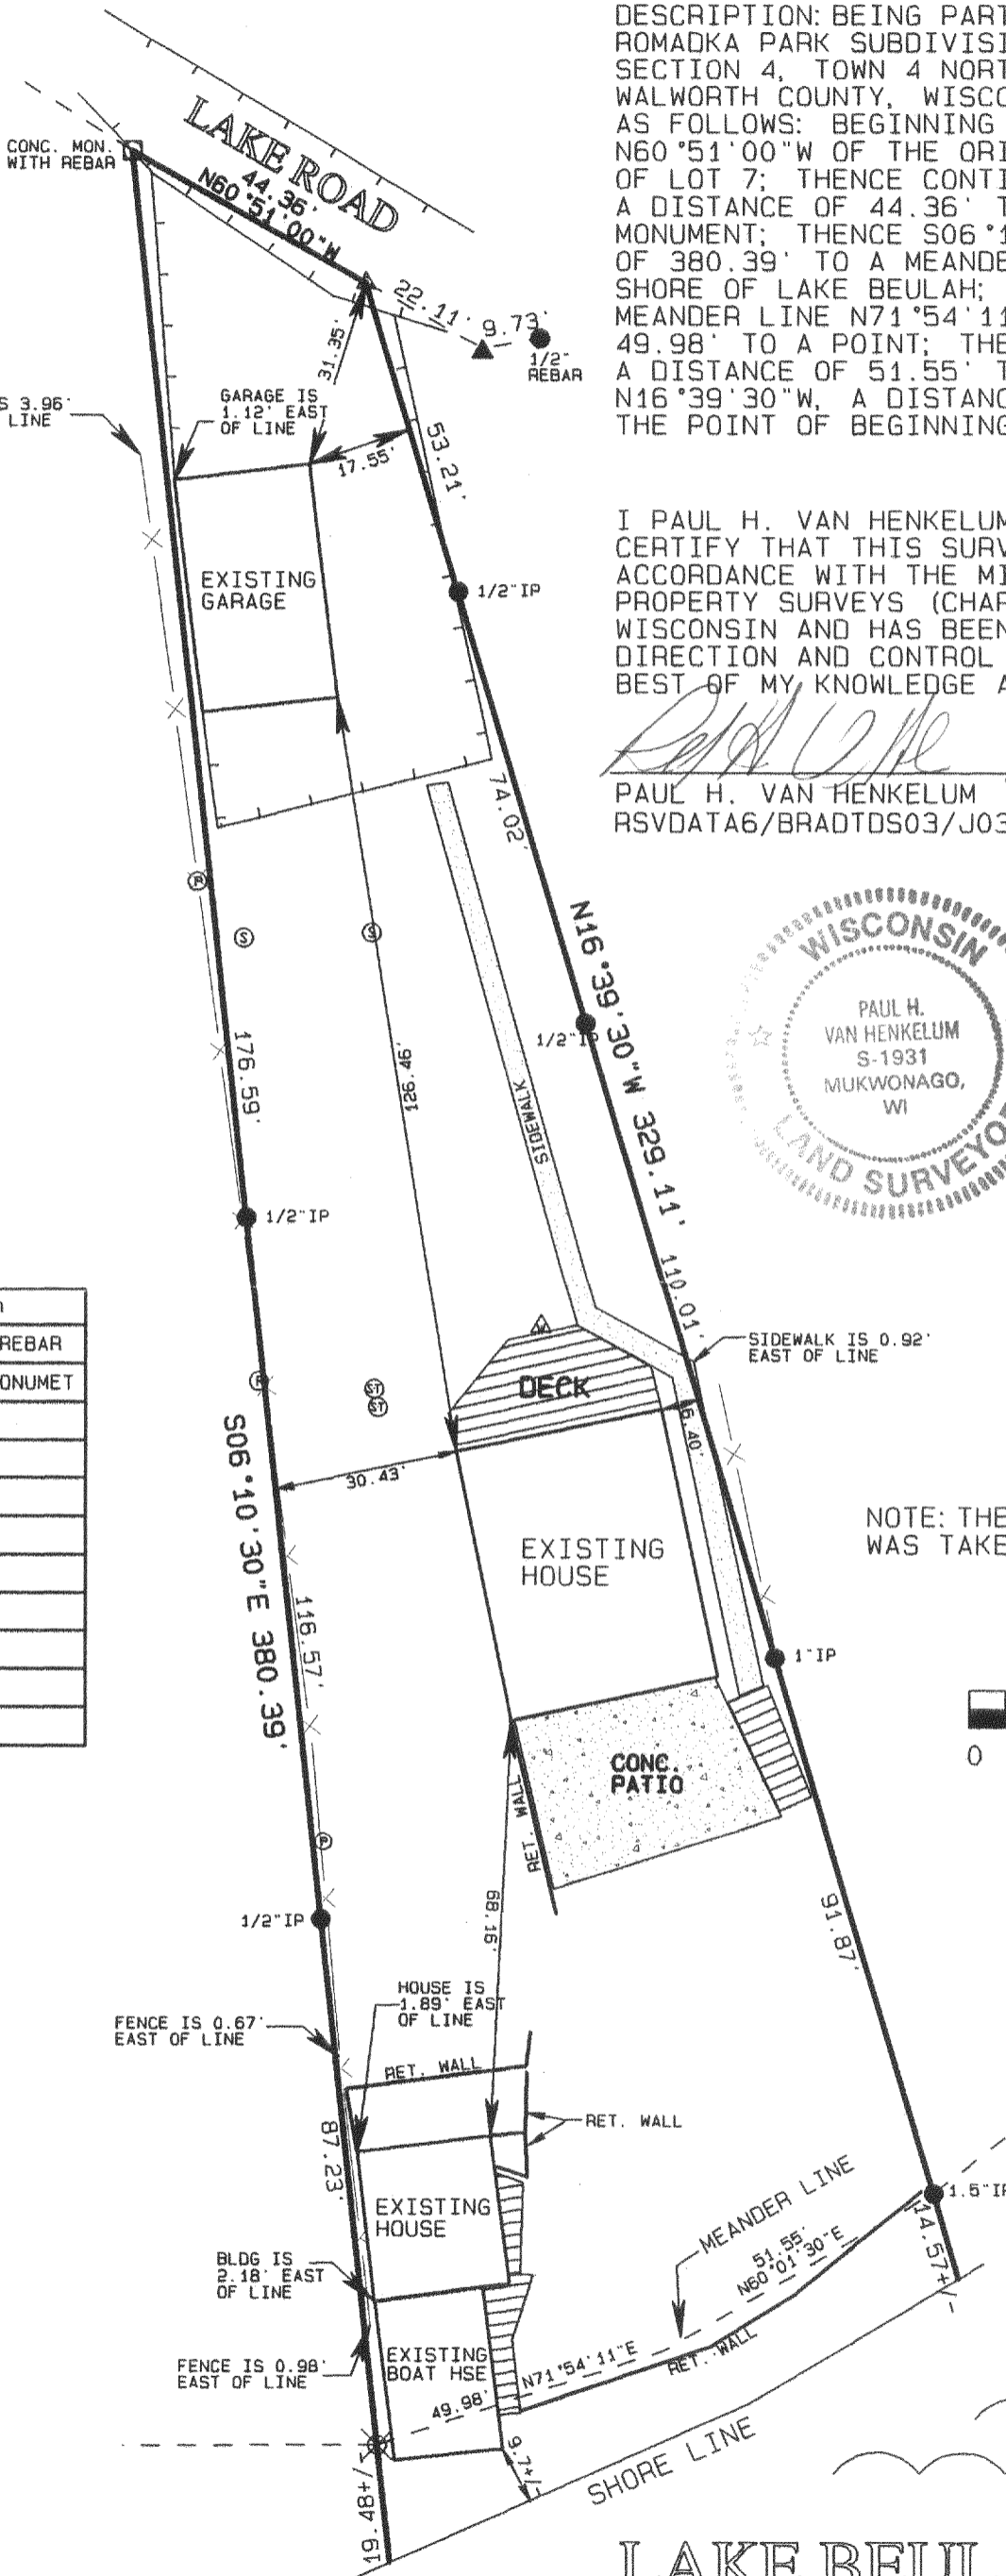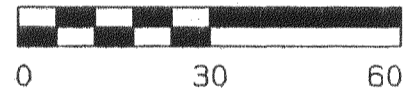

LEGEND

Symbol	Description
●	FOUND IRON PIPE/REBAR
□	FOUND CONCRETE MONUMET
▲	SET PK NAIL
⊗	SET 1" IRON PIPE
▲	FOUND PK NAIL
⊙	SEPTIC VENT
▲	WELL
⊙	POWER POLE
⊙	SEPTIC TANK
—	EDGE OF PAVEMENT
—X—	FENCE (X) LINE

RECEIVED
 MAY 3 2004