

# LAND-MARK SURVEYING


Mark L. Miritz

Wisconsin Registered Land Surveyor S-2582


N9330 Knuteson Drive  
Whitewater, WI 53190  
Phone: (262) 495-3284  
FAX : (262) 495-8421  
LAND-MARKSURVEYING.COM

## PLAT OF SURVEY

**LOT 15 OF BLOCK 19 OF MIRAMAR ADDITION  
NO. 1, LOCATED IN THE NE 1/4 OF SECTION  
10, TOWN 4 NORTH, RANGE 18 EAST, TOWN  
OF EAST TROY, WALWORTH COUNTY, WISCONSIN**

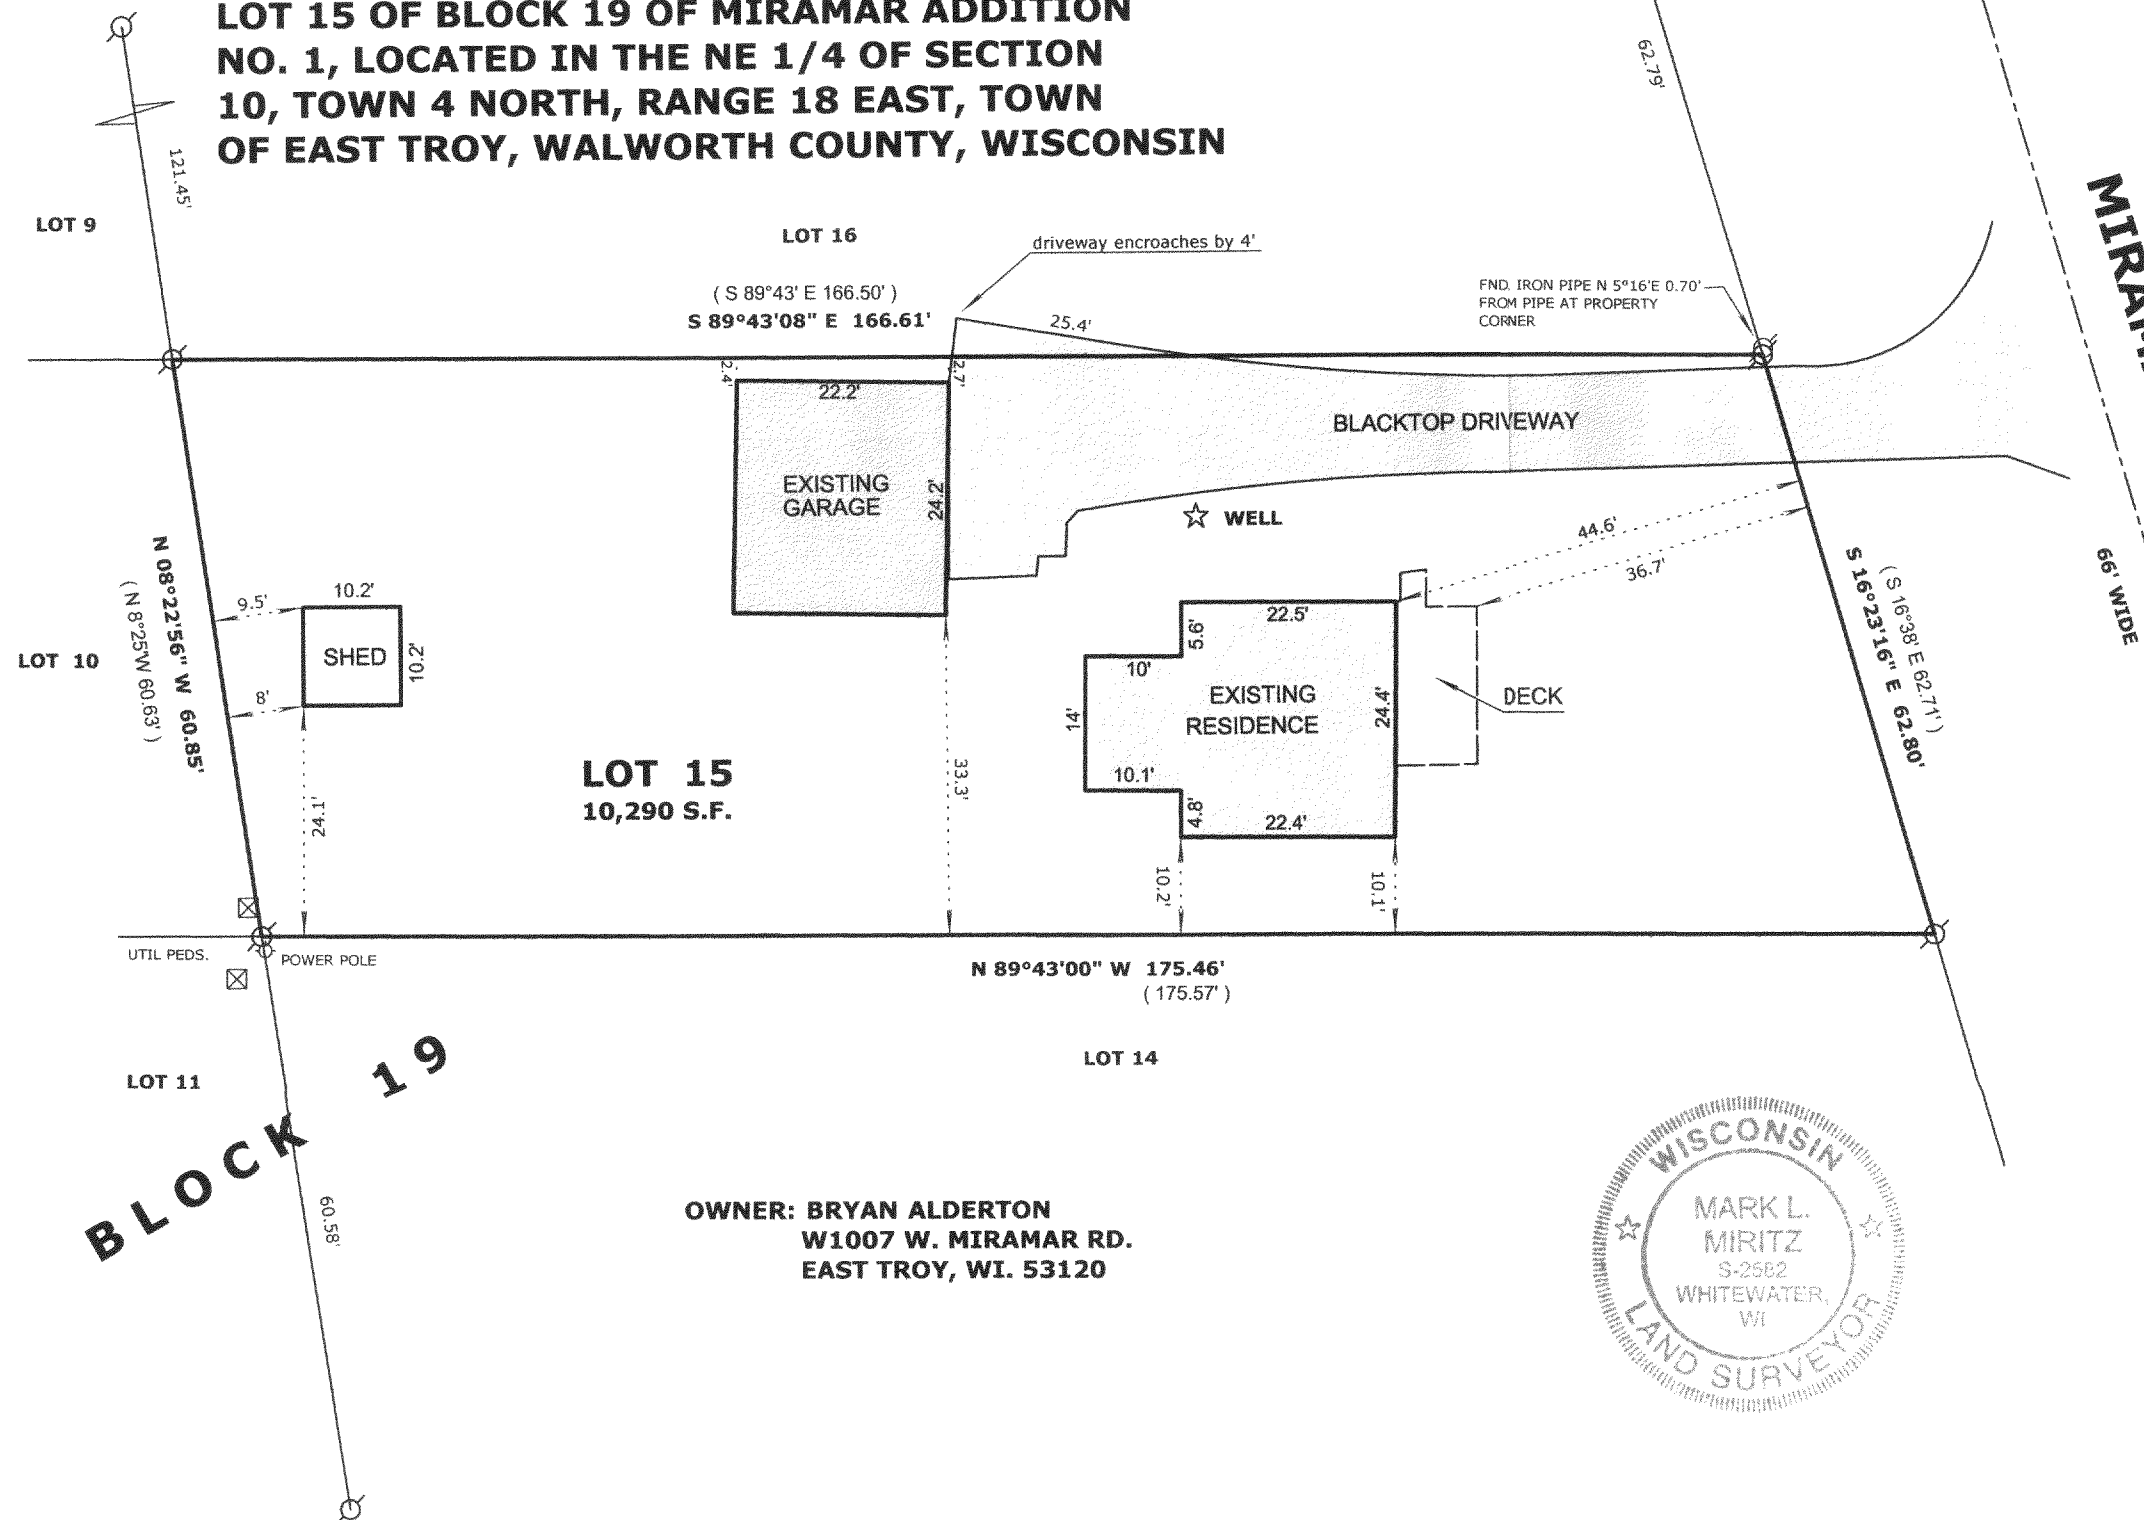

**OWNER: BRYAN ALDERTON  
W1007 W. MIRAMAR RD.  
EAST TROY, WI. 53120**

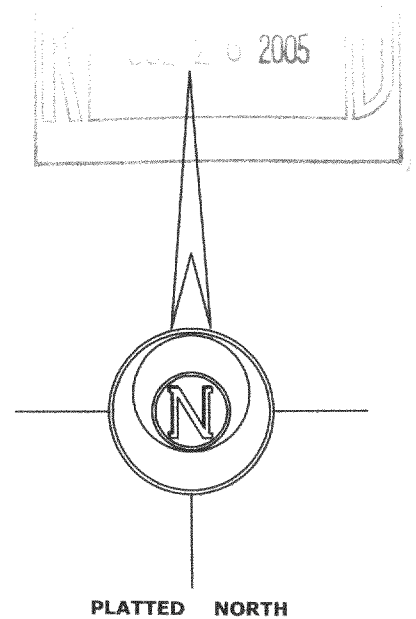

## LEGEND

- FOUND IRON PIPE
- FOUND IRON ROD
- FOUND COUNTY MONUMENT
- FOUND CONCRETE MONUMENT
- CHISEL CUT IN CONCRETE
- SET IRON ROD, 24" LONG, WEIGHING 1.5 LBS./LINEAL FT., 3/4" DIA.
- RECORDED AS DIMENSION
- EXISTING FENCE

SCALE: 1" = 20 FEET

"I hereby certify that the above described property has been surveyed by me or under my direction and that the above map is a true representation thereof and shows the size and location of the property, its exterior boundaries, the location of all visible structures and dimensions of all principal buildings thereon, boundary fences, apparent easements, roadways and visible encroachments, if any."

"This survey is made for the use of the present owners of the property, and also those who purchase, mortgage, or guarantee the title thereto within one year from date hereof."

*Mark L. Miritz*  
**MARK L. MIRITZ**  
WISCONSIN REGISTERED  
LAND SURVEYOR S-2582

DATE: May 11, 2005 JOB NO. 05.504

418-1859

PM 0001