

BUILDING SURVEYS
PERCOLATION TESTS
SOIL BORING TESTS

910 ELM GROVE RD.
ELM GROVE, WISCONSIN 53122

PHONE: 782-8690

78-344-3

PREPARED FOR:

Floyd Surridge

LOCATION

Wilmer Grove Road (Town of East Troy)

DESCRIPTION OF PROPERTY


Lot 11, Block 1 - WILMER GROVE BEACH, in Town 4 North, Range 18 East, Town of East Troy, Walworth County, Wisconsin.

RACINE COUNTY SURVEYOR

FILE NO 13135

RECEIVED JUN 18 1981

BY THE CLERK
DEPUTY FOR RECORDS

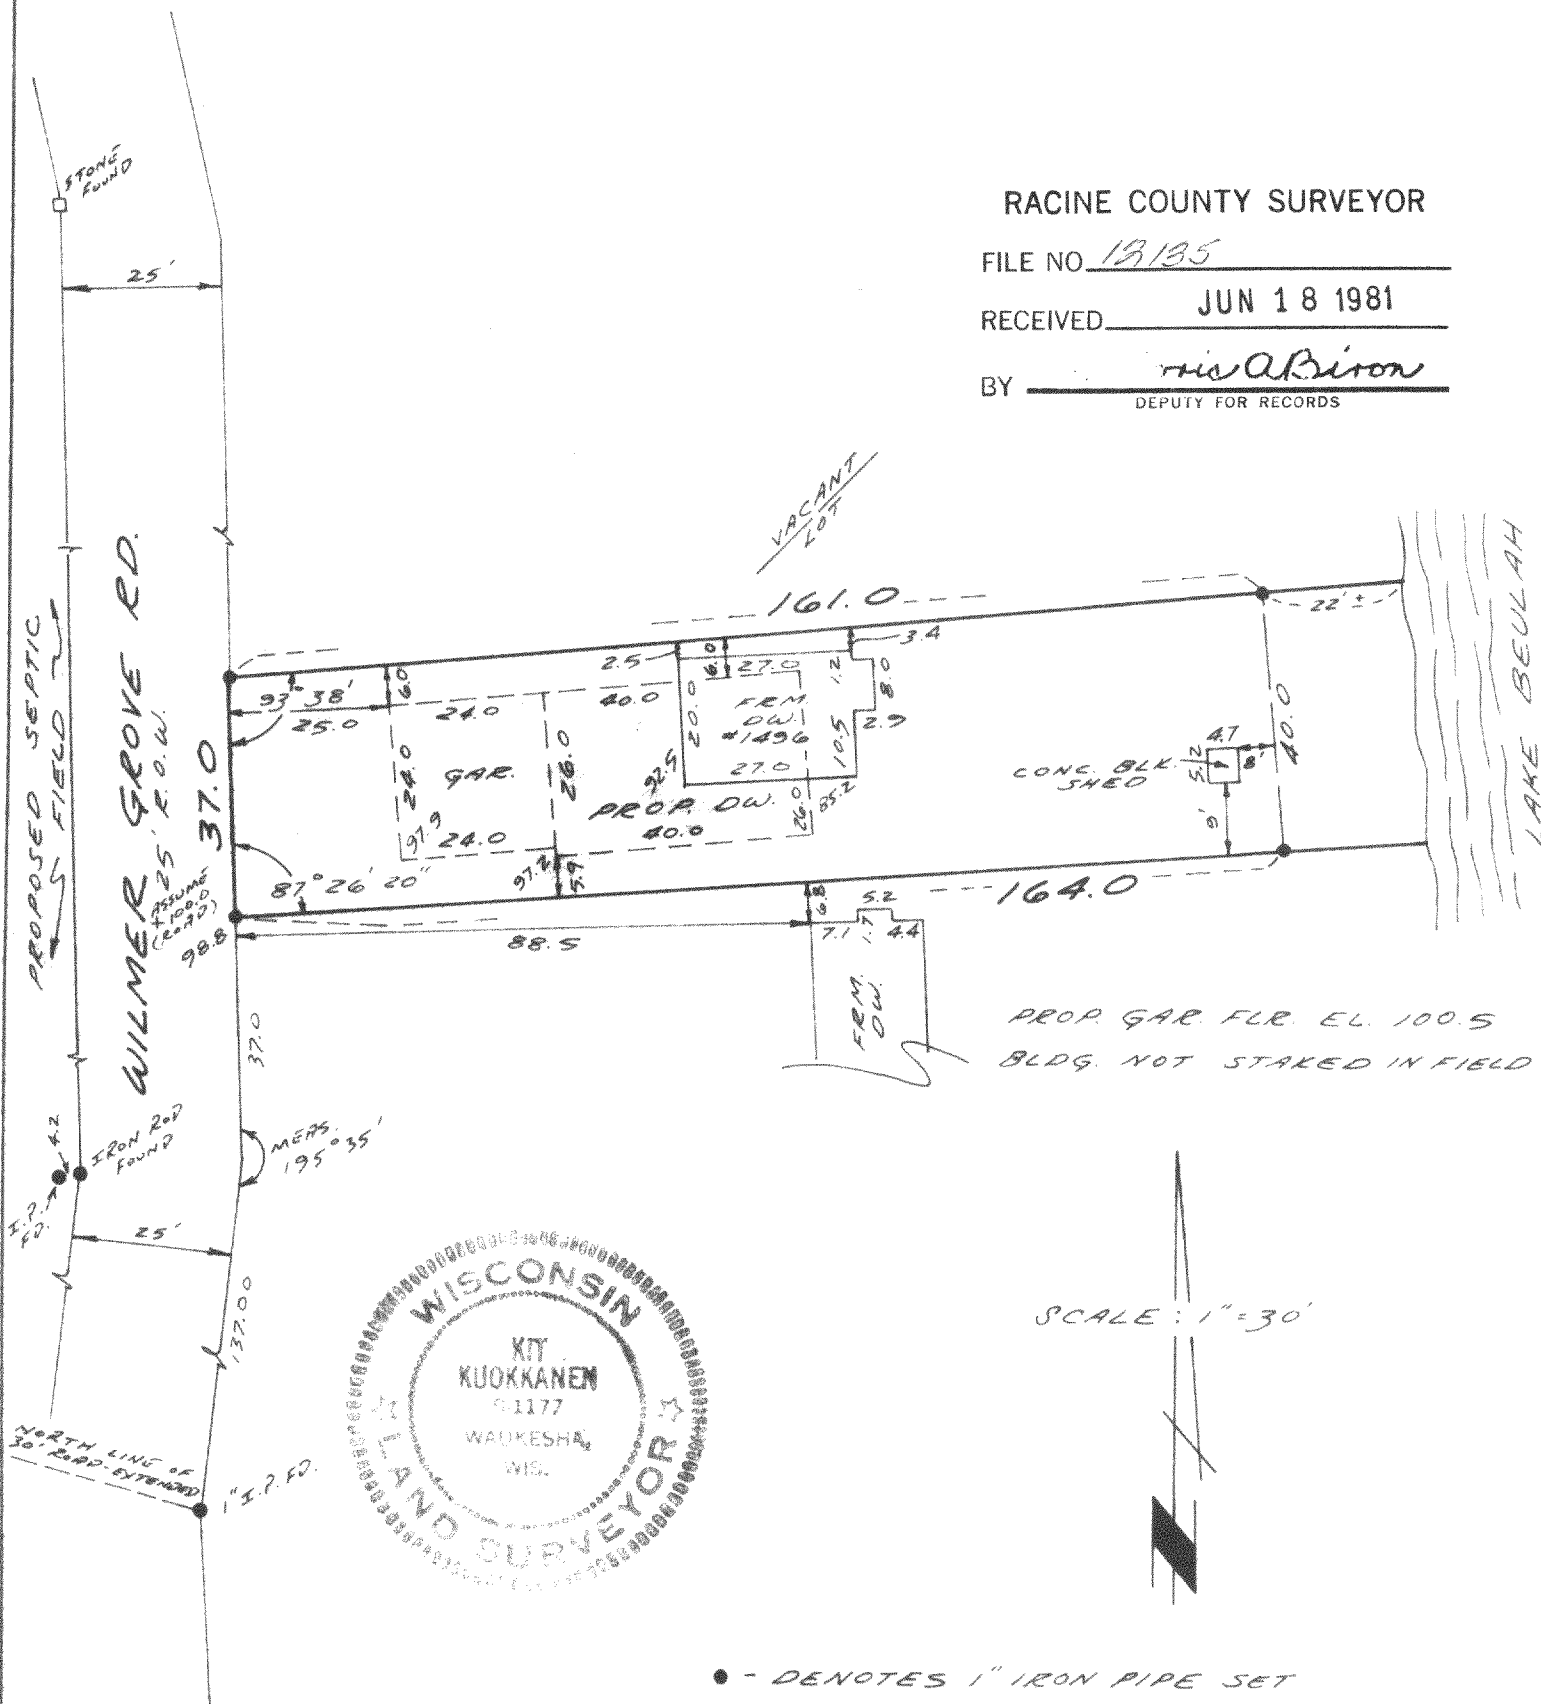

● - DENOTES 1" IRON PIPE SET

SURVEY CERTIFICATE

I HAVE SURVEYED THE ABOVE-DESCRIBED PROPERTY AND THE ABOVE MAP IS A TRUE REPRESENTATION THEREOF AND SHOWS THE SIZE AND LOCATION OF THE PROPERTY, ITS EXTERIOR BOUNDARIES, THE LOCATION AND DIMENSIONS OF ALL VISIBLE STRUCTURES THEREON, FENCES, APPARENT EASEMENTS AND ROADWAYS AND VISIBLE ENCROACHMENTS, IF ANY.

THIS SURVEY IS MADE FOR THE EXCLUSIVE USE OF THE PRESENT OWNERS OF THE PROPERTY, AND ALSO THOSE WHO PURCHASE, MORTGAGE, OR GUARANTEE THE TITLE THERETO WITHIN ONE (1) YEAR FROM DATE HEREOF.

Dated at

this 7th day of NOVEMBER, 1978

REVISED 7-13-79

PWW 00016A

Surveyor

418-864