

# PLAT OF SURVEY

**RSV**

ENGINEERING, INC.

Engineers Land Surveyors Environmental Scientists  
801 MAIN STREET MUKWONAGO, WISCONSIN 53149 (262)363-2004

FOR: BILL THORRINGTON

DATE: 11/10/2005

DESCRIPTION: BEING PART OF THE NW1/4 & SW1/4 OF SECTION 16, TOWN 4 NORTH, RANGE 18 EAST, TOWN OF EAST TROY WALWORTH COUNTY, WISCONSIN. BEING FURTHER DESCRIBED AS FOLLOWS: COMMENCING AT THE SW CORNER OF SAID SECTION 16; THENCE N00°00'00"E, 2021.70'; THENCE S88°15'00"E, 1594.00'; THENCE N02°25'00"E, 223.30'; THENCE S88°39'00"E, 72.70'; THENCE N23°25'00"E, 192.00'; THENCE N65°25'00"E, 45.90' TO THE POINT OF BEGINNING; THENCE N10°57'23"E, 294.68' TO A FOUND IRON PIPE SAID POINT BEING ON A MEANDER LINE ALONG THE SOUTH SHORE OF ARMY LAKE; THENCE ALONG SAID MEANDER LINE, N80°37'36"E, 38.76' TO A FOUND IRON PIPE; THENCE N80°31'56"E, 64.19' TO A FOUND IRON PIPE; THENCE N80°52'24"E, 5.12' TO A FOUND IRON PIPE; THENCE S10°54'12"W, 259.76' TO THE CENTERLINE OF SAWYER LANE; THENCE ALONG SAID CENTERLINE S65°25'00"W, 124.80' TO THE POINT OF BEGINNING.

MEANDER LINE TABLE

L1	N80°37'36"E	38.76'
L2	N80°52'24"E	5.12'

## LEGEND

- FOUND IRON PIPE
- MONUMENT
- ▲ PK NAIL SET
- △ WELL
- ⊙ SEPTIC TANK
- ⊙ SEPTIC VENT
- TELEPHONE PEDISTAL
- ⊙ CABLE BOX
- x — FENCE LINE


TAX KEY  
# PO 00010

TAX KEY  
# PO 00012A

TAX KEY  
# PO 00009


TAX KEY  
# PO 00008

0' 50' 100'  
SCALE 1" = 50'

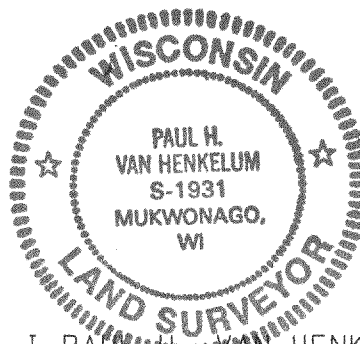

I PAUL H. VAN HENKELUM R.L.S. # 1931 HEREBY CERTIFY THAT THIS SURVEY WAS MADE IN ACCORDANCE WITH THE MINIMUM STANDARDS FOR PROPERTY SURVEYS (CHAPTER A-E7) STATE OF WISCONSIN AND HAS BEEN PREPARED UNDER MY DIRECTION AND CONTROL AND IS CORRECT TO THE BEST OF MY KNOWLEDGE AND BELIEF.

PAUL H. VAN HENKELUM, R.L.S. # 1931  
RSV#05207SURVEY.DGN

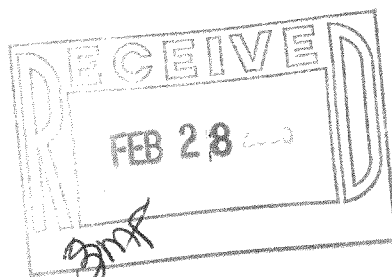

SW CORNER OF  
SECTION 16-4-18

PO-9

418-1907