

PLAT OF SURVEY -OF-

LOT 26, BLOCK 1, MIRAMAR SUBDIVISION, A SUBDIVISION LOCATED IN SECTIONS 10 AND 11, TOWNSHIP 4 NORTH, RANGE 18 EAST IN THE TOWN OF EAST TROY, WALWORTH COUNTY, WISCONSIN.

SURVEY FOR: DAN BERGER

SURVEY LOCATION: W1007 MIRAMAR DRIVE

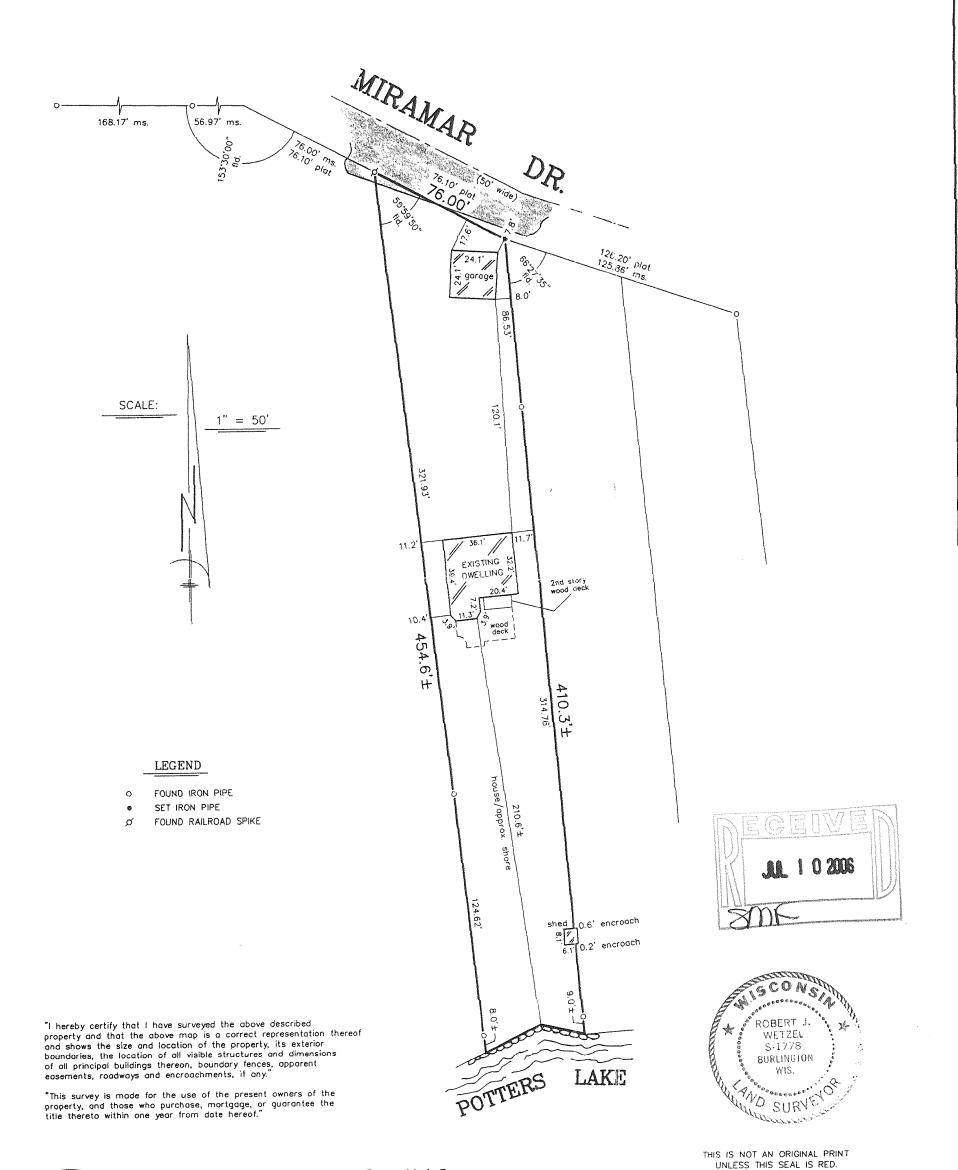

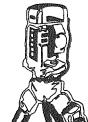

B.W. SURVEYING, INC.

LAND SURVEYS
MAPPING AND PLANNING
412 N. PINE STREET
BURLINGTON, WI 53105
(262)-767-0225

ROBERT J. WETZEL S-1778

JANUARY 9, 2006

DATE

7131 JOB NUMBER