
PLAT OF SURVEY

LOTS 23, 24, AND 25, BLOCK 5, WILMER GROVE BEACH, located in the East 1/2 of Section 18, Town 4 North, Range 18 East, Town of East Troy, Walworth County, Wisconsin.

Surveyed for: Stacey Whiting

APRIL LANE

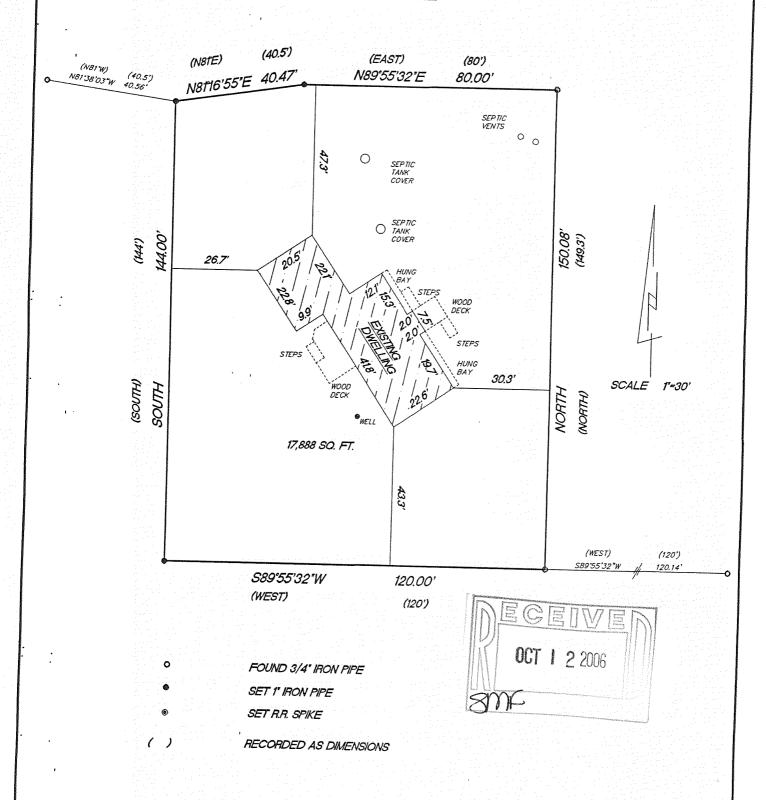

"I hereby certify that I have surveyed the above described property and that the above map is a true representation thereof and shows the size and location of the property, its exterior boundaries, the location of all visible structures and dimension of all principal buildings thereon, boundary fences, apparent easements, roadways and encroachments if any."

"This survey is made for the use of the present owners of the property, and also those who purchase, mortgage or guarantee the title thereto within one year from date hereof."

8/28/06

DATE FIELD WORK BY

KETTLE MORAINE SURVE TERRANCE INGISAREK W356 S9050 Godfrey Lange Eagle Wisconsin 53119 P.O. Box 357 (262) 594-3484 Terrance E. Pisarek R.L.S.



THIS IS NOT AN ORIGINAL SURVEY UNLESS THE SEAL IS RED.

TEP

DRAWN BY

06124

JOB NUMBER

X