


HICKORY STR.

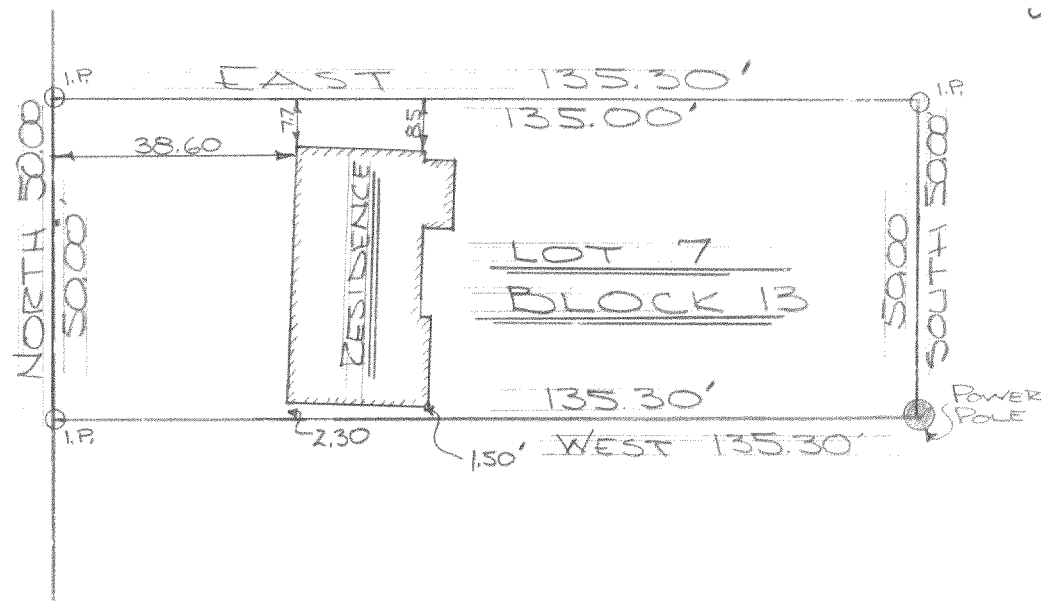

DESCRIPTION: Lot 7 of Block 13 of Miramar Subdivision,  
 Located in Sections 10 and 11 of T. 4 N.,  
 R. 18 E. Walworth County, Wisconsin.

CERTIFICATE: I, James F. Biagi, surveyor, do hereby  
 certify that I have surveyed the property  
 hereon described and that the location of  
 the improvements are as shown.

August 25, 1967.

*James F. Biagi*  
 James F. Biagi, RLS 272

