

PLAT OF SURVEY




ENGINEERING, INC.

Engineers Land Surveyors Environmental Scientists
W232 S7530 BIG BEND DR. BIG BEND, WI 53103 92621 662-4292

FOR: HOWARD WEINPER
DATE: 12/19/2006



DESCRIPTION: LOT 3 OF CERTIFIED SURVEY MAP NO. 27, BEING
LOCATED IN PART OF THE EAST 1/2 OF SECTION 9, TOWN 4 NORTH,
RANGE 18 EAST, TOWN OF EAST TROY, WALWORTH COUNTY, WISCONSIN.

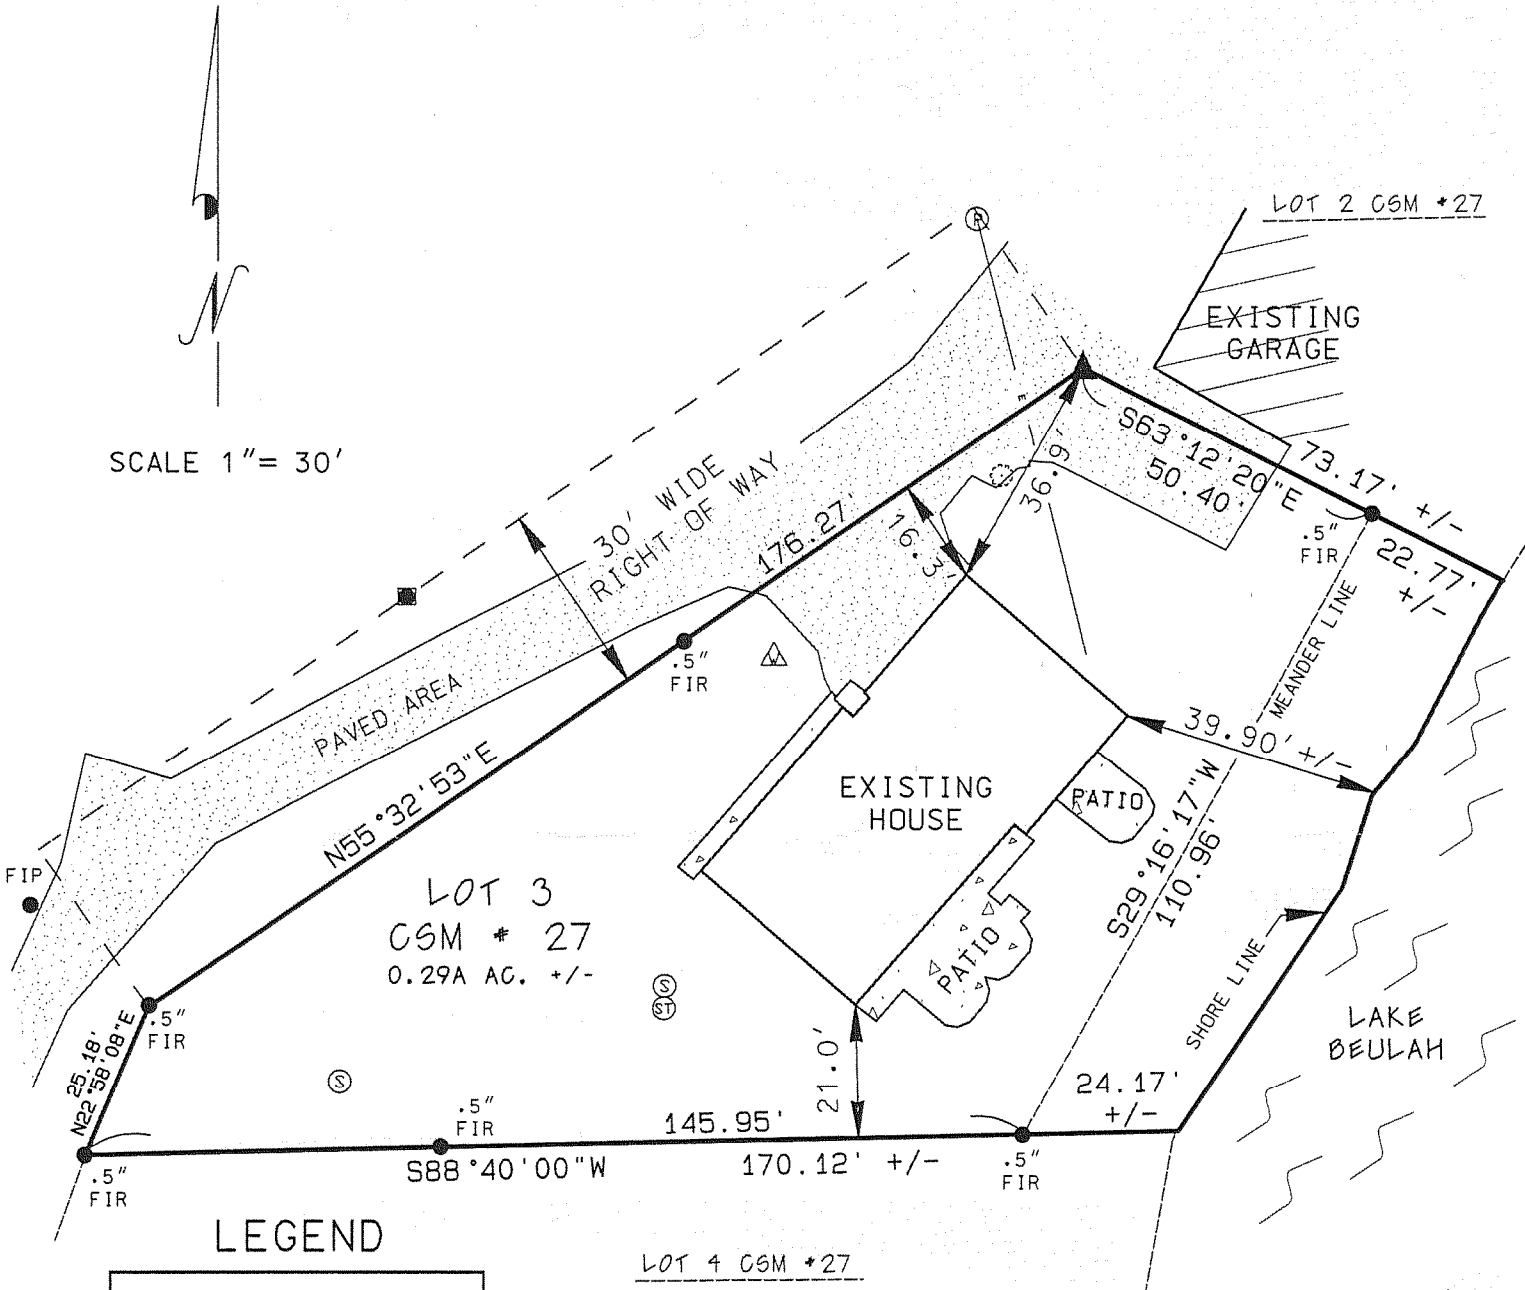

LEGEND

- FOUND IRON PIPE OR ROD AS NOTED
- ▲ FOUND PK NAIL
- FOUND IRON ROD IN CONCRETE
- Ⓢ SEPTIC VENT
- ⓈT SEPTIC TANK
- △ WELL
- Ⓟ POWER POLE
- Ⓢ PVC DRAIN

LOT 4 CSM # 27

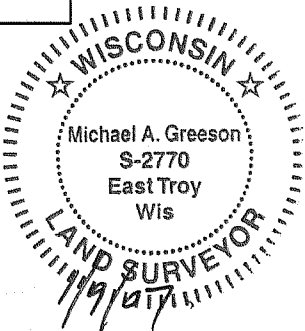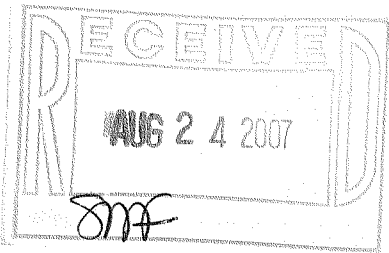

I, MICHAEL A. GREESON R.L.S. # 2770, HAVE SURVEYED THE ABOVE DESCRIBED PROPERTY AND THE ABOVE MAP IS A TRUE REPRESENTATION THEREOF AND SHOWS THE SIZE AND LOCATION OF THE PROPERTY, ITS EXTERIOR BOUNDARIES, THE LOCATION AND DIMENSIONS OF ALL STRUCTURES THEREON, FENCES, APPARENT EASEMENTS AND ROADWAYS AND VISABLE ENCROACHMENTS, IF ANY.

THIS SURVEY IS MADE FOR THE EXCLUSIVE USE OF THE PRESENT OWNERS OF THE PROPERTY, AND ALSO THOSE WHO PURCHASE, MORTGAGE OR INSURE THE TITLE THERETO WITHIN ONE (1) YEAR FROM THE DATE HEREOF; AND AS TO THEM I WARRANT THE ACCURACY OF SAID SURVEY MAP.

Michael A. Greeson

MICHAEL A. GREESON, R.L.S. # 2770
RSV #06194SURVEY.DGN

(ORIGINAL ONLY IF SEALED IN RED)