


# PLAT OF SURVEY



Engineers Land Surveyors Environmental Scientists  
 W232 S7530 BIG BEND DR. BIG BEND, WI 53103 92621 662-4292



FOR: HOWARD WEINPER  
 DATE: 12/19/2006

DESCRIPTION: LOT 3 OF CERTIFIED SURVEY MAP NO. 27, BEING  
 LOCATED IN PART OF THE EAST 1/2 OF SECTION 9, TOWN 4 NORTH,  
 RANGE 18 EAST, TOWN OF EAST TROY, WALWORTH COUNTY, WISCONSIN.

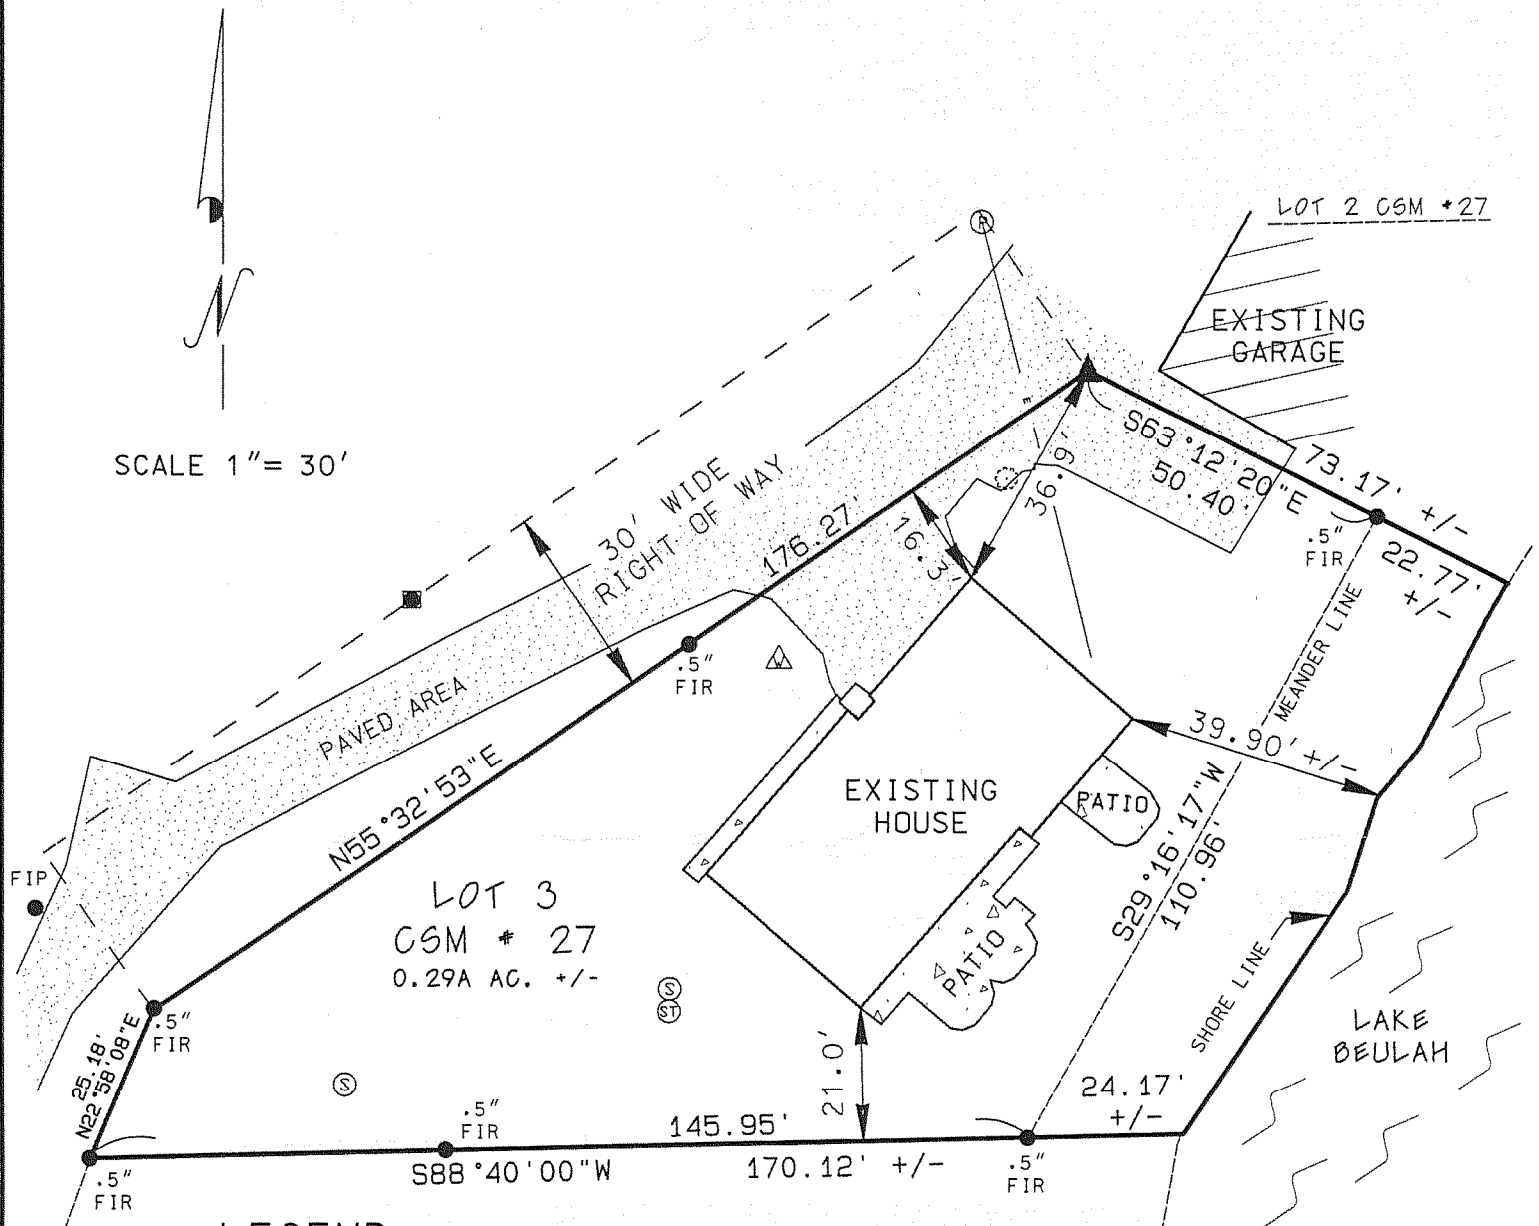

## LEGEND

- FOUND IRON PIPE OR ROD AS NOTED
- ▲ FOUND PK NAIL
- FOUND IRON ROD IN CONCRETE
- ⊙ SEPTIC VENT
- ⊙ SEPTIC TANK
- △ WELL
- ⊙ POWER POLE
- PVC DRAIN

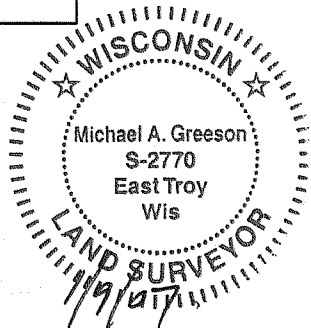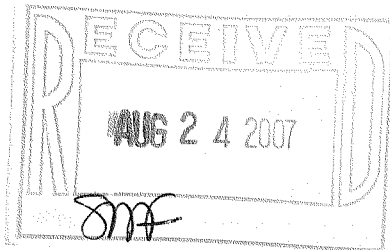

I, MICHAEL A. GREESON R.L.S. # 2770, HAVE SURVEYED THE ABOVE DESCRIBED PROPERTY AND THE ABOVE MAP IS A TRUE REPRESENTATION THEREOF AND SHOWS THE SIZE AND LOCATION OF THE PROPERTY, ITS EXTERIOR BOUNDARIES, THE LOCATION AND DIMENSIONS OF ALL STRUCTURES THEREON, FENCES, APPARENT EASEMENTS AND ROADWAYS AND VISABLE ENCROACHMENTS, IF ANY.

THIS SURVEY IS MADE FOR THE EXCLUSIVE USE OF THE PRESENT OWNERS OF THE PROPERTY, AND ALSO THOSE WHO PURCHASE, MORTGAGE OR INSURE THE TITLE THERETO WITHIN ONE (1) YEAR FROM THE DATE HEREOF; AND AS TO THEM I WARRANT THE ACCURACY OF SAID SURVEY MAP.

*Michael A. Greeson*

MICHAEL A. GREESON, R.L.S. # 2770  
 RSV #06194SURVEY.DGN

(ORIGINAL ONLY IF SEALED IN RED)