



PLAT OF SURVEY

LOT 10 IN FREUCK'S SECOND SUBDIVISION, in the Northwest fractional 1/4 of Section 18, Town 4 North, Range 18 East in the Town of East Troy, Walworth County, Wisconsin.

Surveyed for: Richard and Pat Wilke

Survey address: W2405 New Deal Ave

NEW DEAL AVE.

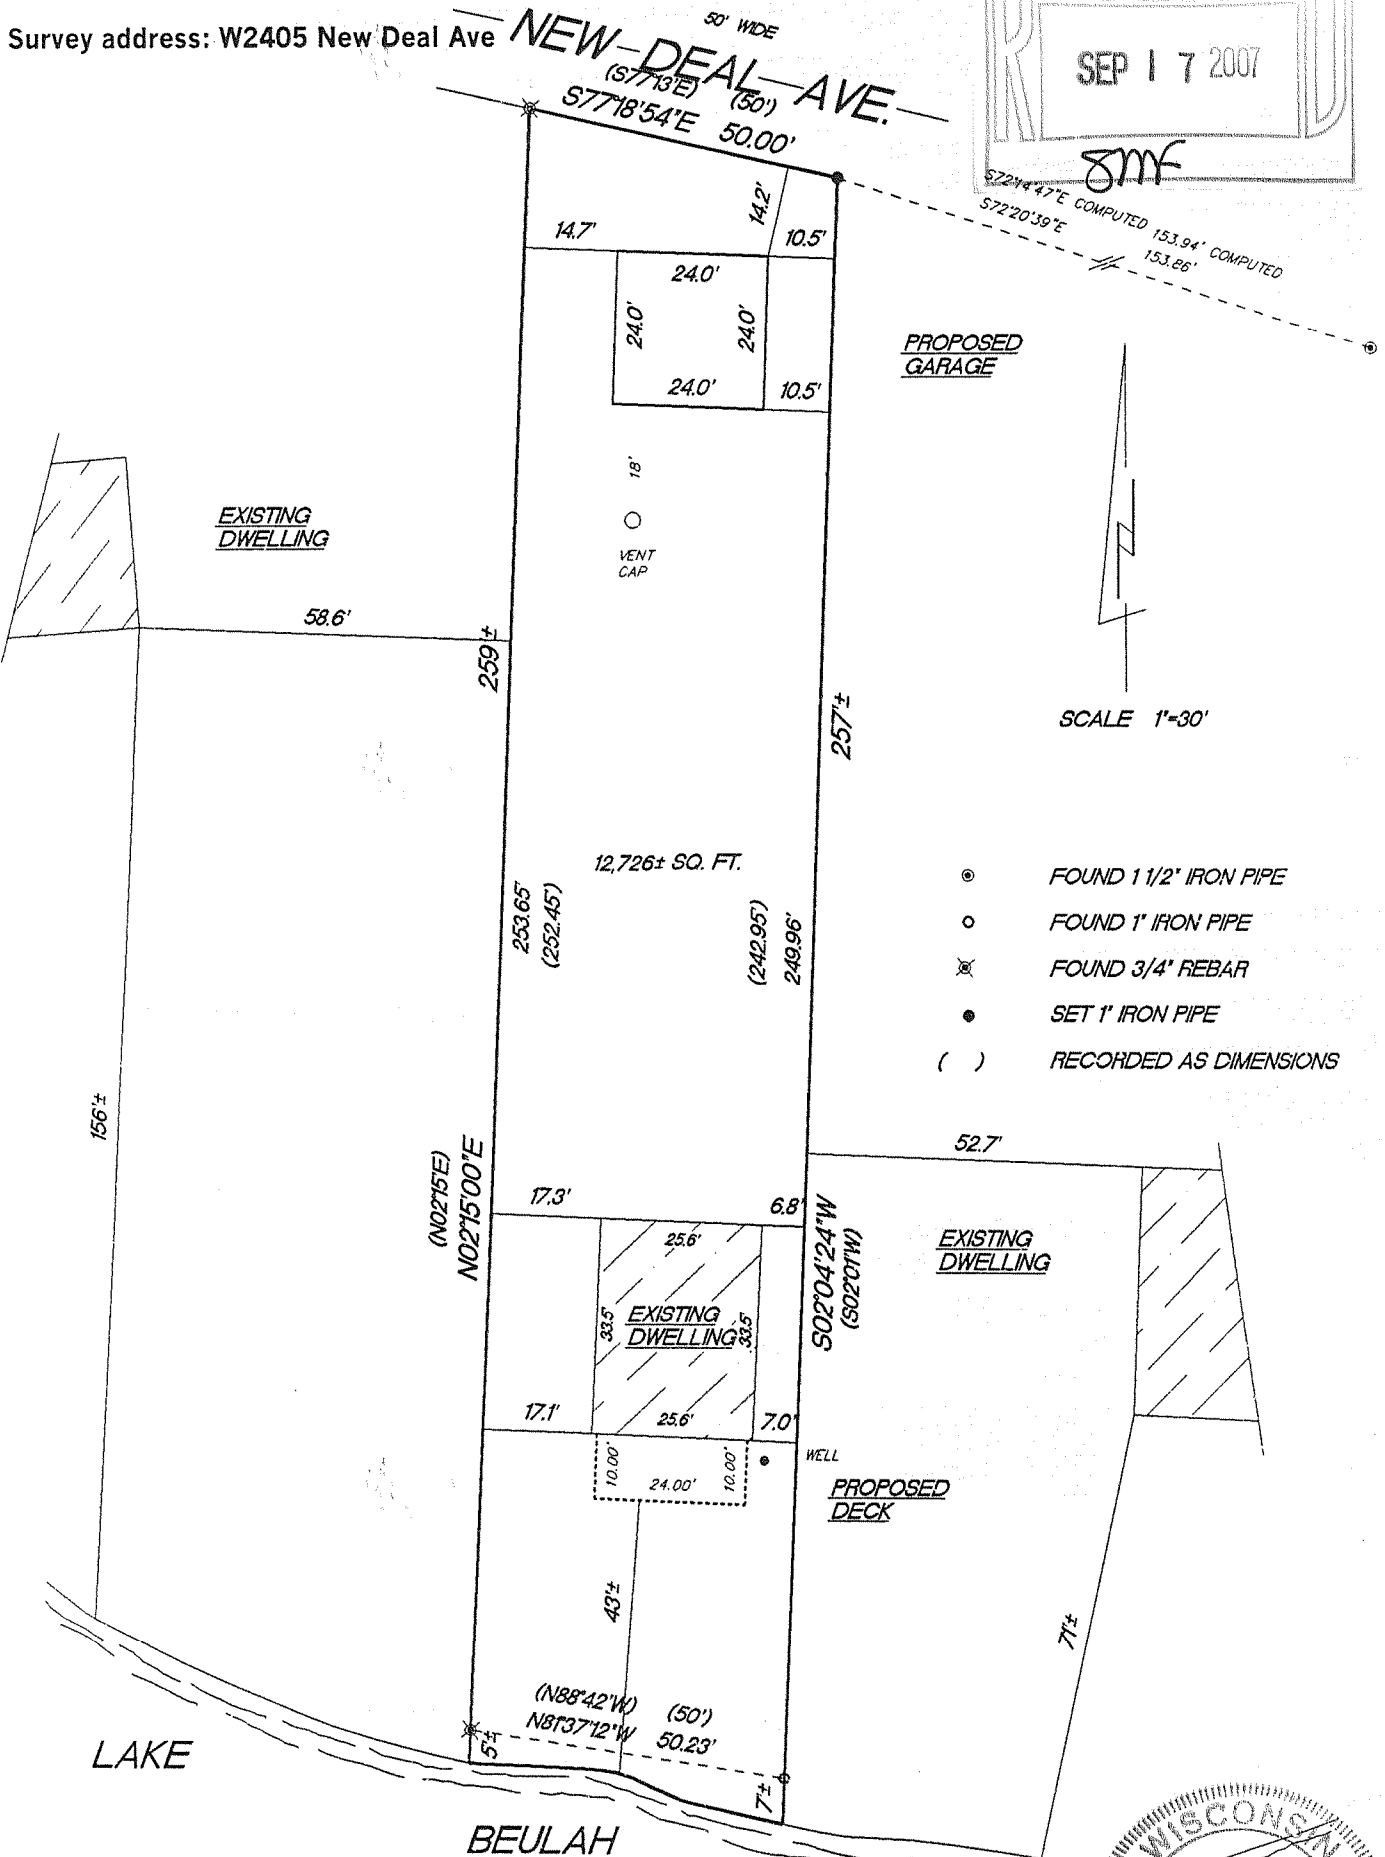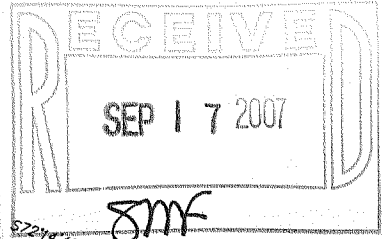

"I hereby certify that I have surveyed the above described property and that the above map is a true representation thereof and shows the size and location of the property, its exterior boundaries, the location of all visible structures and dimension of all principal buildings thereon, boundary fences, apparent easements, roadways and encroachments if any."

"This survey is made for the use of the present owners of the property, and also those who purchase, mortgage or guarantee the title thereto within one year from date hereof."

KETTLE MORaine SURVEYING INC.

S75 W36245 Wilton Road

Eagle Wisconsin 53119

P.O. Box 357

(262) 594-3484

Terrance E. Pisarek R.L.S.



THIS IS NOT AN ORIGINAL SURVEY UNLESS THE SEAL IS RED.

8/28/07
DATE

TEP
FIELD WORK BY

TEP
DRAWN BY

07122
JOB NUMBER

PF52-8

418-2005