PREPARED FOR CHARLES PLOTZ N168 W21700 MAIN ST. LOT 175 JACKSON, WI. 53037


PLAT OF SURVEY

-OF-

LOT 38 IN SHOREWOOD, BEING A SUBDIVISION OF PART OF PART OF THE SOUTHEAST 1/4 OF SECTION 10, THE SOUTHWEST 1/4 OF SECTION 11, THE NORTHWEST 1/4 OF SECTION 14 AND THE NORTHEAST 1/4 OF SECTION 15, TOWN 4 NORTH, RANGE 18 EAST, WALWORTH COUNTY, WISCONSIN.

KROTT SURVEYING INC.

N3705 WILLOW BEND LANE LAKE GENEVA WI. 53147 PHONE # (262)248-3697 FAX # (262)249-0639

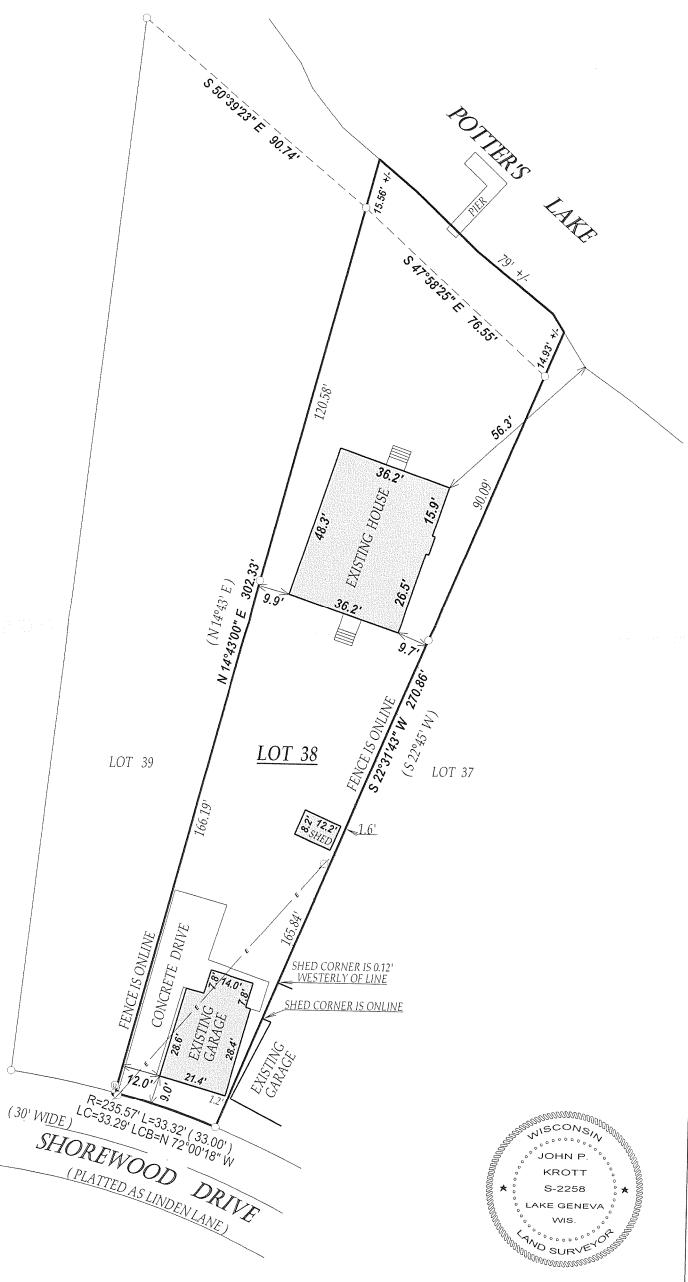

LEGEND

O FOUND IRON PIPE

• FOUND CONCRETE MONUMENT

SCALE 1" = 30'

30

60

AUG 1-2 2000

• UTILITY PEDISTAL

Ø POWER POLE

—*E*— OVERHEAD WIRES

(XX) RECORDED AS

JOB # 08-128

TAX 10 # PS00038

DATED THIS THE 11th DAY OF JUNE 2008.

"I hereby certify that I have surveyed the above described property and that the above map is a true representation thereof and shows the size and location of all visible structures, apparent easements and encroachments if any."

This survey is made for the present owners of the property, and those who purchase, mortgage, or guarentee the title thereto, within one year from the date hereof.

418-21010

JOHN KROTT S - 2258 Wisconsin Registered Land Surveyor

(original if signed in red)