



The West 1/2 of **LOT 114, BELUAH HEIGHTS**, a Subdivision located in Sections 7,8,17 and 18, Township 4 North, Range 18 East, Town of East Troy, Walworth County, Wisconsin.

Survey address: W2082 Beulah Heights Rd.

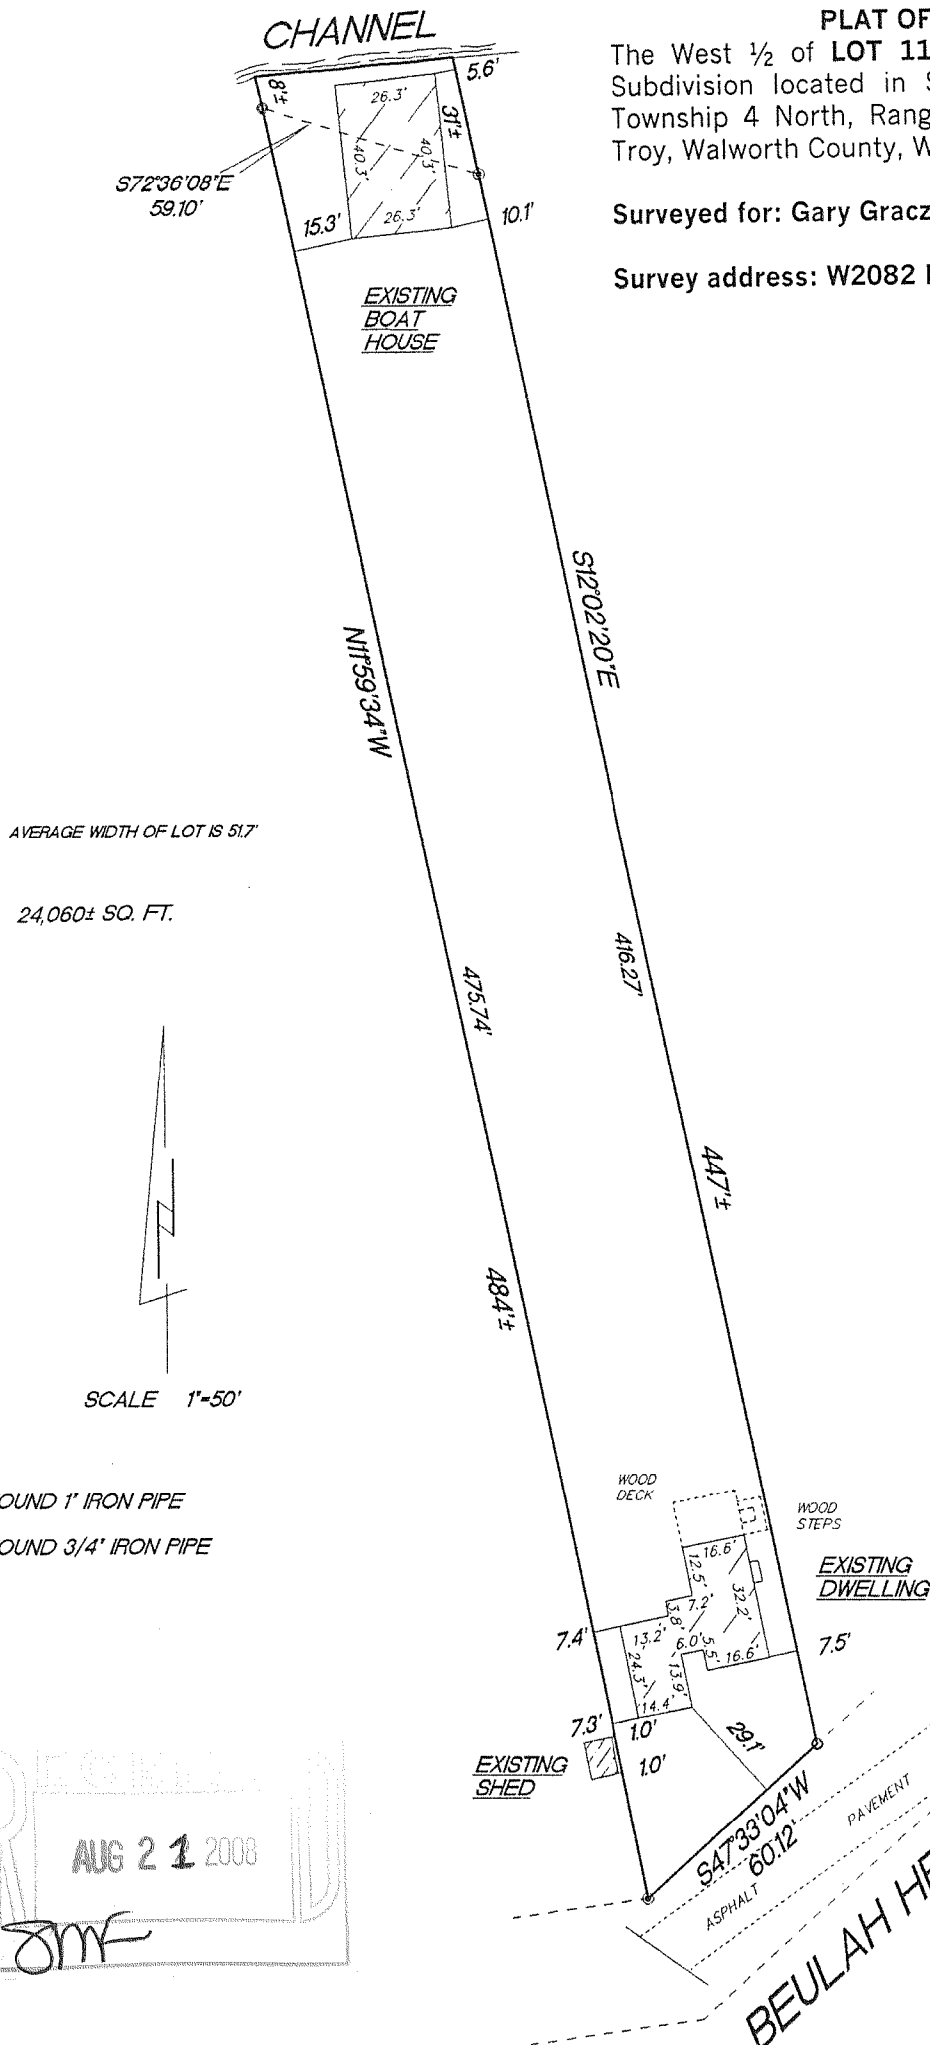

"This survey is made for the use of the present owners of the property, and also those who purchase, mortgage or guarantee the title thereto within one year from date hereof."

Terrance E. Pisarek R.L.S.

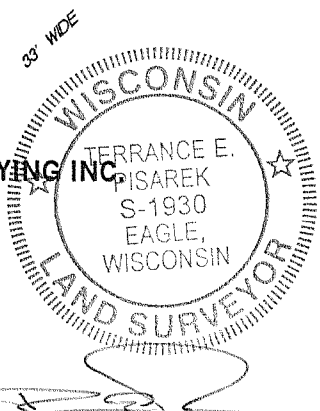

THIS IS NOT AN ORIGINAL SURVEY UNLESS THE SEAL IS RED.

3075

JOB NUMBER

418-2110