
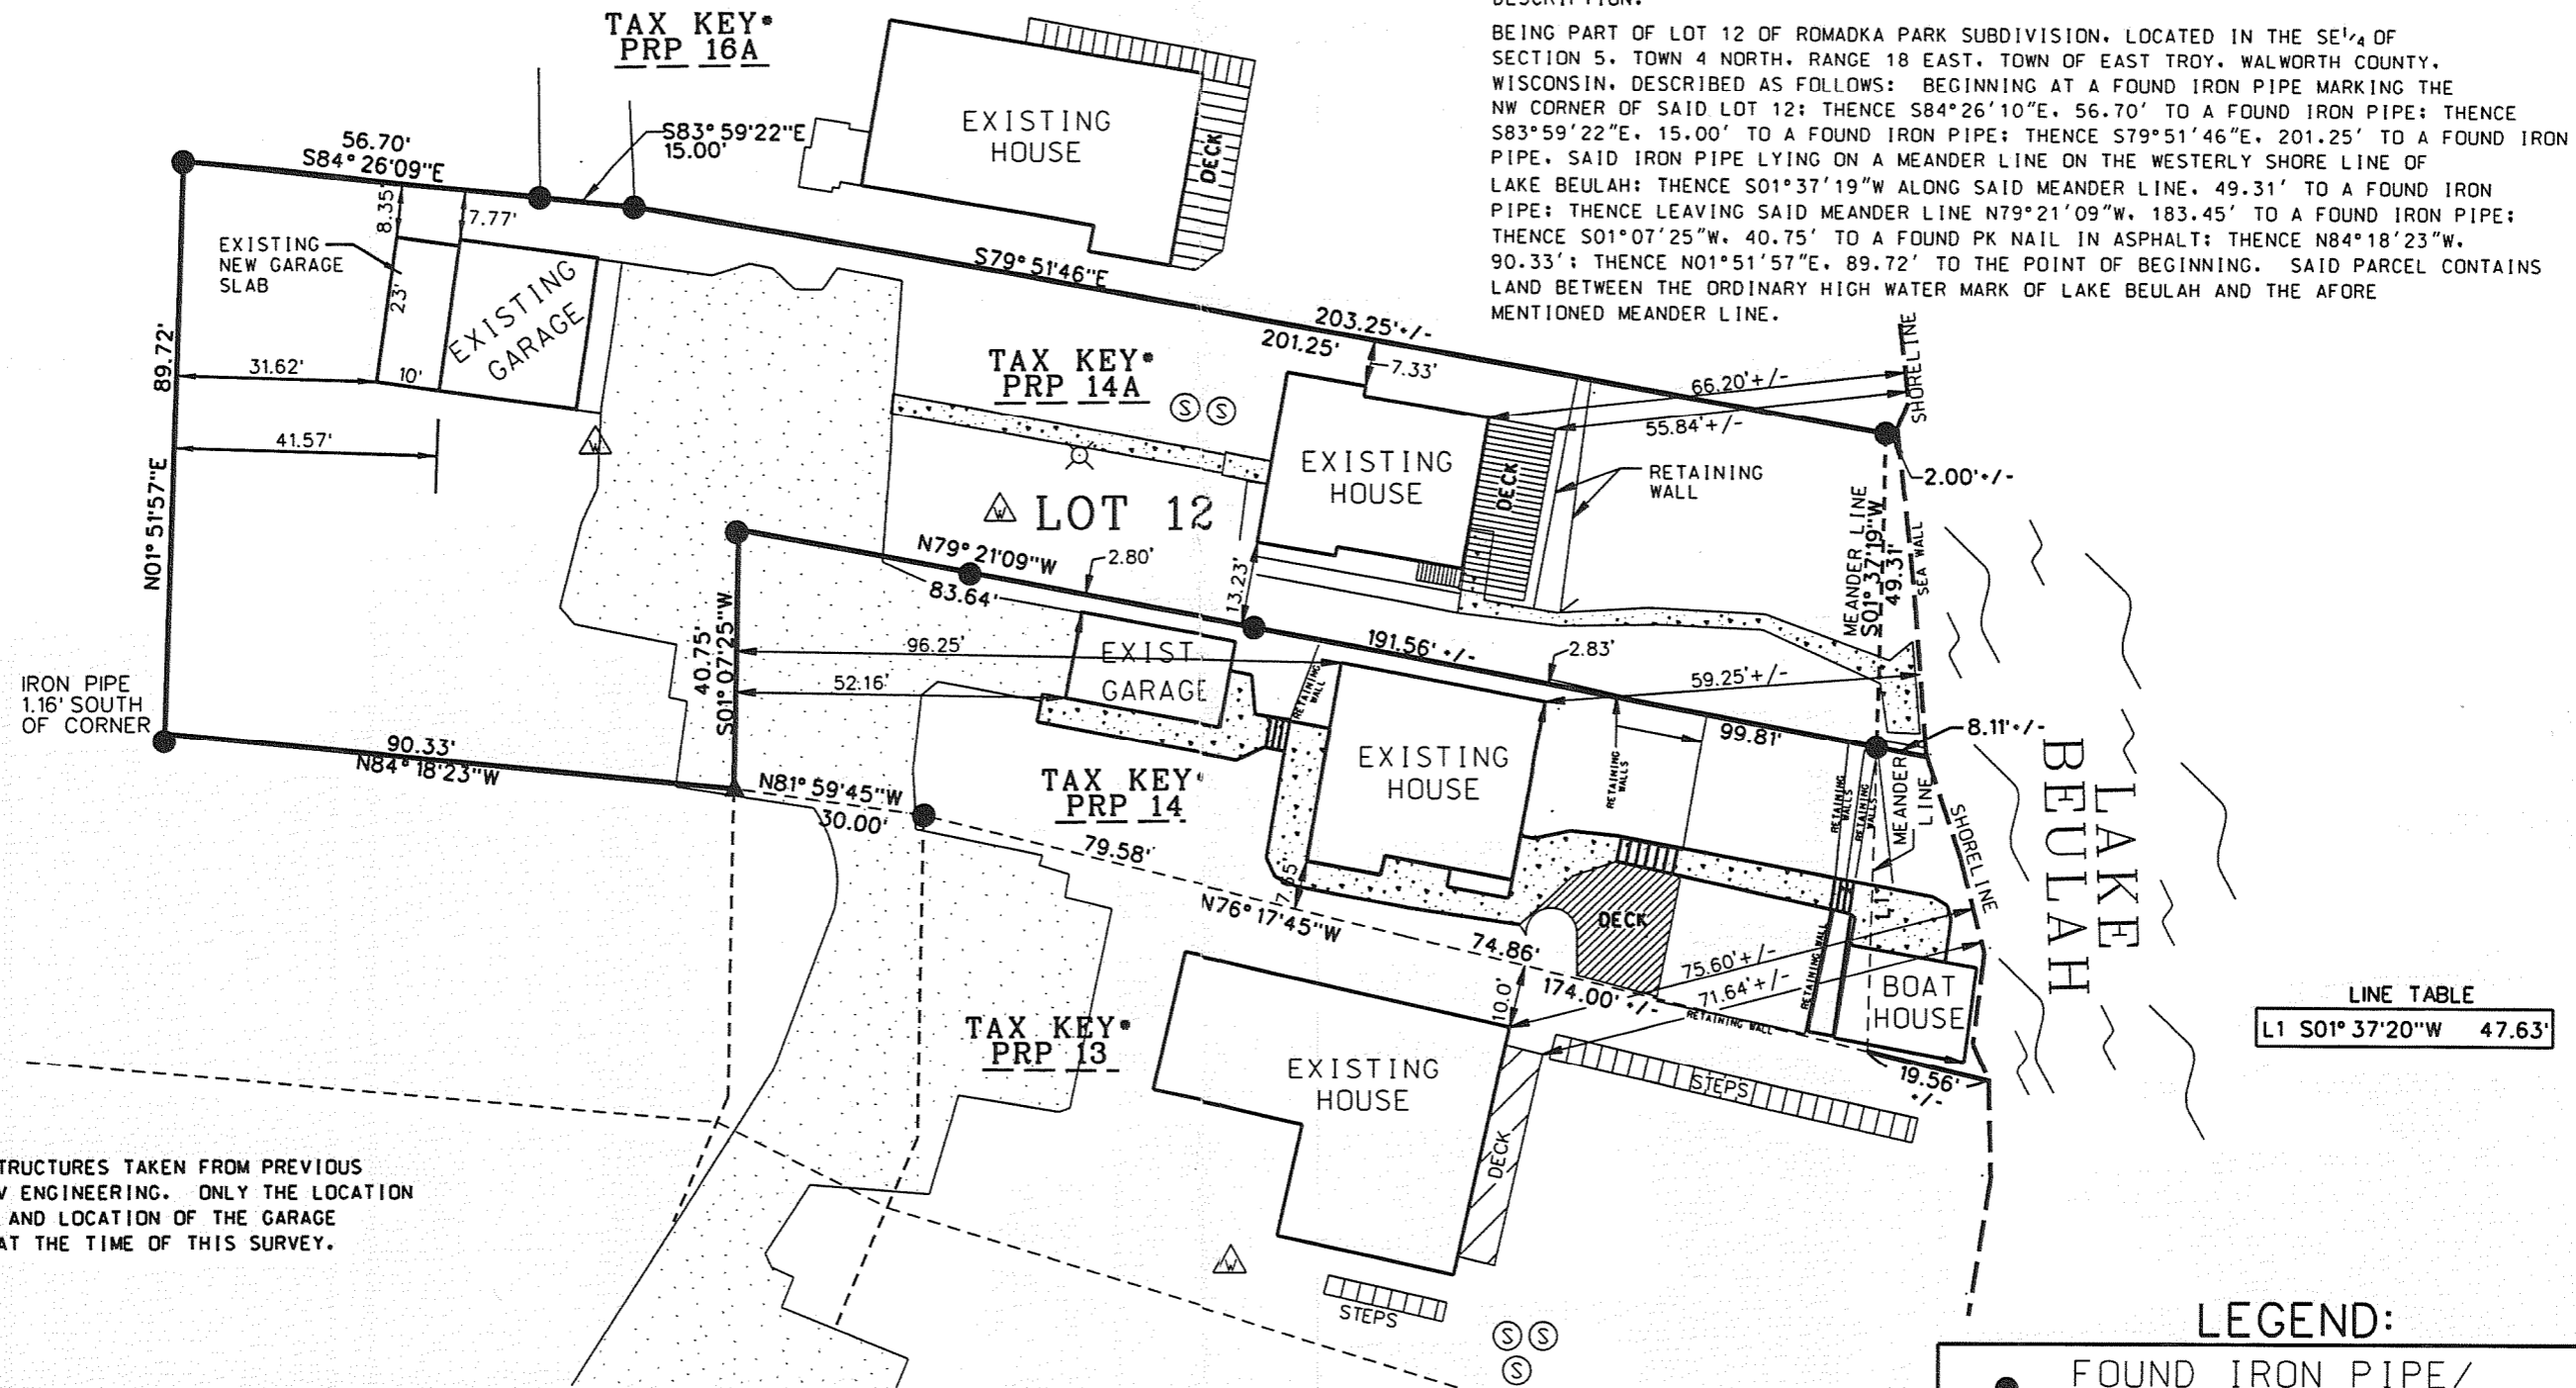


PLAT OF SURVEY

DESCRIPTION:

BEING PART OF LOT 12 OF ROMADKA PARK SUBDIVISION, LOCATED IN THE SE 1/4 OF SECTION 5, TOWN 4 NORTH, RANGE 18 EAST, TOWN OF EAST TROY, WALWORTH COUNTY, WISCONSIN, DESCRIBED AS FOLLOWS: BEGINNING AT A FOUND IRON PIPE MARKING THE NW CORNER OF SAID LOT 12: THENCE S84°26'10"E, 56.70' TO A FOUND IRON PIPE; THENCE S83°59'22"E, 15.00' TO A FOUND IRON PIPE; THENCE S79°51'46"E, 201.25' TO A FOUND IRON PIPE, SAID IRON PIPE LYING ON A MEANDER LINE ON THE WESTERLY SHORE LINE OF LAKE BEULAH; THENCE S01°37'19"W ALONG SAID MEANDER LINE, 49.31' TO A FOUND IRON PIPE; THENCE LEAVING SAID MEANDER LINE N79°21'09"W, 183.45' TO A FOUND IRON PIPE; THENCE S01°07'25"W, 40.75' TO A FOUND PK NAIL IN ASPHALT; THENCE N84°18'23"W, 90.33'; THENCE N01°51'57"E, 89.72' TO THE POINT OF BEGINNING. SAID PARCEL CONTAINS LAND BETWEEN THE ORDINARY HIGH WATER MARK OF LAKE BEULAH AND THE AFORE MENTIONED MEANDER LINE.

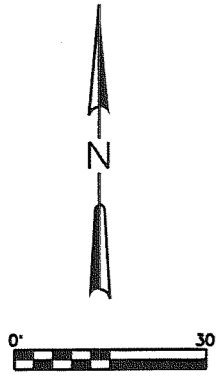

LINE TABLE

L1 S01°37'20"W	47.63'
----------------	--------

NOTE:
 LOCATION OF EXISTING STRUCTURES TAKEN FROM PREVIOUS SURVEY PERFORMED BY RSV ENGINEERING. ONLY THE LOCATION OF THE EXSITING GARAGE AND LOCATION OF THE GARAGE ADDITION WERE LOCATED AT THE TIME OF THIS SURVEY.



LEGEND:

- FOUND IRON PIPE / REBAR AS NOTED
- SET 1" IRON PIPE
- ▲ SET PK NAIL IN PAVEMENT
- ▭ CONCRETE SIDEWALK
- ▭ ASPHALT PAVED AREA

SURVEY DATE: 09/29/08
SURVEY MADE FOR:
 DAVID BERG
 MARGAARET BERG
 5350 W KEENEY ST.
 SKOKIE, IL 60077
RSV ENGINEERING, INC.
 W232 S7530 BIG BEND DRIVE
 BIG BEND, WI 53103
 (262) 662-4292

THIS SURVEY IS MADE FOR THE USE OF THE PRESENT OWNERS OF THE PROPERTY, AND ALSO THOSE WHO PURCHASE, MORTGAGE OR GUARANTEE TITLE TO WITHIN ONE (1) YEAR FROM DATE HERETO.

I, MICHAEL A. GREESON R.L.S. *2770, HEREBY CERTIFY THAT THIS SURVEY WAS MADE IN ACCORDANCE WITH THE MINIMUM STANDARDS FOR PROPERTY SURVEYS (CHAPTER A-E 7) FOR THE STATE OF WISCONSIN AND HAS BEEN PREPARED UNDER MY DIRECTION AND CONTROL AND IS CORRECT TO THE BEST OF MY KNOWLEDGE AND BELIEF.

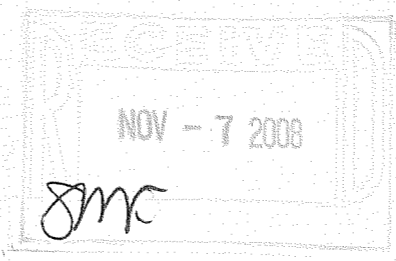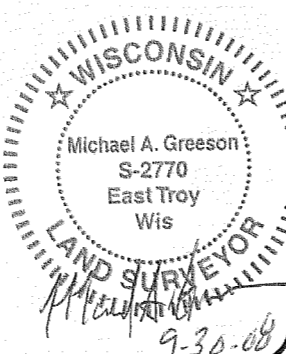

418-2129

FILE NAME: 04SURVEYS\04234 BERG 30 SCALE.DGN