
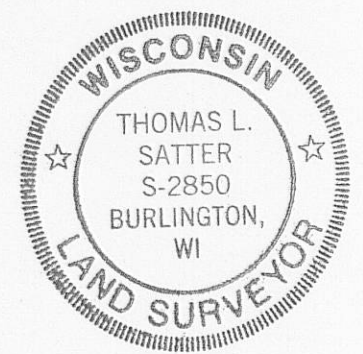
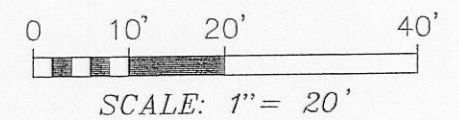



BEARINGS HEREON RELATE TO THE EAST
RIGHT-OF-WAY LINE OF HICKORY STREET.
ASSUMED BEARING OF NORTH-SOUTH.

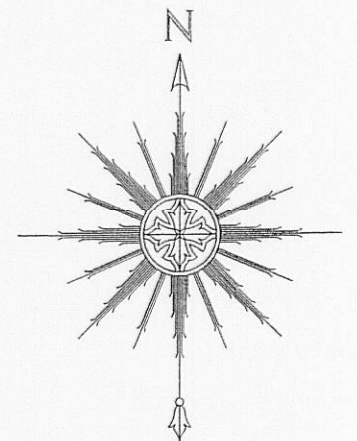

THIS IS NOT AN ORIGINAL PRINT
UNLESS THIS SEAL IS RED.

Thomas L. Satter
THOMAS L. SATTER S-2850


JUNE 24, 2011 061101
DATE JOB NUMBER

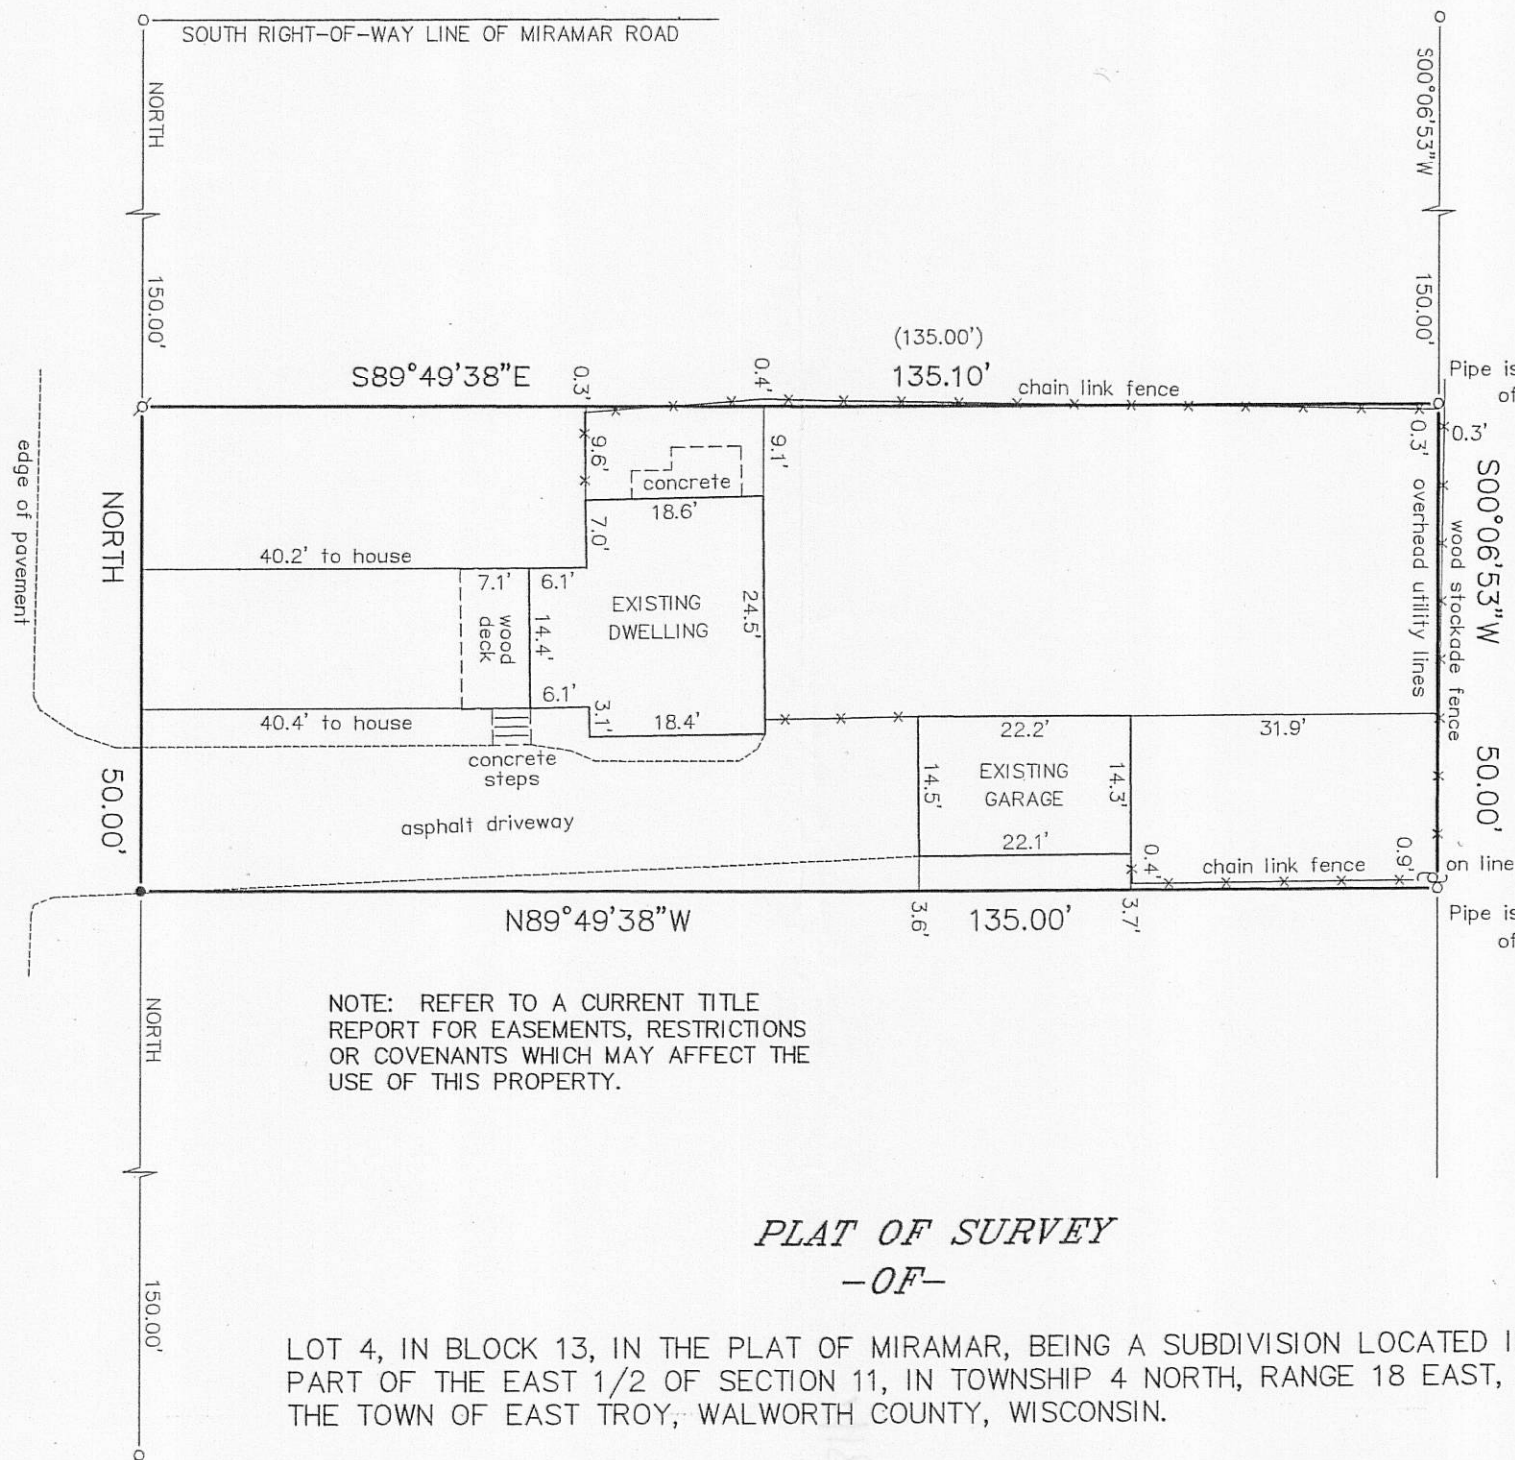

NOTE: REFER TO A CURRENT TITLE
REPORT FOR EASEMENTS, RESTRICTIONS
OR COVENANTS WHICH MAY AFFECT THE
USE OF THIS PROPERTY.

LEGEND

- FOUND IRON PIPE
- ⌘ SET IRON PIPE
- SET MASONRY NAIL
- ⊕ UTILITY POLE
- () RECORDED AS

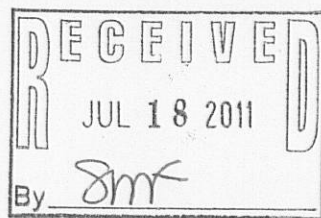

"I HEREBY CERTIFY THAT I HAVE SURVEYED THE ABOVE
DESCRIBED PROPERTY AND THAT THE ABOVE MAP IS A CORRECT
REPRESENTATION THEREOF AND SHOWS THE SIZE AND LOCATION
OF THE PROPERTY, ITS EXTERIOR BOUNDARIES, THE LOCATION
OF ALL VISIBLE STRUCTURES AND DIMENSIONS OF ALL
PRINCIPAL BUILDINGS THEREON, BOUNDARY FENCES, APPARENT
EASEMENTS, ROADWAYS AND ENCROACHMENTS, IF ANY."

"THIS SURVEY IS MADE FOR THE USE OF THE PRESENT OWNERS
OF THE PROPERTY, AND THOSE WHO PURCHASE, MORTGAGE, OR
GUARANTEE THE TITLE THERETO WITHIN ONE YEAR FROM DATE
HEREOF."

SATTER SURVEYING, LLC
LAND SURVEYS, MAPPING AND PLANNING
272 ORIGEN STREET
BURLINGTON, WI 53105
262-661-4239

PMR-144

418-2220