
PLAT OF SURVEY

ENGINEERING, INC.
Engineers-Land Surveyors-Environmental Scientists
57530 BIG BEND DRIVE - BIG BEND, WISCONSIN 53103 (262) 662-4292

DATE: 11-20-09

DATE: 6-25-02

JAMES E. PROBST DESCRIPTION: PART OF THE NW',4 OF SECTION 17, T4N, R18E, TOWN OF EAST TROY, WALWORTH COUNTY, WISCONSIN, FURTHER DESCRIBED AS FOLLOWS: COMMENCING AT THE SOUTH',4 CORNER OF SAID SECTION 17; THENCE NORTH ALONG NORTH—SOUTH',4 LINE, A DISTANCE OF 3870' TO A POINT; THENCE S86°05'W A DISTANCE OF 862' THENCE N86°05'E A DISTANACE OF 89.00 FEET; THENCE N39°28'W A DISTANCE OF 36'; THENCE N24°32'E A DISTANCE OF 152' TO THE POINT OF BEGINNING; THENCE N49°49'25"E A DISTANCE OF 100.77'; THENCE N15°41'01"W A DISTANCE OF 240.69' TO A POINT ON THE MEANDER LINE OF LAKE BEULAH; THENCE S53°27'21"W ALONG SAID MEANDER LINE A DISTANCE OF 129.20'; THENCE S22°41'18"E A DISTANCE OF 238.32' TO THE POINT OF BEGINNING. INCLUDING THE LAND BETWEEN THE MEANDER LINE AND THE SHORE OF LAKE BEULAH. FOR:

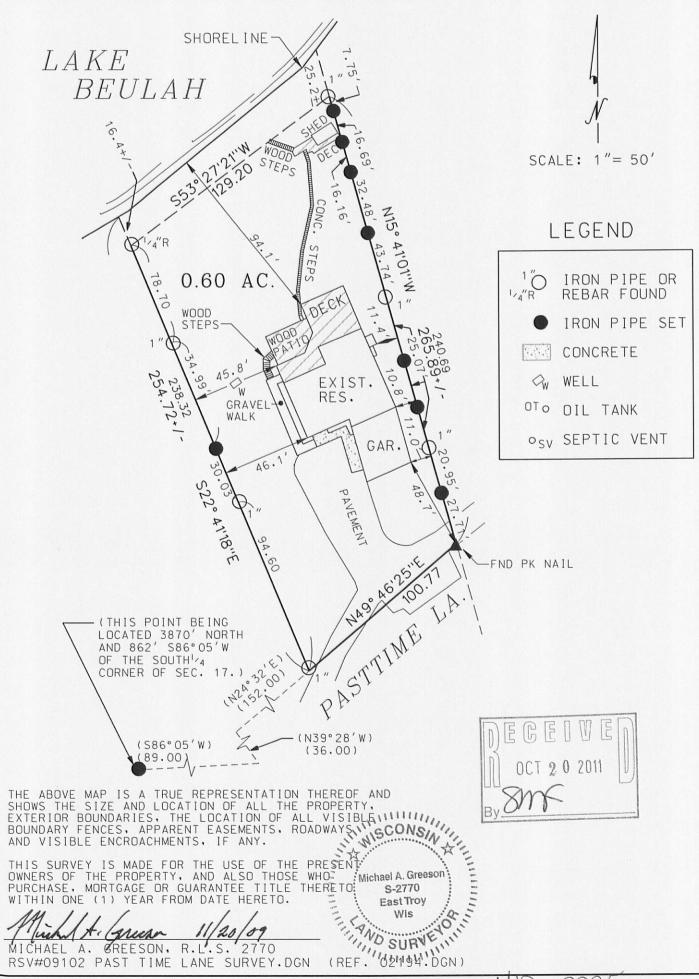

MICHAEL A. GREESON, R.L.S. 2770 RSV#09102 PAST TIME LANE SURVEY.DGN (REF. 02194.DGN)