



# PLAT OF SURVEY

LOT 1 OF CERTIFIED SURVEY MAP NO. 4192 BEING  
PART OF LOTS 17, 18, AND 19 OF BEULAH LAKE PARK SUBDIVISION,  
AND PART OF LOTS 1, AND 6 OF PORTERS PARK SUBDIVISION  
LOCATED IN GOVERNMENT LOT 1 BEING PART OF THE SE 1/4 OF  
SECTION 4, TOWN 4 NORTH, RANGE 18 EAST, TOWN OF EAST TROY,  
WALWORTH COUNTY, STATE OF WISCONSIN

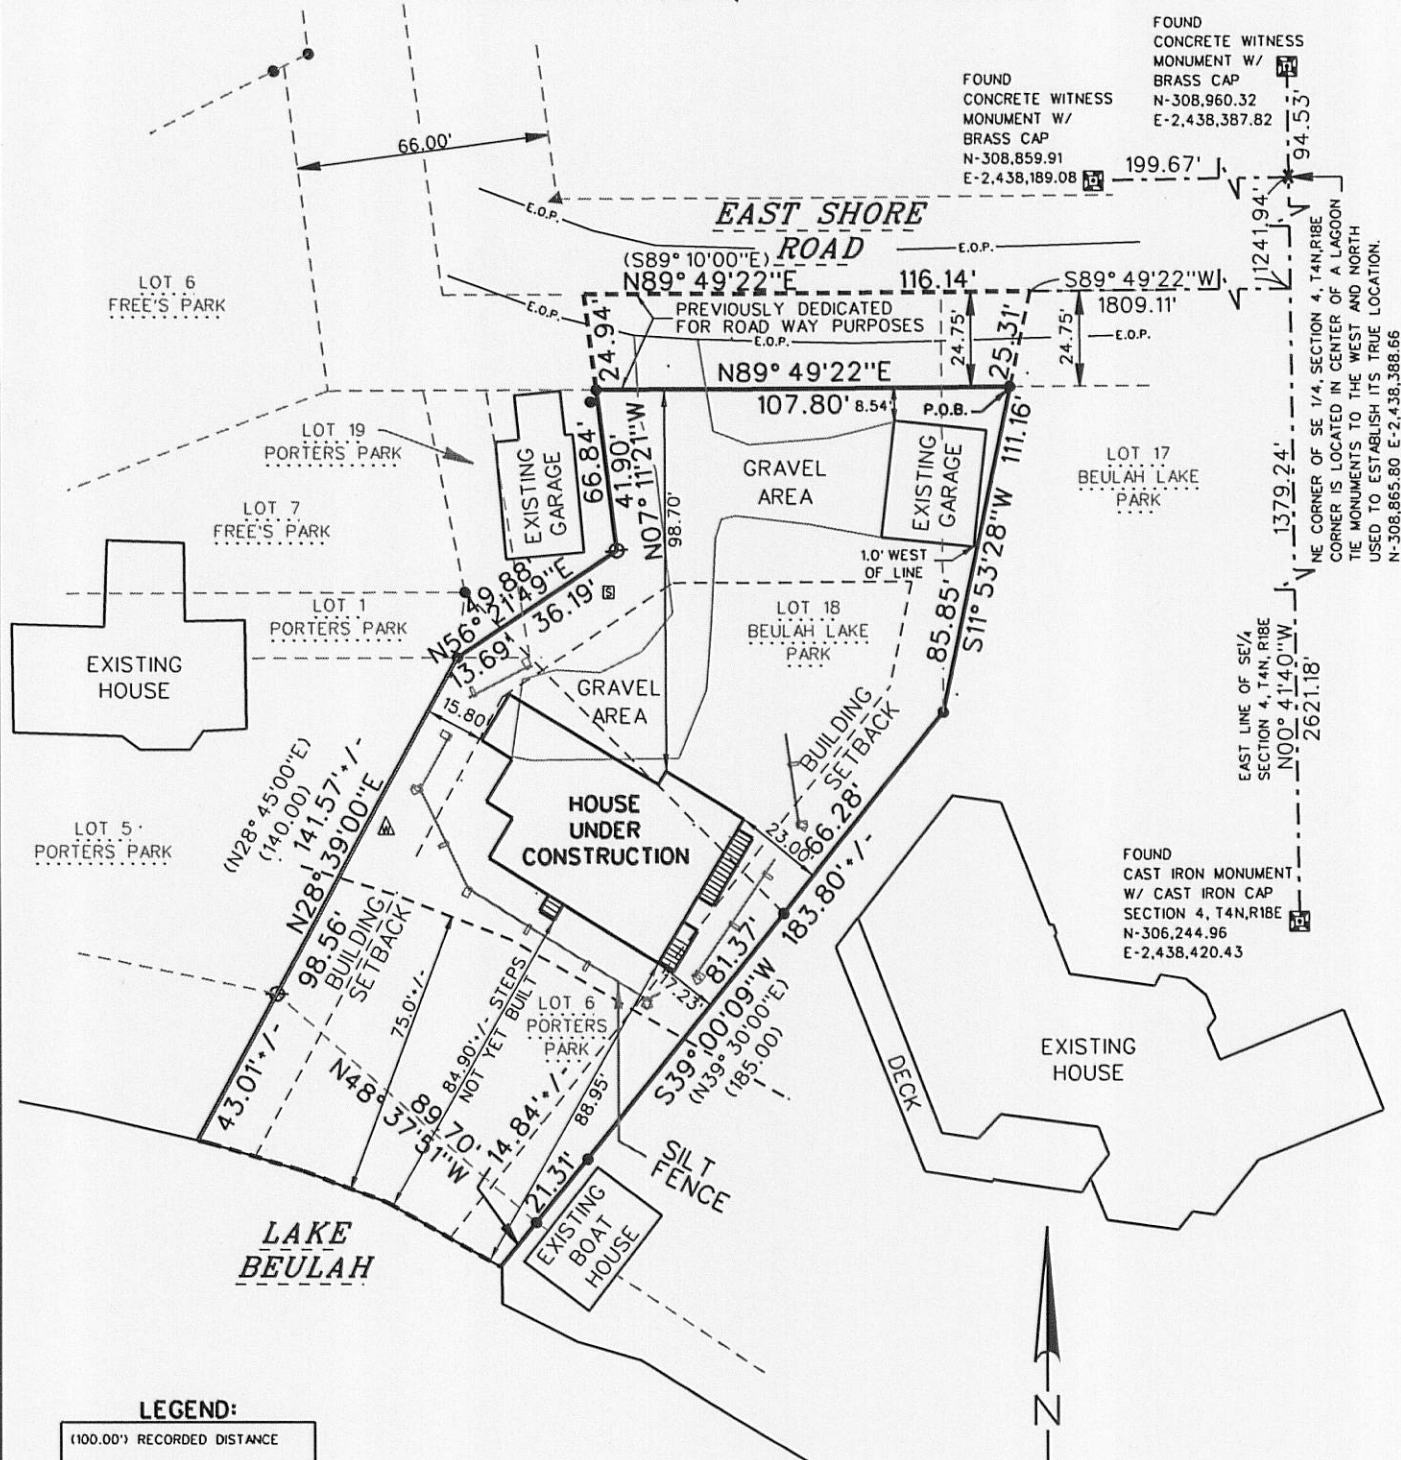

## LEGEND:

- (100.00') RECORDED DISTANCE
- 100.00' MEASURED DISTANCE
- 1" FOUND IRON PIPE, UNLESS NOTED
- ⊗ 3/4" x 18" IRON PIPE SET, 1.13 lbs./L.F.
- ▲ FOUND "PK" NAIL
- ⚠ EXISTING WELL
- Ⓢ EXISTING SEPTIC
- GROUND WATER FLOW

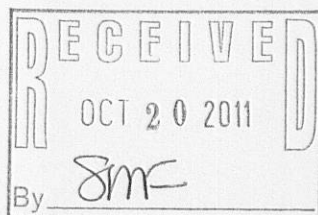

0' 50'


\*\*EXISTING GROUND SLOPE OF LOT TO REMAIN UNCHANGED.

SURVEY DATE: 01/26/09  
SURVEY MADE FOR:  
PAUL RIEDL, SR.  
15955 WEST ARMOUR AVE.  
NEW BERLIN, WI 53151

**RSV**  
ENGINEERING, INC.  
W232 S7530 BIG BEND DRIVE  
BIG BEND, WI 53103  
(262) 662-4292

THIS SURVEY IS MADE FOR THE USE OF THE  
PRESENT OWNERS OF THE PROPERTY, AND  
ALSO THOSE WHO PURCHASE, MORTGAGE OR  
GUARANTEE TITLE TO WITHIN ONE (1) YEAR  
FROM DATE HERETO.

I, MICHAEL A. GREESON R.L.S. #2770, HEREBY CERTIFY THAT THIS SURVEY WAS MADE IN ACCORDANCE WITH THE MINIMUM STANDARDS FOR PROPERTY SURVEYS (CHAPTER A-E 7) FOR THE STATE OF WISCONSIN AND HAS BEEN PREPARED UNDER MY DIRECTION AND CONTROL AND IS CORRECT TO THE BEST OF MY KNOWLEDGE AND BELIEF.

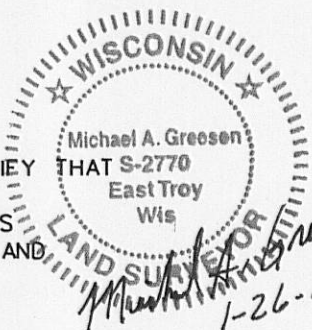

PLOT DATE: 01-26-2009

RSV JOB#: 07172 HOUSE RECERT SURVEY

FILE NAME: 07172 HOUSE RECERT SURVEY

PA4192-1

418-2286