

W 238 S 3712 BIG BEND ROAD  
WAUKESHA, WIS 53186

TELEPHONE  
542-5616

RONALD H. ZIMMERMAN  
REGISTERED LAND SURVEYOR

PLAT OF SURVEY  
FOR  
WAUKESHA SAVINGS & LOAN



STATE OF WISCONSIN )  
COUNTY OF WAUKESHA ) SS


CERTIFICATION

I, RONALD H. ZIMMERMAN, REGISTERED LAND SURVEYOR, DO HEREBY CERTIFY THAT I HAVE MADE A SURVEY  
OF LOT 6 & 7 EXC N 7, LOT 22 & 23, FAIRWAY SUB'D, TOWN OF EAST TROY  
AND THE EXISTING BUILDING AND IMPROVEMENTS LOCATED THEREON AND THAT THE PLAT HERWITH DRAWN  
IS A CORRECT REPRESENTATION OF SAID SURVEY

DATE MAY 7, 1974

RONALD H. ZIMMERMAN

S - 868

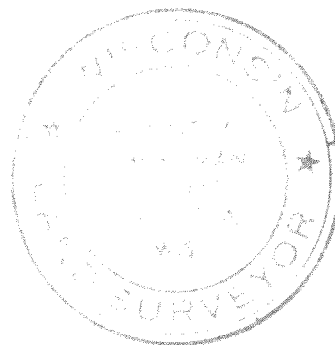

PF-6

PF-67 + PF-22 + PF-23

418-230