

LAKE


BEULAH

PLAT OF SURVEY
-OF-

UNIT 2 OF HIGHLAND VIEW ESTATES CONDOMINIUM, LOCATED IN THE NORTHWEST 1/4 OF SECTION 17, TOWN 4 NORTH,
RANGE 18 EAST OF THE FOURTH PRINCIPAL MERIDIAN, TOWN OF EAST TROY, WALWORTH COUNTY, WISCONSIN.


SURVEY FOR: HACKBARTH BUILDERS

SURVEY ADDRESS: N8757 GRAND VIEW DRIVE

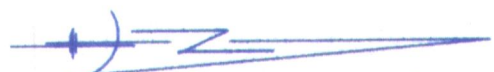

SCALE 1" = 20'

GRAPHIC SCALE

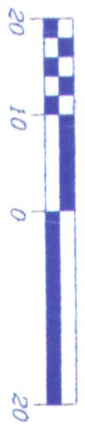


- LEGEND
- FOUND MON ROD
 - SET MON PIPE
 - EXISTING ELEVATION
 - WELL
 - RECORDED AS

"I, Robert J. Wetzel, have surveyed the above described property and find the above map is a correct representation thereof and shows the size and location of the property, its exterior boundaries, and the location of all buildings, structures, and other improvements thereon, and the location of all easements, rights, and interests therein, and the location of all other matters affecting the property, and those with purchase, mortgage, or guarantee the title thereto when and from their date of record."

B.W. SURVEYING, INC.

412 N. PINE STREET
BURLINGTON, WI 53105
(262)-767-0225

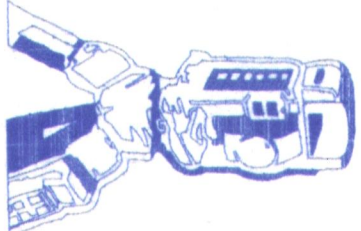

Robert J. Wetzel
ROBERT J. WETZEL
S-1778

DRAWN BY:	RPW	DATE:	8/27/2012
CHECKED BY:	RJW	DRAWING NO.:	8521CONT.
JOB NO.:	8522	SHEET	1 OF 1