

PLAT OF SURVEY

PROPERTY DESCRIPTION: (Per Document No.: 805538)

Lot Four (4) of CERTIFIED SURVEY MAP NO. 4082, being a part of the Northwest One-quarter ($\frac{1}{4}$) and Northeast One-quarter ($\frac{1}{4}$) of the Northeast One-quarter ($\frac{1}{4}$) of Section Eighteen (18) and part of the Southeast One-quarter ($\frac{1}{4}$) of the Southeast One-quarter ($\frac{1}{4}$) of Section Seven (7), all in Township Four (4) North, Range Eighteen (18) East, in the Town of East Troy, Walworth, Wisconsin, and recorded in the Office of the Register of Deeds for Walworth County, Wisconsin, on September 20, 2007 in Volume 25, Pages 253 to 256 inclusive, as Document No. 719379.

For questions regarding underground utilities please contact:



PHONE: Wisconsin 1 Call center 1 (800) 242-8511

NOTE: Title Policy

As of the date of this survey, no title policy was provided and this survey was drafted based upon current deeds and its respective information and has been field verified and therefore this Plat of Survey does not guarantee the existence, size and location of any easements, encumbrances, restrictions or other facts that could otherwise be disclosed in a title search or current Title Policy.

I HEREBY CERTIFY THAT I HAVE SURVEYED THE ABOVE DESCRIBED PROPERTY AND IN MY PROFESSIONAL OPINION THE ABOVE MAP IS A TRUE REPRESENTATION THEREOF AND SHOWS THE SIZE AND LOCATION OF THE PROPERTY, ITS EXTERIOR BOUNDARIES, AND ROADWAYS.

THIS SURVEY IS MADE FOR THE EXCLUSIVE USE OF THE
PRESENT OWNERS OF THE PROPERTY, AND ALSO THOSE
WHO PURCHASE, MORTGAGE OR GUARANTEE THE TITLE
THERETO. THIS SURVEY COMPLIES WITH WISCONSIN
ADMINISTRATIVE CODE AE-7 EXCEPT FOR THOSE ITEMS
WAIVED, IF ANY, AND IS BOUND BY WISCONSIN STATE
STATUTE 893.37 THAT DEFINES STATUTE OF LIMITATIONS
IN REGARDS TO SURVEYS.


Rick R. Hillmann S-3005

Dated this 17th Day
of SEPTEMBER, 2013.

CLIENT:
Norm Seeger
2183 Country Club Lane,
East Troy Wisconsin 53120

PROPERTY ADDRESS:
2183 Country Club Lane,
East Troy Wisconsin 53120

PARCEL INFO:
TAX KEY NUMBER: PA408200004
SURVEY NO.: 20130816_PLS0002
PROJECT NO.: 20130816_PLS0002

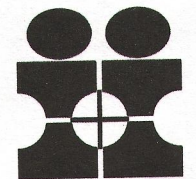


INTERLINE SURVEYING SERVICES

A CONTINENTAL SURVEYING SERVICES LLC Company
Doing Business As INTERLINE SURVEYING SERVICES

Our "X"s Protecting your Frontier

4810 S. 76TH STREET SUITE 104
GREENFIELD, WI. 53220
PHONE (414) 425-2060
Website: www.iss-surveys.com
Email: survey@iss-surveys.com

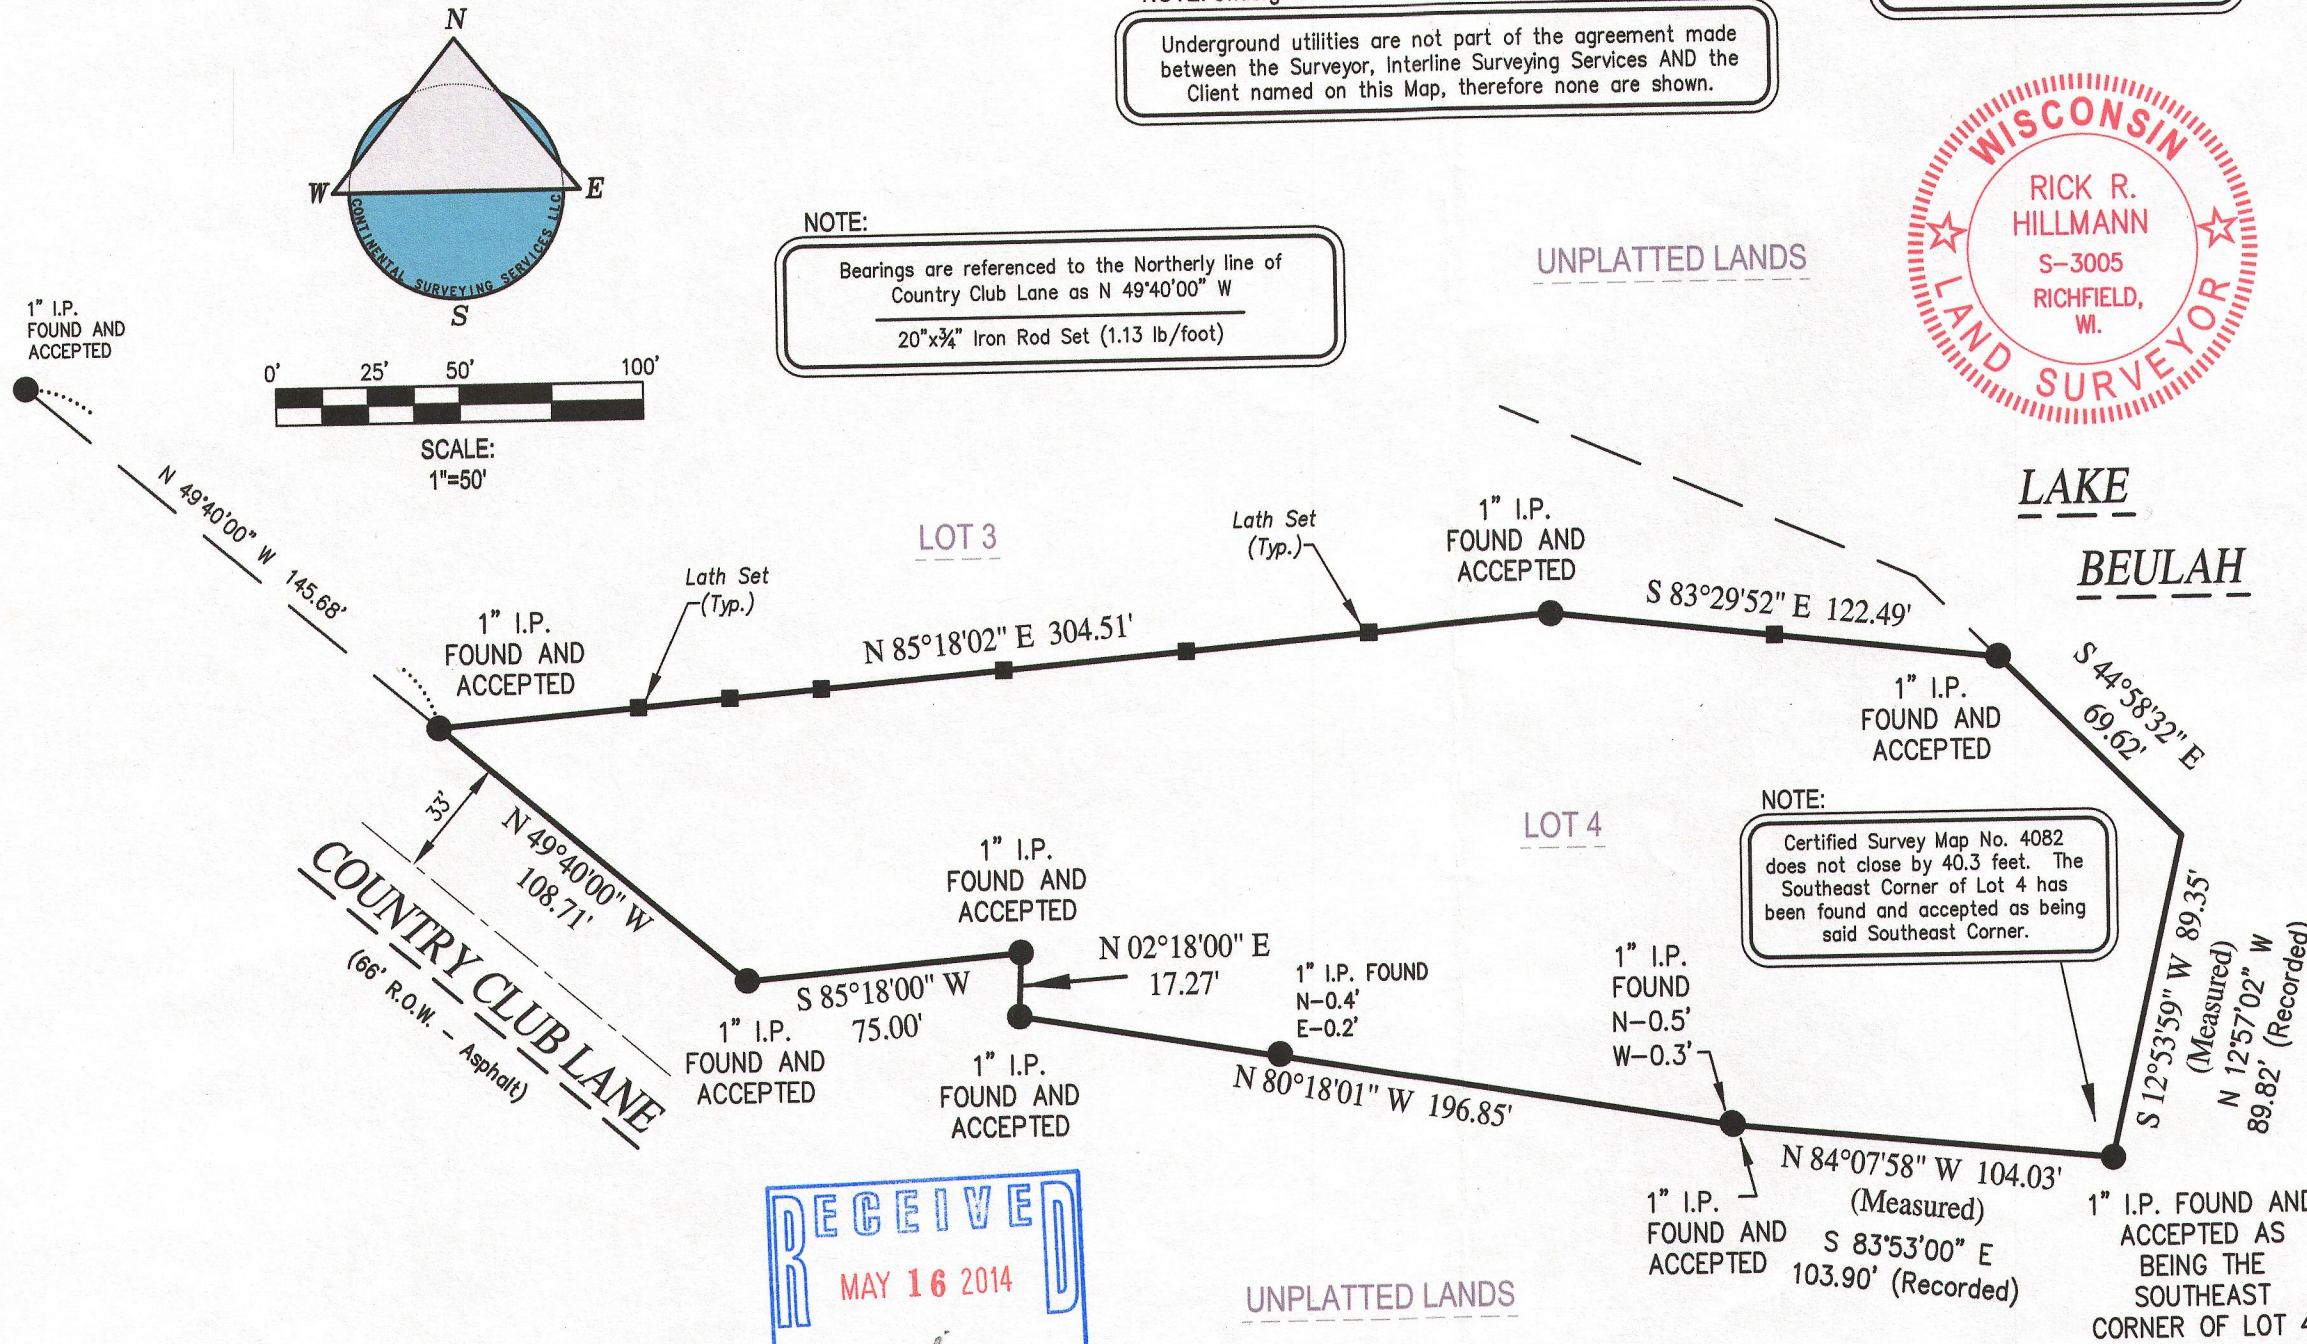

PA 4082-4

418-2408