
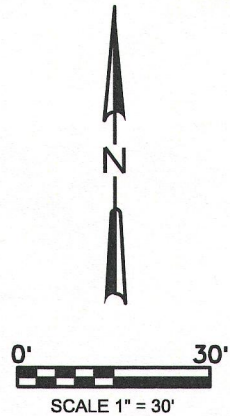


PLAT OF SURVEY


DESCRIPTION:
BEING PART OF THE PLAT OF WILLIAMS PARK LOCATED
IN THE SE, OF THE NW, OF SECTION 4, TOWNSHIP 4
NORTH, RANGE 18 EAST, TOWN OF EAST TROY, WALWORTH
COUNTY, WISCONSIN, COMMENCING AT A POINT MARKED
"C" ON SAID PLAT; THENCE S87°45'W, A DISTANCE OF
153.7'± TO A POINT; THENCE N36°20'W, A DISTANCE
OF 72'± TO THE POINT OF BEGINNING; THENCE
N35°30'22"W, A DISTANCE OF 74.86' TO A POINT;
THENCE S49°25'00"W, A DISTANCE OF 344.54' TO A
POINT ON THE MEANDER LINE OF MILL LAKE; THENCE
WITH SAID MEANDER LINE S37°07'01"E, A DISTANCE OF
75.00' TO A POINT; THENCE LEAVING SAID MEANDER
LINE N49°22'01"E, A DISTANCE OF 342.45' TO THE
POINT OF BEGINNING.

SAID PARCEL CONTAINS 0.6023 ACRES MORE OR LESS
AND INCLUDES LANDS BETWEEN SAID MEANDER LINE AND
THE SHORE OF MILL LAKE.

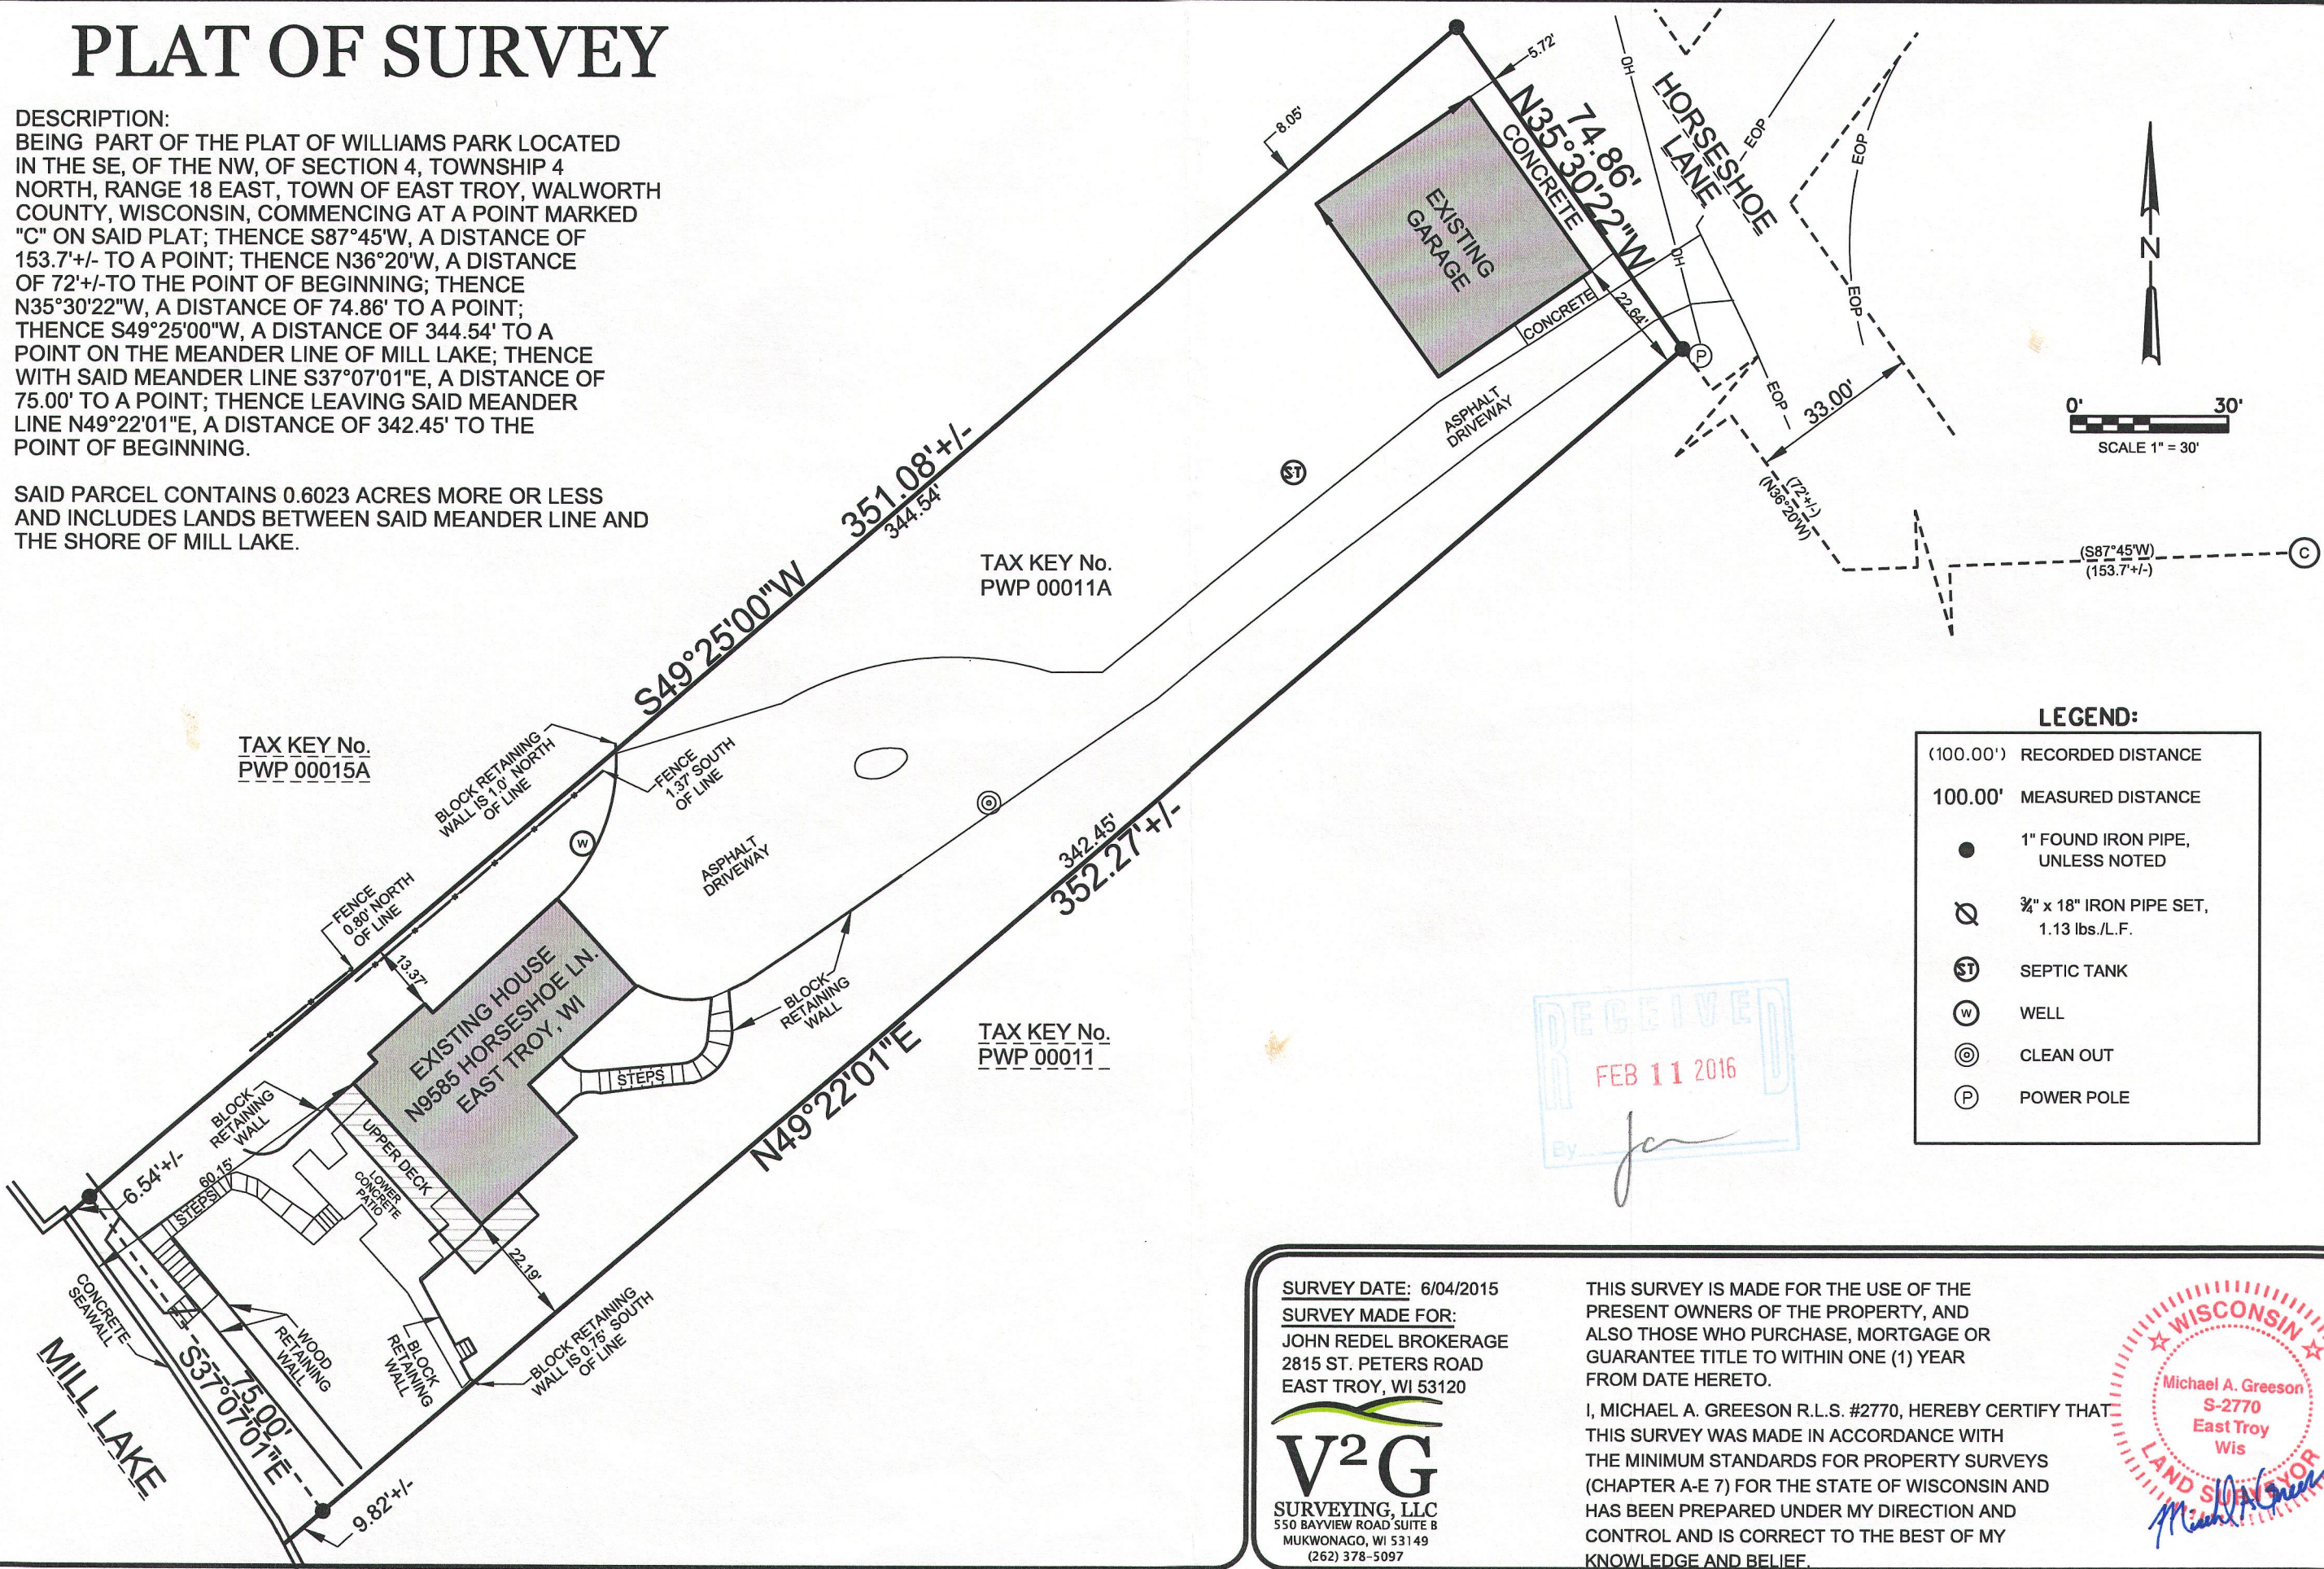

LEGEND:

- (100.00') RECORDED DISTANCE
- 100.00' MEASURED DISTANCE
- 1" FOUND IRON PIPE, UNLESS NOTED
- ⊘ ¾" x 18" IRON PIPE SET, 1.13 lbs./L.F.
- ⊙ SEPTIC TANK
- ⊙ WELL
- ⊙ CLEAN OUT
- ⊙ POWER POLE

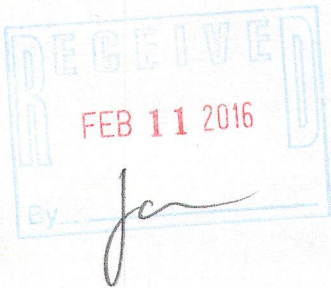

SURVEY DATE: 6/04/2015
SURVEY MADE FOR:
JOHN REDEL BROKERAGE
2815 ST. PETERS ROAD
EAST TROY, WI 53120

V²G
SURVEYING, LLC
550 BAYVIEW ROAD SUITE 8
MUKWONAGO, WI 53149
(262) 378-5097

THIS SURVEY IS MADE FOR THE USE OF THE
PRESENT OWNERS OF THE PROPERTY, AND
ALSO THOSE WHO PURCHASE, MORTGAGE OR
GUARANTEE TITLE TO WITHIN ONE (1) YEAR
FROM DATE HERETO.

I, MICHAEL A. GREESON R.L.S. #2770, HEREBY CERTIFY THAT
THIS SURVEY WAS MADE IN ACCORDANCE WITH
THE MINIMUM STANDARDS FOR PROPERTY SURVEYS
(CHAPTER A-E 7) FOR THE STATE OF WISCONSIN AND
HAS BEEN PREPARED UNDER MY DIRECTION AND
CONTROL AND IS CORRECT TO THE BEST OF MY
KNOWLEDGE AND BELIEF.



V2G JOB#: 2015-053 J REDEL HORSESHOE LANE.DGN PLOT DATE: 6/4/2015

PWP-15A 418-2482