


PLAT OF SURVEY

DESCRIPTION:
 LOTS 4, 5 AND 6 OF MCGREGOR HIGHLANDS,
 A SUBDIVISION LOCATED IN GOVERNMENT LOT
 2 IN THE SOUTHEAST ¼ OF THE NORTHEAST ¼
 OF FRACTIONAL SECTION 9, IN TOWNSHIP 4
 NORTH, RANGE 18 EAST, TOWN OF EAST
 TROY, WALWORTH COUNTY, WISCONSIN.

SAID PARCEL SUBJECT TO ALL RIGHTS,
 RESERVATIONS, RESTRICTIVE COVENANTS AND
 EASEMENTS EITHER RECORDED OR UNRECORDED.



0' 40'
 SCALE 1" = 40'

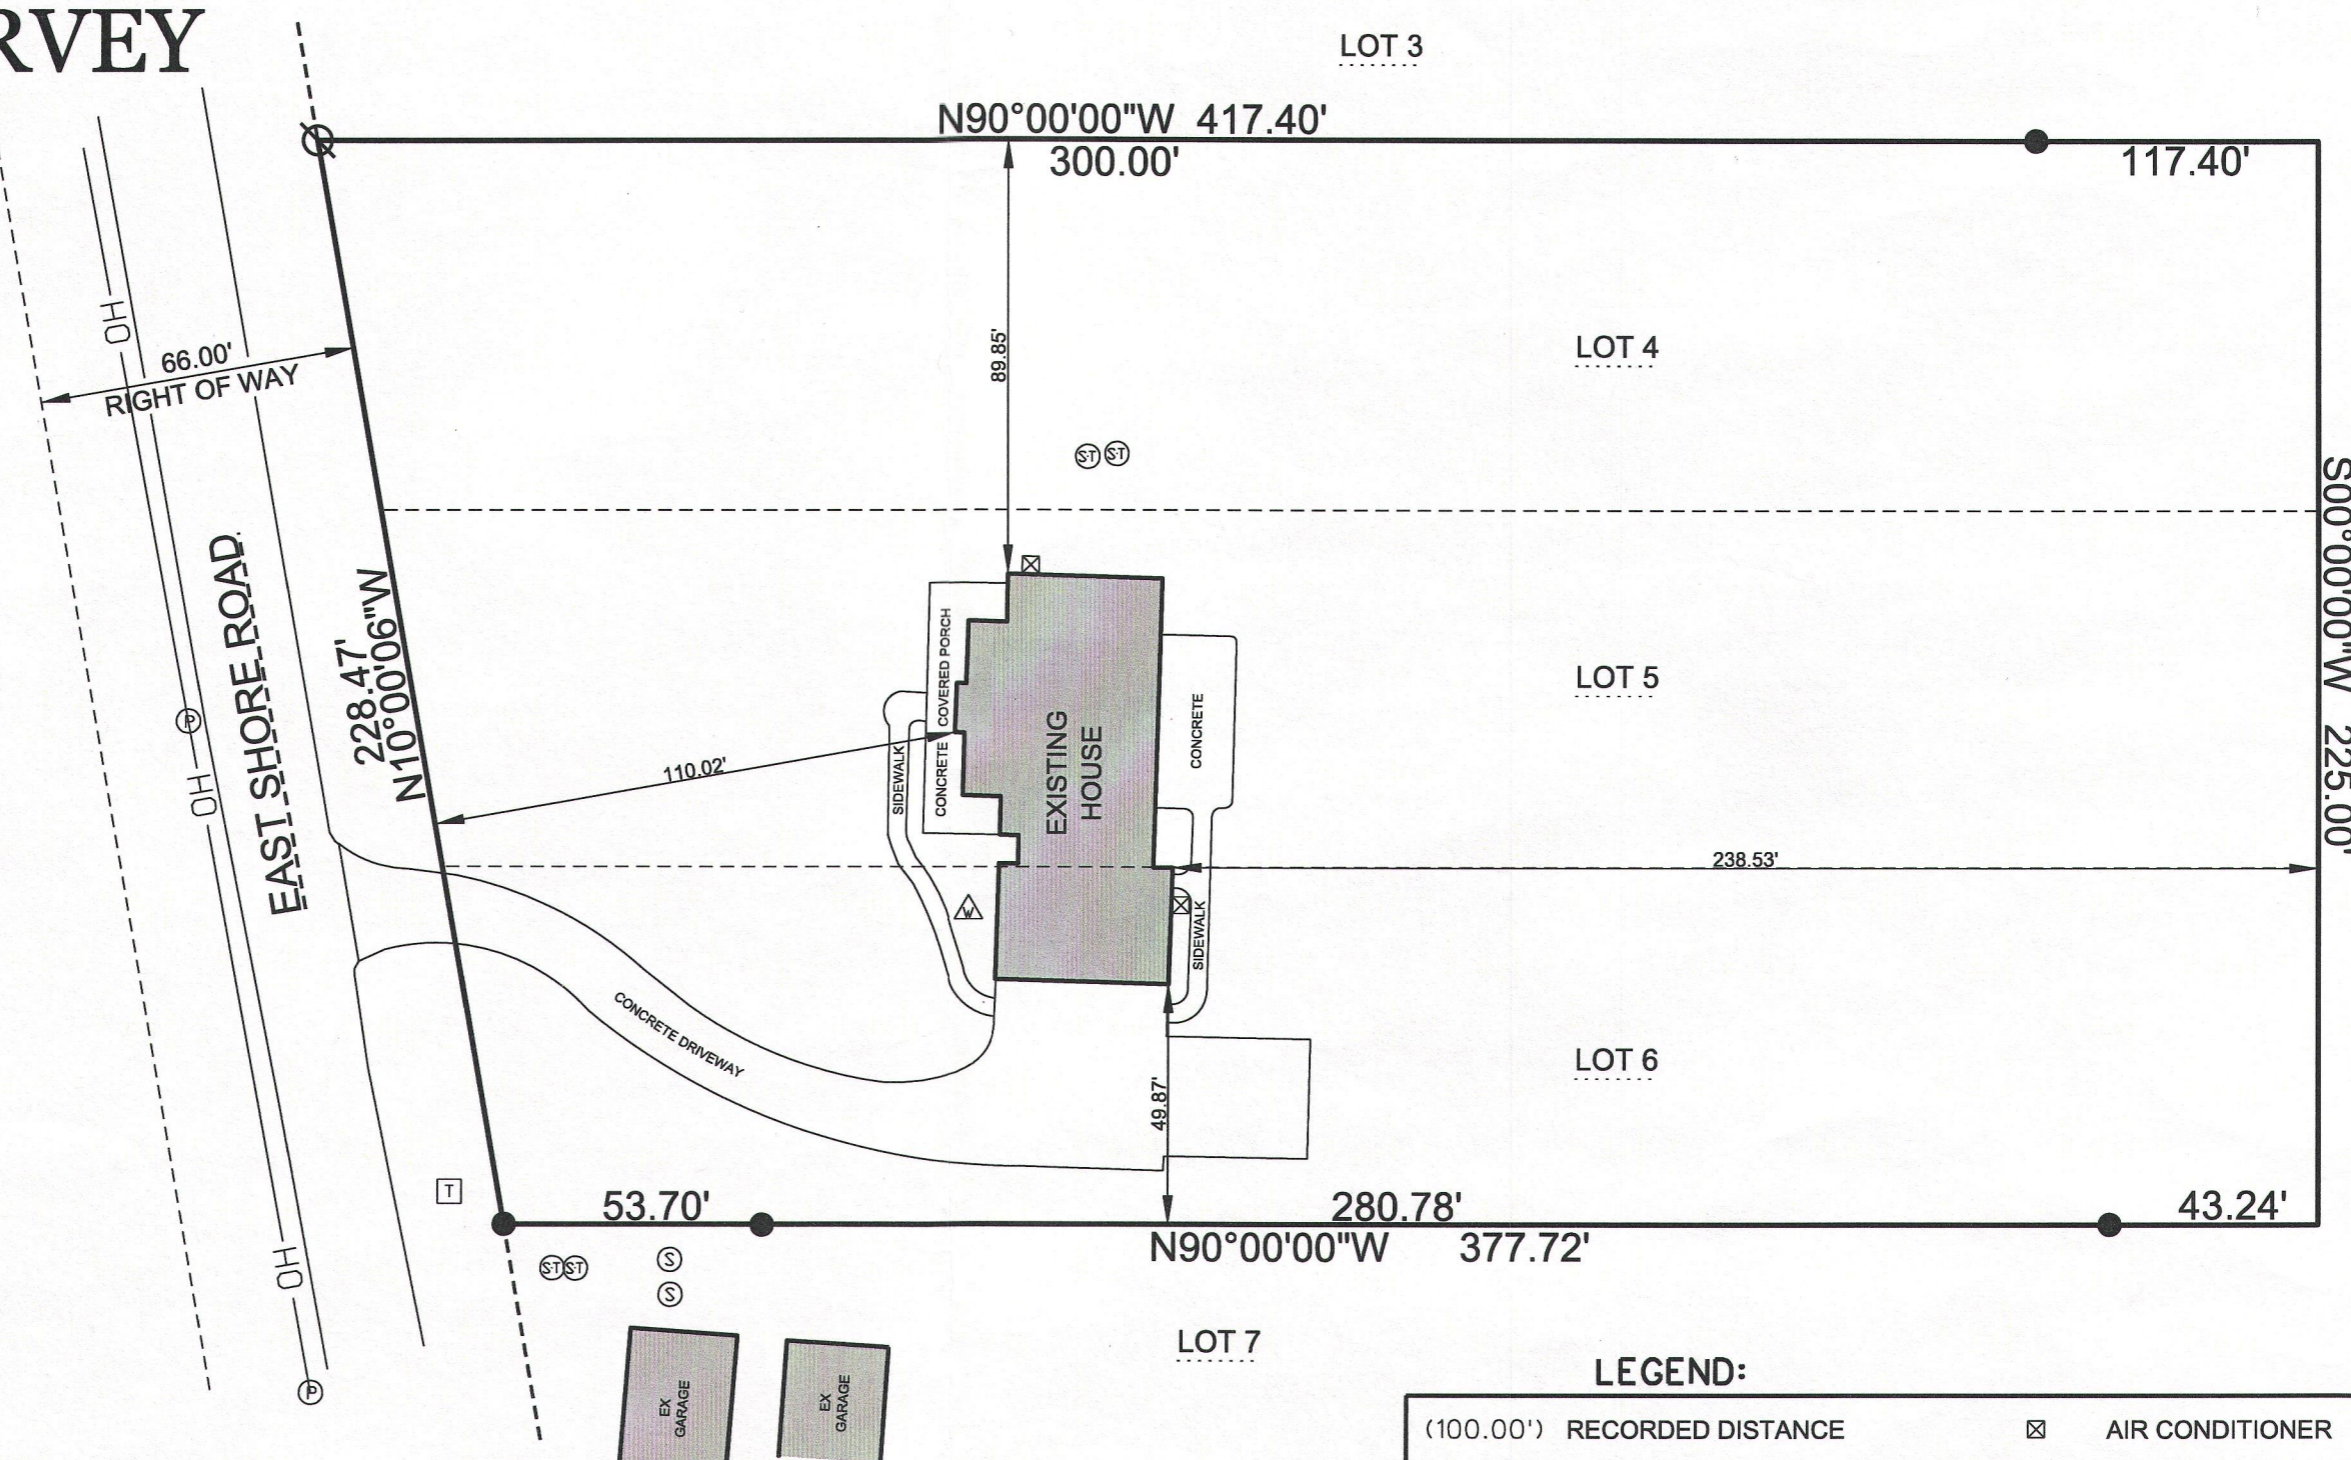


LEGEND:

(100.00')	RECORDED DISTANCE	⊠	AIR CONDITIONER
100.00'	MEASURED DISTANCE	Ⓟ	POWER POLE
●	1" FOUND IRON PIPE, UNLESS NOTED	⚠	WELL
⊗	¾" x 18" IRON PIPE SET, 1.13 lbs./L.F.	Ⓢ	SEPTIC TANK
		Ⓢ	SEPTIC VENT
		Ⓣ	TELEPHONE PEDISTAL

SURVEY DATE: 5/28/2015
 SURVEY MADE FOR:
 JOHN REDEL BROKERAGE
 2815 ST. PETERS ROAD
 EAST TROY, WI 53120

THIS SURVEY IS MADE FOR THE USE OF THE
 PRESENT OWNERS OF THE PROPERTY, AND
 ALSO THOSE WHO PURCHASE, MORTGAGE OR
 GUARANTEE TITLE TO WITHIN ONE (1) YEAR
 FROM DATE HERETO.

I, MICHAEL A. GREESON R.L.S. #2770, HEREBY CERTIFY THAT
 THIS SURVEY WAS MADE IN ACCORDANCE WITH
 THE MINIMUM STANDARDS FOR PROPERTY SURVEYS
 (CHAPTER A-E 7) FOR THE STATE OF WISCONSIN AND
 HAS BEEN PREPARED UNDER MY DIRECTION AND
 CONTROL AND IS CORRECT TO THE BEST OF MY
 KNOWLEDGE AND BELIEF.

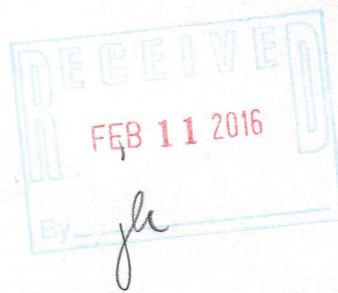

PLOT DATE: 5/28/2015

V2G JOB#: 2015-052

PMGH-4
 PMG

418-2483

FILE NAME: 2015-052 J REDEL WEBER SURVEY E. SHORE RD..DGN