


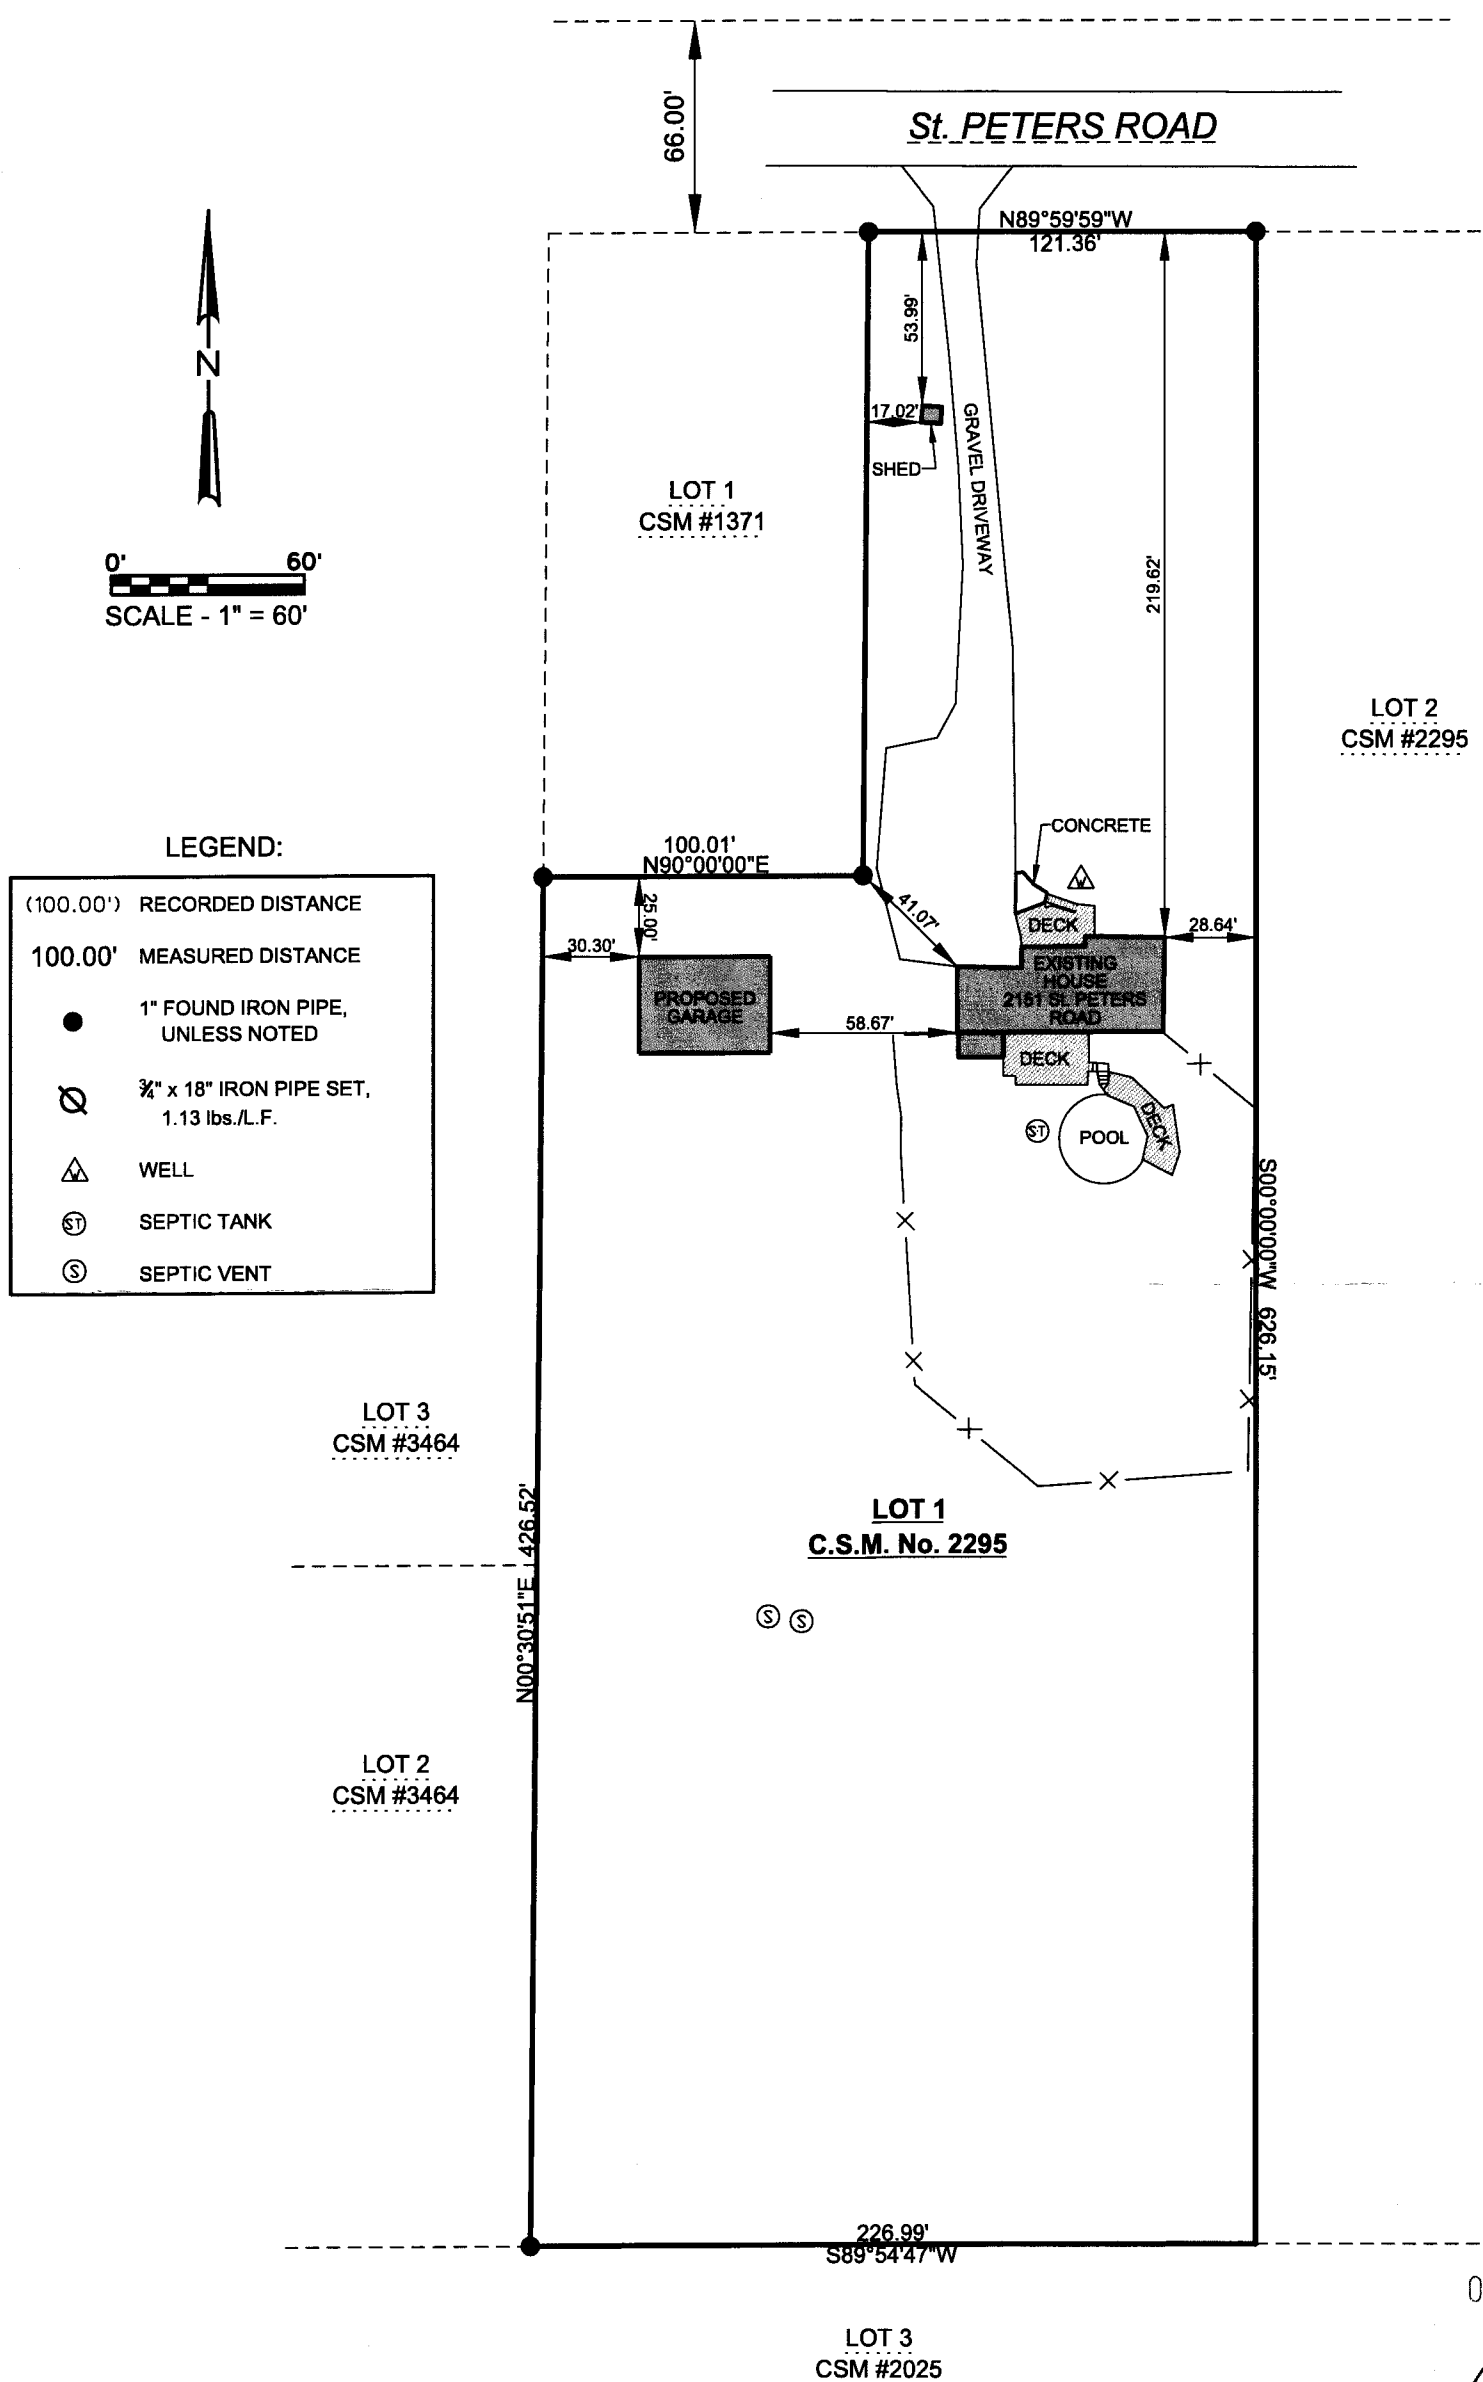

BEING LOT 1 OF CERTIFIED SURVEY MAP No. 2295, LOCATED IN PART OF
THE NORTHEAST ¼ OF THE NORTHEAST ¼ OF SECTION 19, TOWN 4 NORTH,
RANGE 18 EAST, TOWN OF EAST TROY, WALWORTH COUNTY, WISCONSIN.



OCT 31 2016

Jan

 <p>V²G SURVEYING, LLC 550 BAYVIEW ROAD SUITE B MUKWONAGO, WI 53149 (262) 378-5097</p>	<p><u>SURVEY DATE:</u> 7/29/2016</p> <p><u>SURVEY MADE FOR:</u> JEFF BRADLEY 2151 ST. PETERS RD. EAST TROY, WI 53120</p> <p>THIS SURVEY IS MADE FOR THE USE OF THE PRESENT OWNERS OF THE PROPERTY, AND ALSO THOSE WHO PURCHASE, MORTGAGE OR GUARANTEE TITLE TO WITHIN ONE (1) YEAR FROM DATE HERETO.</p> <p>I, MICHAEL A. GREESON R.L.S. #2770, HEREBY CERTIFY THAT THIS SURVEY WAS MADE IN ACCORDANCE WITH THE MINIMUM STANDARDS FOR PROPERTY SURVEYS (CHAPTER A-E 7) FOR THE STATE OF WISCONSIN AND HAS BEEN PREPARED UNDER MY DIRECTION AND CONTROL AND IS CORRECT TO THE BEST OF MY KNOWLEDGE AND BELIEF.</p>	
---	---	---