

PLAT OF SURVEY

PATHFINDER SURVEYING INC.
(formerly)
J.K. SURVEYING INC.
P.O BOX 322
LAKE GENEVA, WI. 53147
WWW.PATHFINDERSURVEYING.NET
262-248-8303

LAKE BEULAH

13.85'

N 82°16'43" E 123.62'
(N 81°25' E 123.47')

patio block

67.35'

concrete monument with cross cut tipped towards lake

3.80'

fence online

vent

shed online

5.20'
11.47'

14.55'

36.37'

28.25'

38.19'

32.70'

10.00'

well

concrete

wood fence

N 13°41'00" W 160.72'
(160.56')

160.72'

7.57'

18.37'

36.18'

36.20'

18.37'

garage

0.63'

asphalt

16.20'

14.55'

S 03°35'00" W 164.91'
(S 03°35' W 164.21')

fence online

17.32'


10.63'

SOUTH SHORE DRIVE

(S 82°23' W 74.51')
S 83°42'09" W 74.63'

LAKE BEULAH

DECEIVED

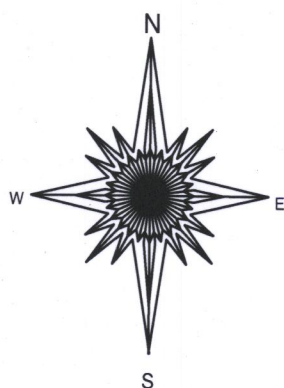

TAX ID # PCT00003

DATED THIS 9TH DAY OF APRIL, 2017.



JEFFREY L KIMPS S-2436
Wisconsin Professional Land Surveyor
(original if signed in red)

418-2558-9228