

# LAND-MARK SURVEYING

Mark L. Miritz

Wisconsin Professional Land Surveyor S-2582



N9330 Knuteson Drive  
Whitewater, WI 53190  
Phone: (262) 495-3284  
MARKMIRITZ@  
LAND-MARKSURVEYING.COM

## SITE PLAN

UNIT 7 OF HIGHLAND VIEW ESTATES CONDOMINIUM,  
LOCATED IN THE WEST 1/2 OF SECTION 17, TOWN  
4 NORTH, RANGE 18 EAST, WALWORTH COUNTY,  
WISCONSIN.

### OWNERS:

ROBERT A. FARRELL TRUST  
JOAN L. FARRELL TRUST  
11252 APACHE VISTAS DRIVE  
SCOTTSDALE, AZ 85262

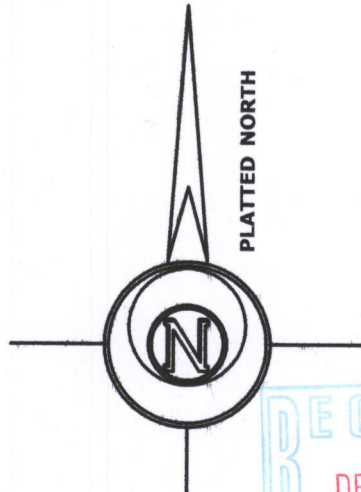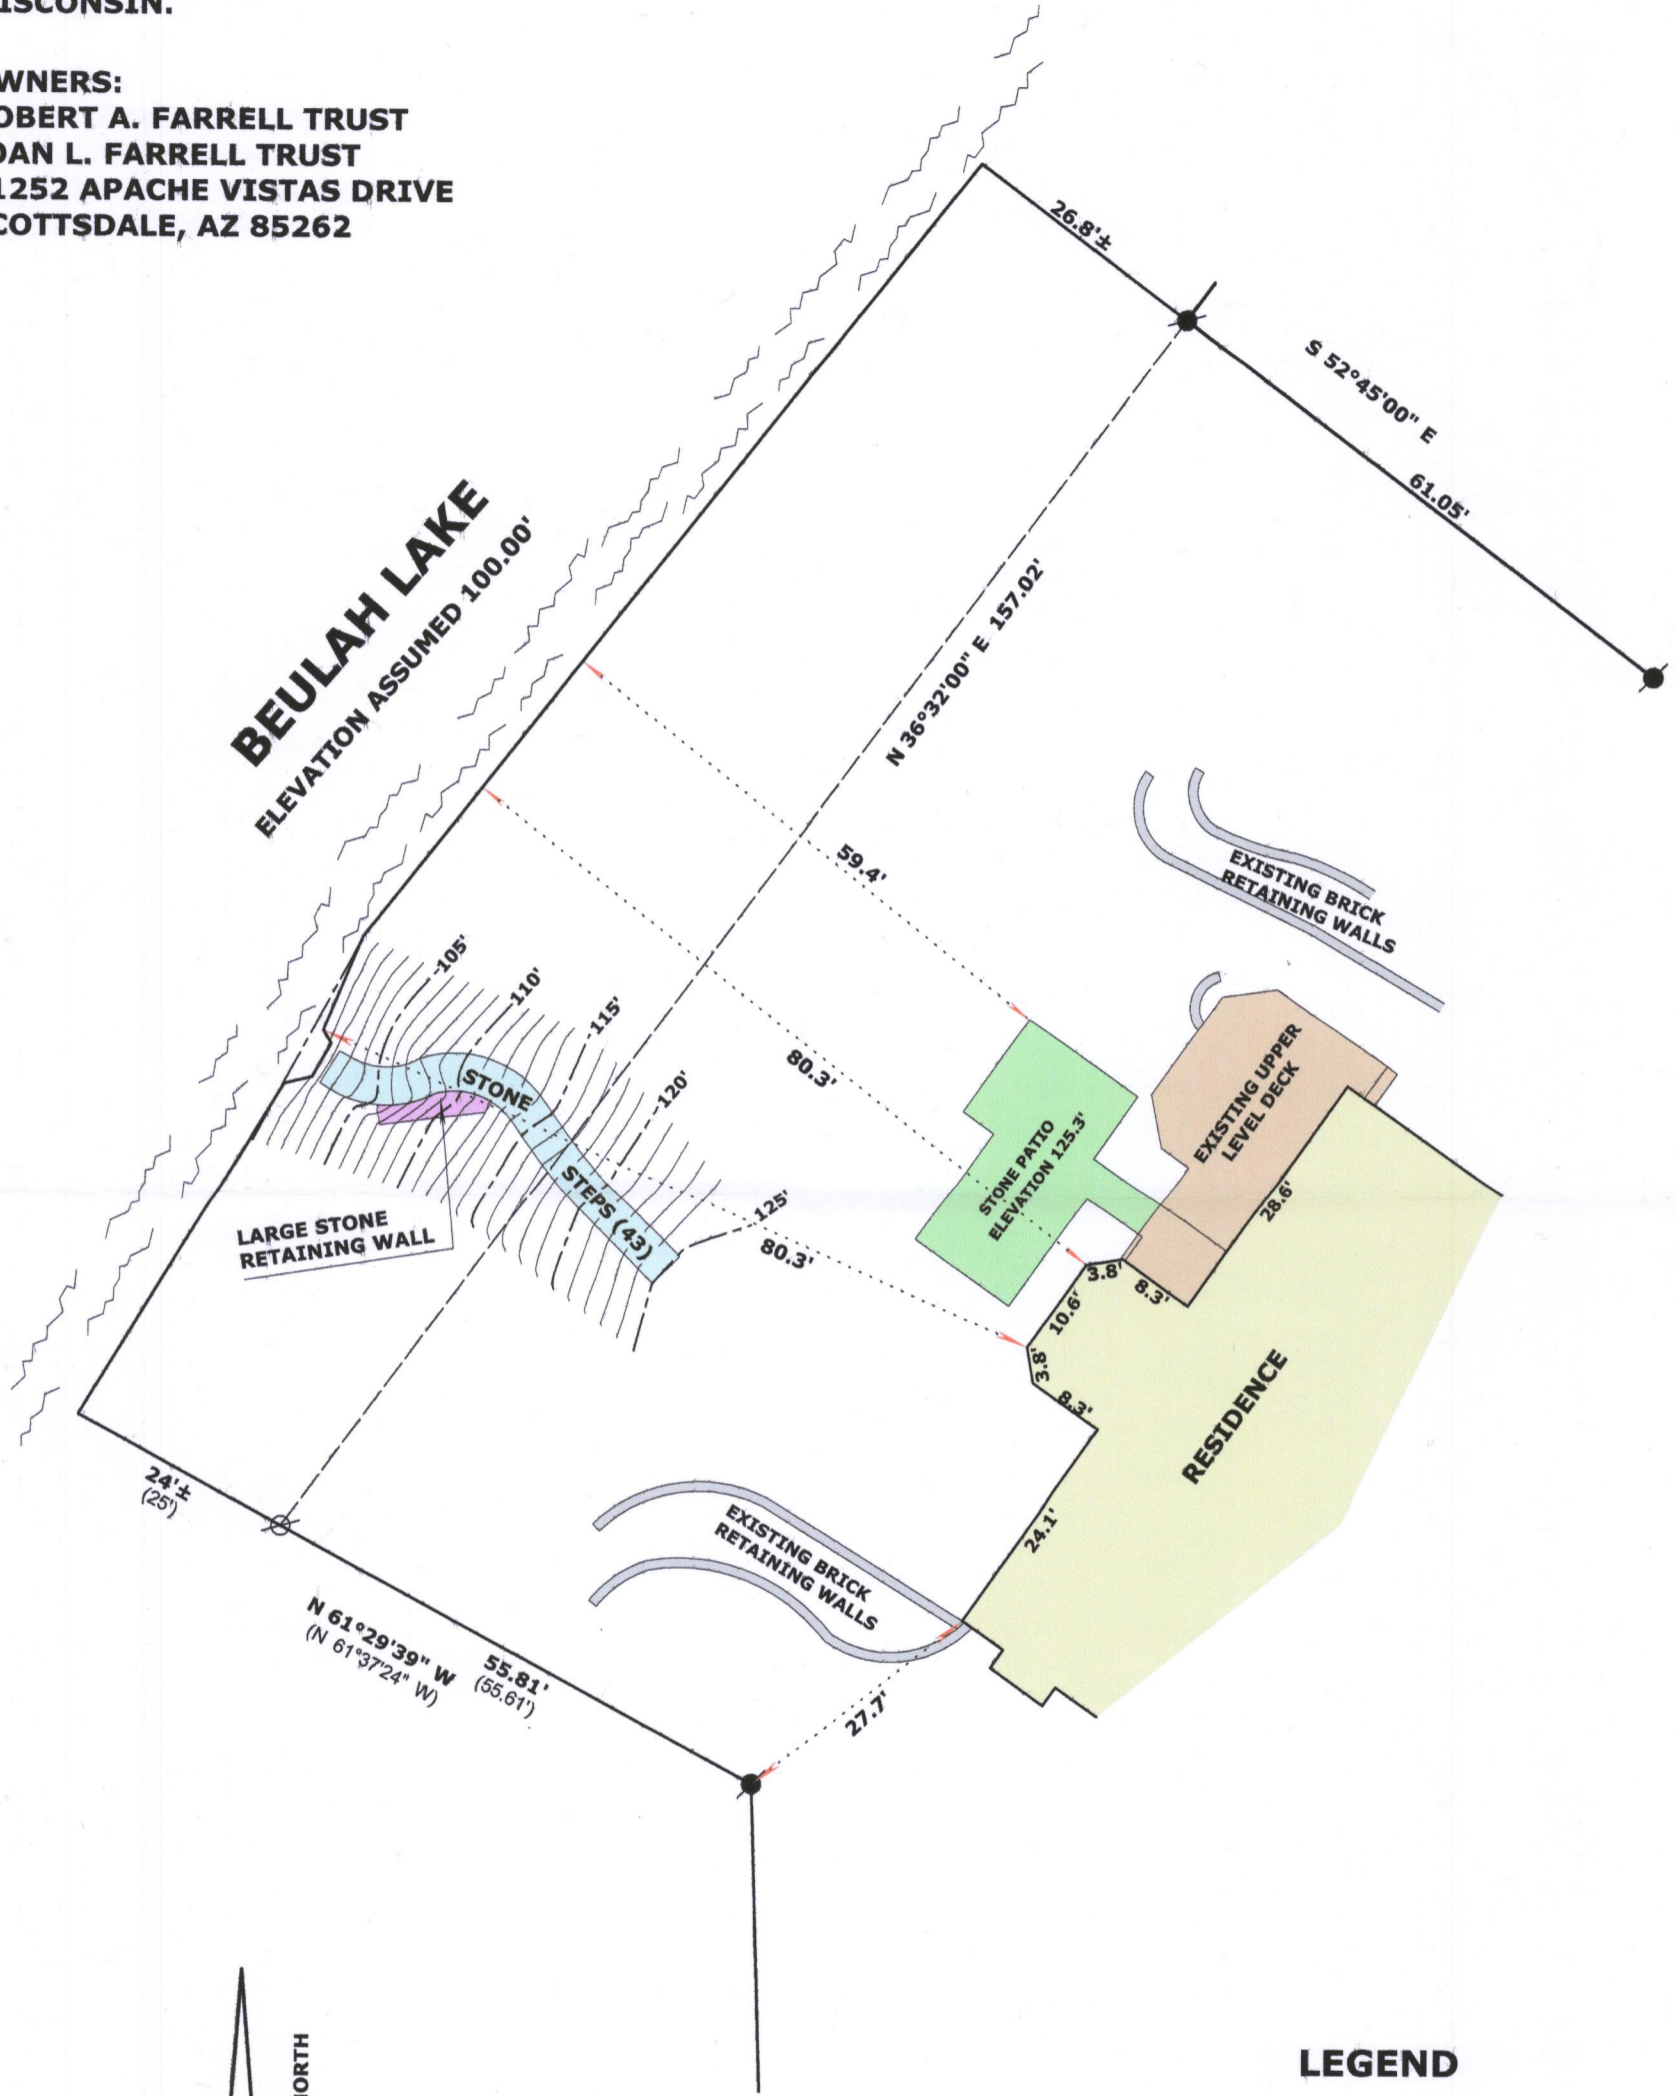

RECEIVED  
DEC 22 2017  
By Jan



### LEGEND

- ⊗ FOUND IRON PIPE
- FOUND IRON ROD
- ( x x ) RECORDED AS DIMENSION

SCALE: 1 INCH = 20 FEET

"I hereby certify that the above described property has been surveyed by me or under my direction and that the above map is correct to the best of my knowledge and belief."

*Mark L. Miritz*  
MARK L. MIRITZ  
WISCONSIN PROFESSIONAL  
LAND SURVEYOR S-2582  
DATE: NOV. 3, 2016 JOB NO. 16.1101

REVISED NOV. 15, 2017 TO SHOW  
RECONSTRUCTED STEPS & PATIO