


# PLAT OF SURVEY

LOT 1, CERTIFIED SURVEY MAP NO. 2655, AS RECORDED IN VOLUME 13 OF CERTIFIED SURVEY MAPS ON PAGE 232-234, BEING A PART OF THE NORTHEAST 1/4 OF THE NORTHWEST 1/4 OF SECTION 13, TOWNSHIP 4 NORTH, RANGE 18 EAST, TOWN OF EAST TROY, WALWORTH COUNTY, WISCONSIN.

SURVEYED FOR: ERIC ANDERSON  
SURVEY ADDRESS: N8900 THIEDE ROAD

NORTHWEST CORNER OF THE NORTHWEST 1/4 OF SECTION 13-4-18

NORTHEAST CORNER OF THE NORTHWEST 1/4 OF SECTION 13-4-18

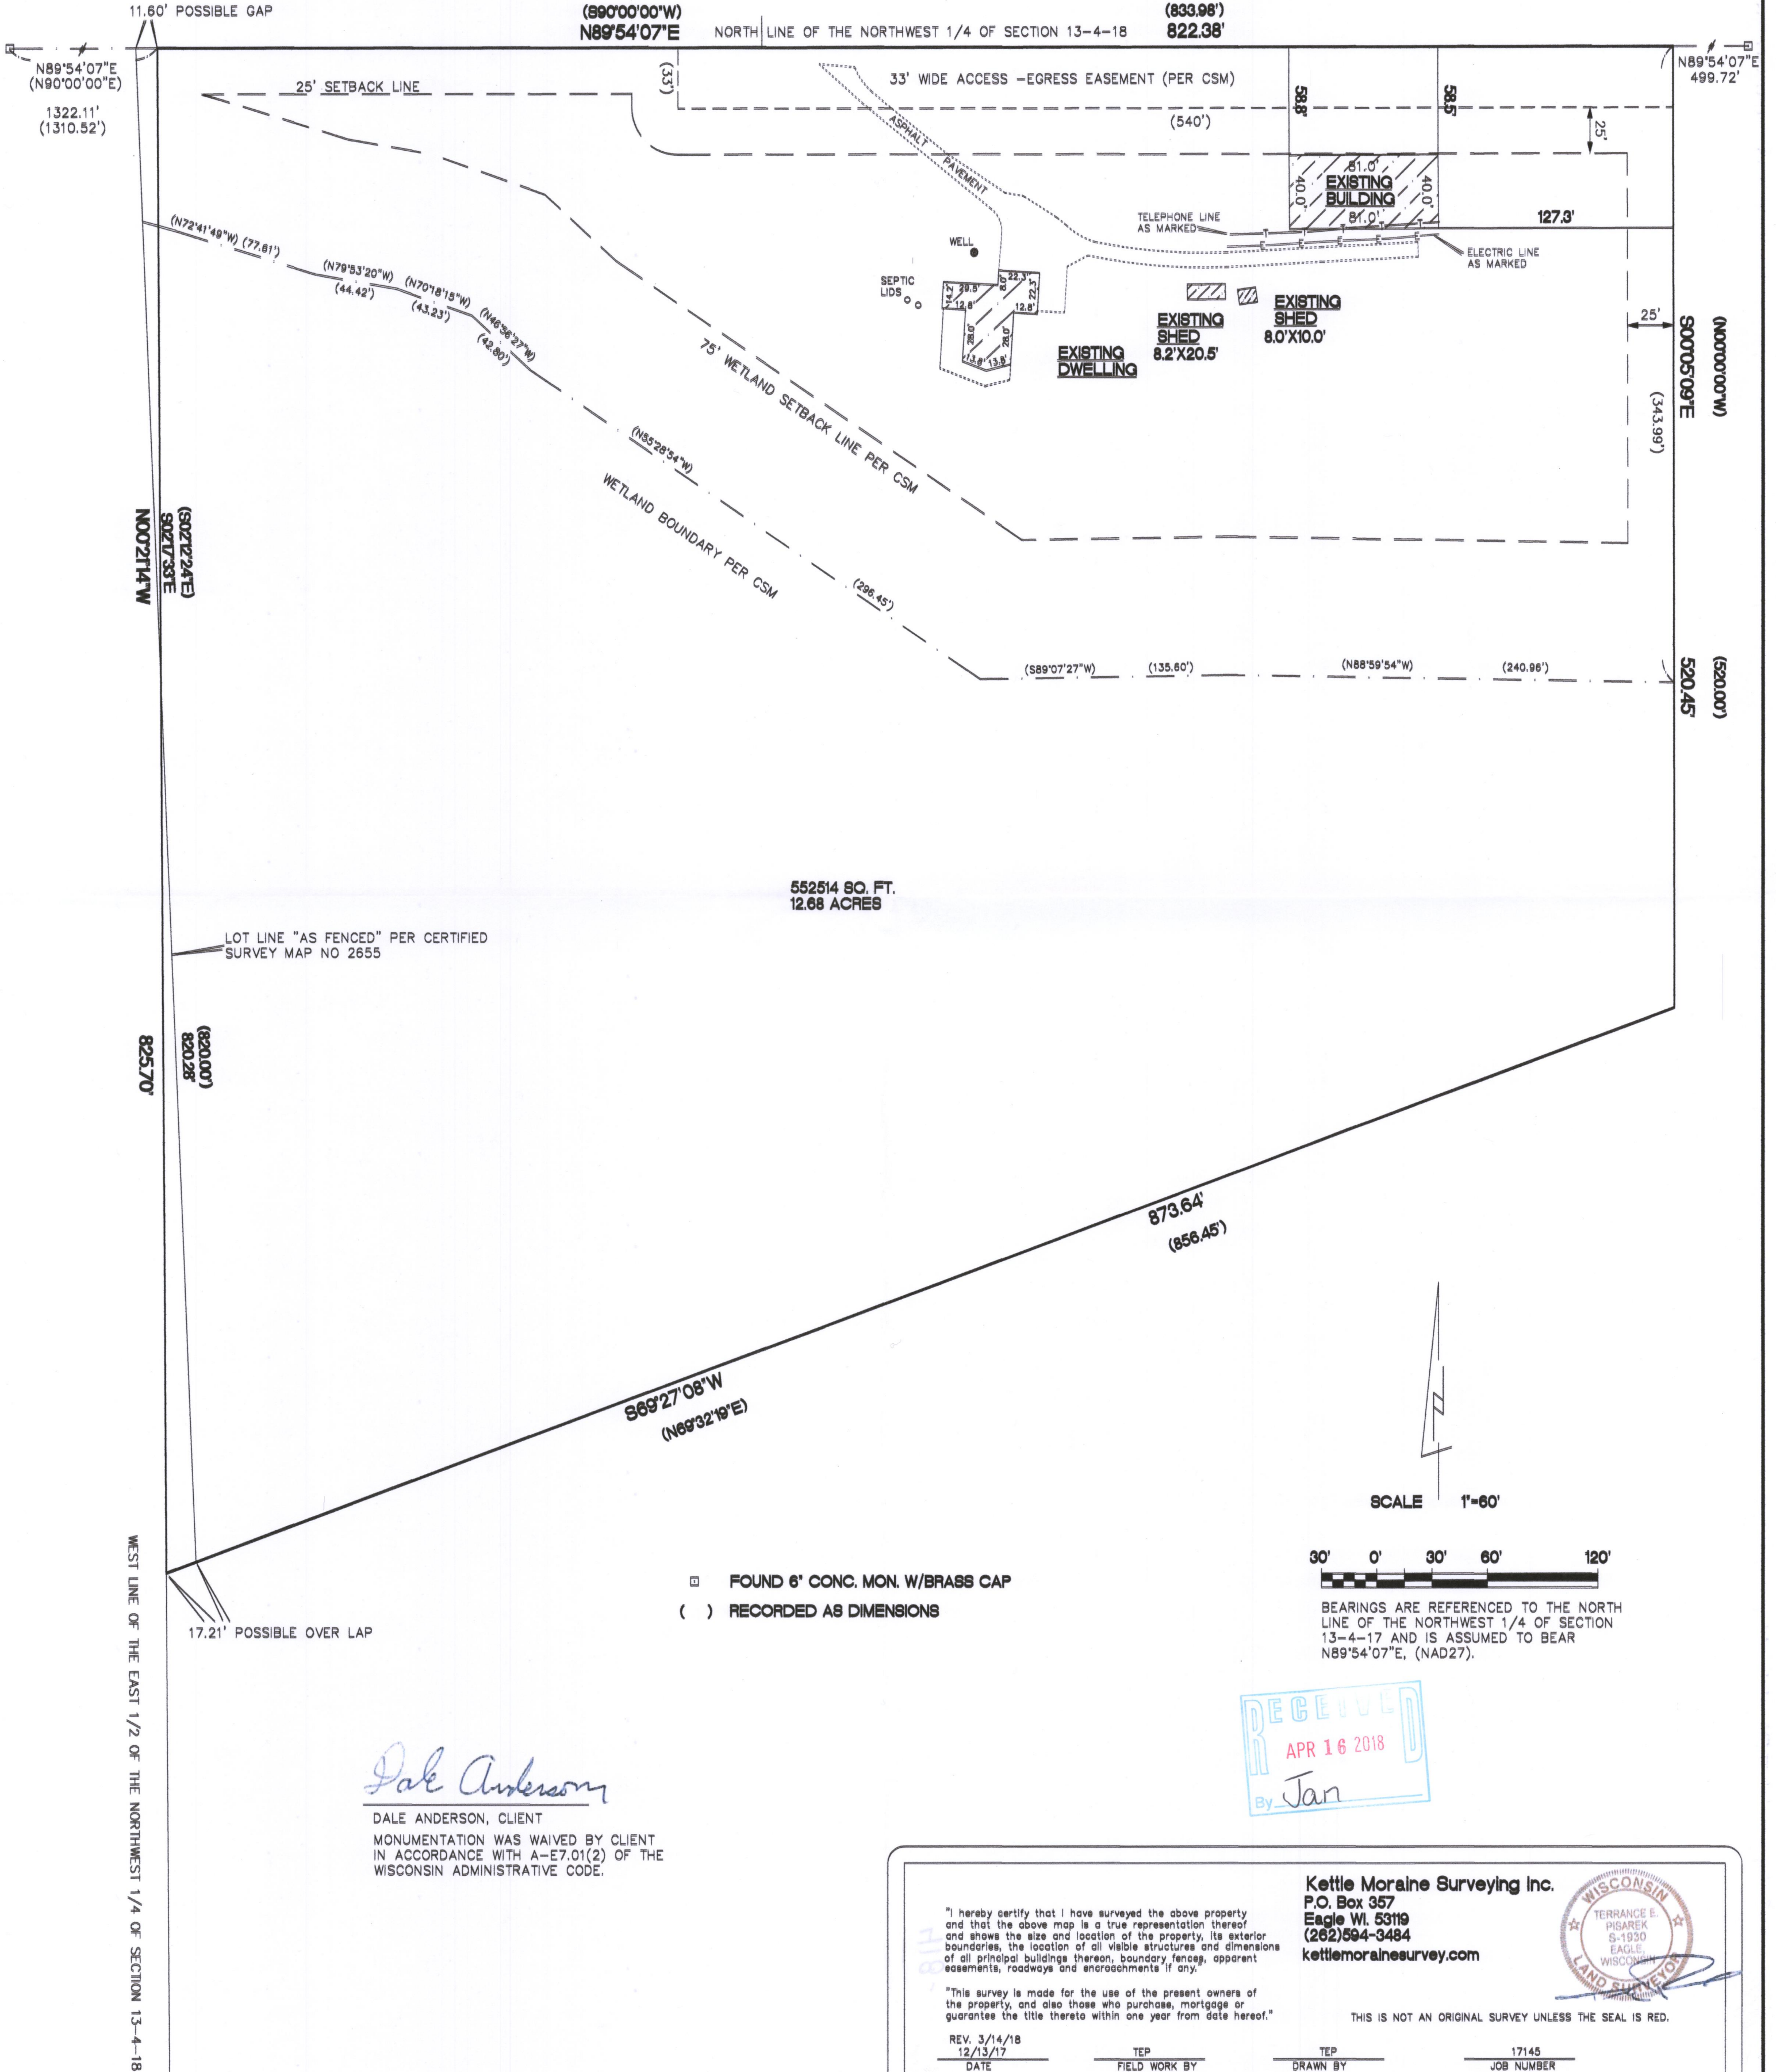

*Dale Anderson*

DALE ANDERSON, CLIENT  
MONUMENTATION WAS WAIVED BY CLIENT IN ACCORDANCE WITH A-E7.01(2) OF THE WISCONSIN ADMINISTRATIVE CODE.

RECEIVED  
APR 16 2018  
By Jan

<p>"I hereby certify that I have surveyed the above property and that the above map is a true representation thereof and shows the size and location of the property, its exterior boundaries, the location of all visible structures and dimensions of all principal buildings thereon, boundary fences, apparent easements, roadways and encroachments if any."</p> <p>"This survey is made for the use of the present owners of the property, and also those who purchase, mortgage or guarantee the title thereto within one year from date hereof."</p>		<p>Kettle Moraine Surveying Inc. P.O. Box 357 Eagle WI. 53119 (262)594-3484 kettlemorainesurveying.com</p>	
<p>REV. 3/14/18 12/13/17 DATE</p>	<p>TEP FIELD WORK BY</p>	<p>TEP DRAWN BY</p>	<p>17145 JOB NUMBER</p>

THIS IS NOT AN ORIGINAL SURVEY UNLESS THE SEAL IS RED.

PA2655-1

410-2594