


Plat of Survey
LOT 15, IN SHOREWOOD, being a Subdivision of a part of the Southeast ¼ and the Southwest ¼ of Section 11, and the Northwest ¼ of Section 14, and the Northeast ¼ of Section 15, Town 4 North, Range 18 East, in the Town of East Troy, Walworth County, Wisconsin.
Surveyed for: Nathan Ansell
Survey address: W848 Shorewood dr.

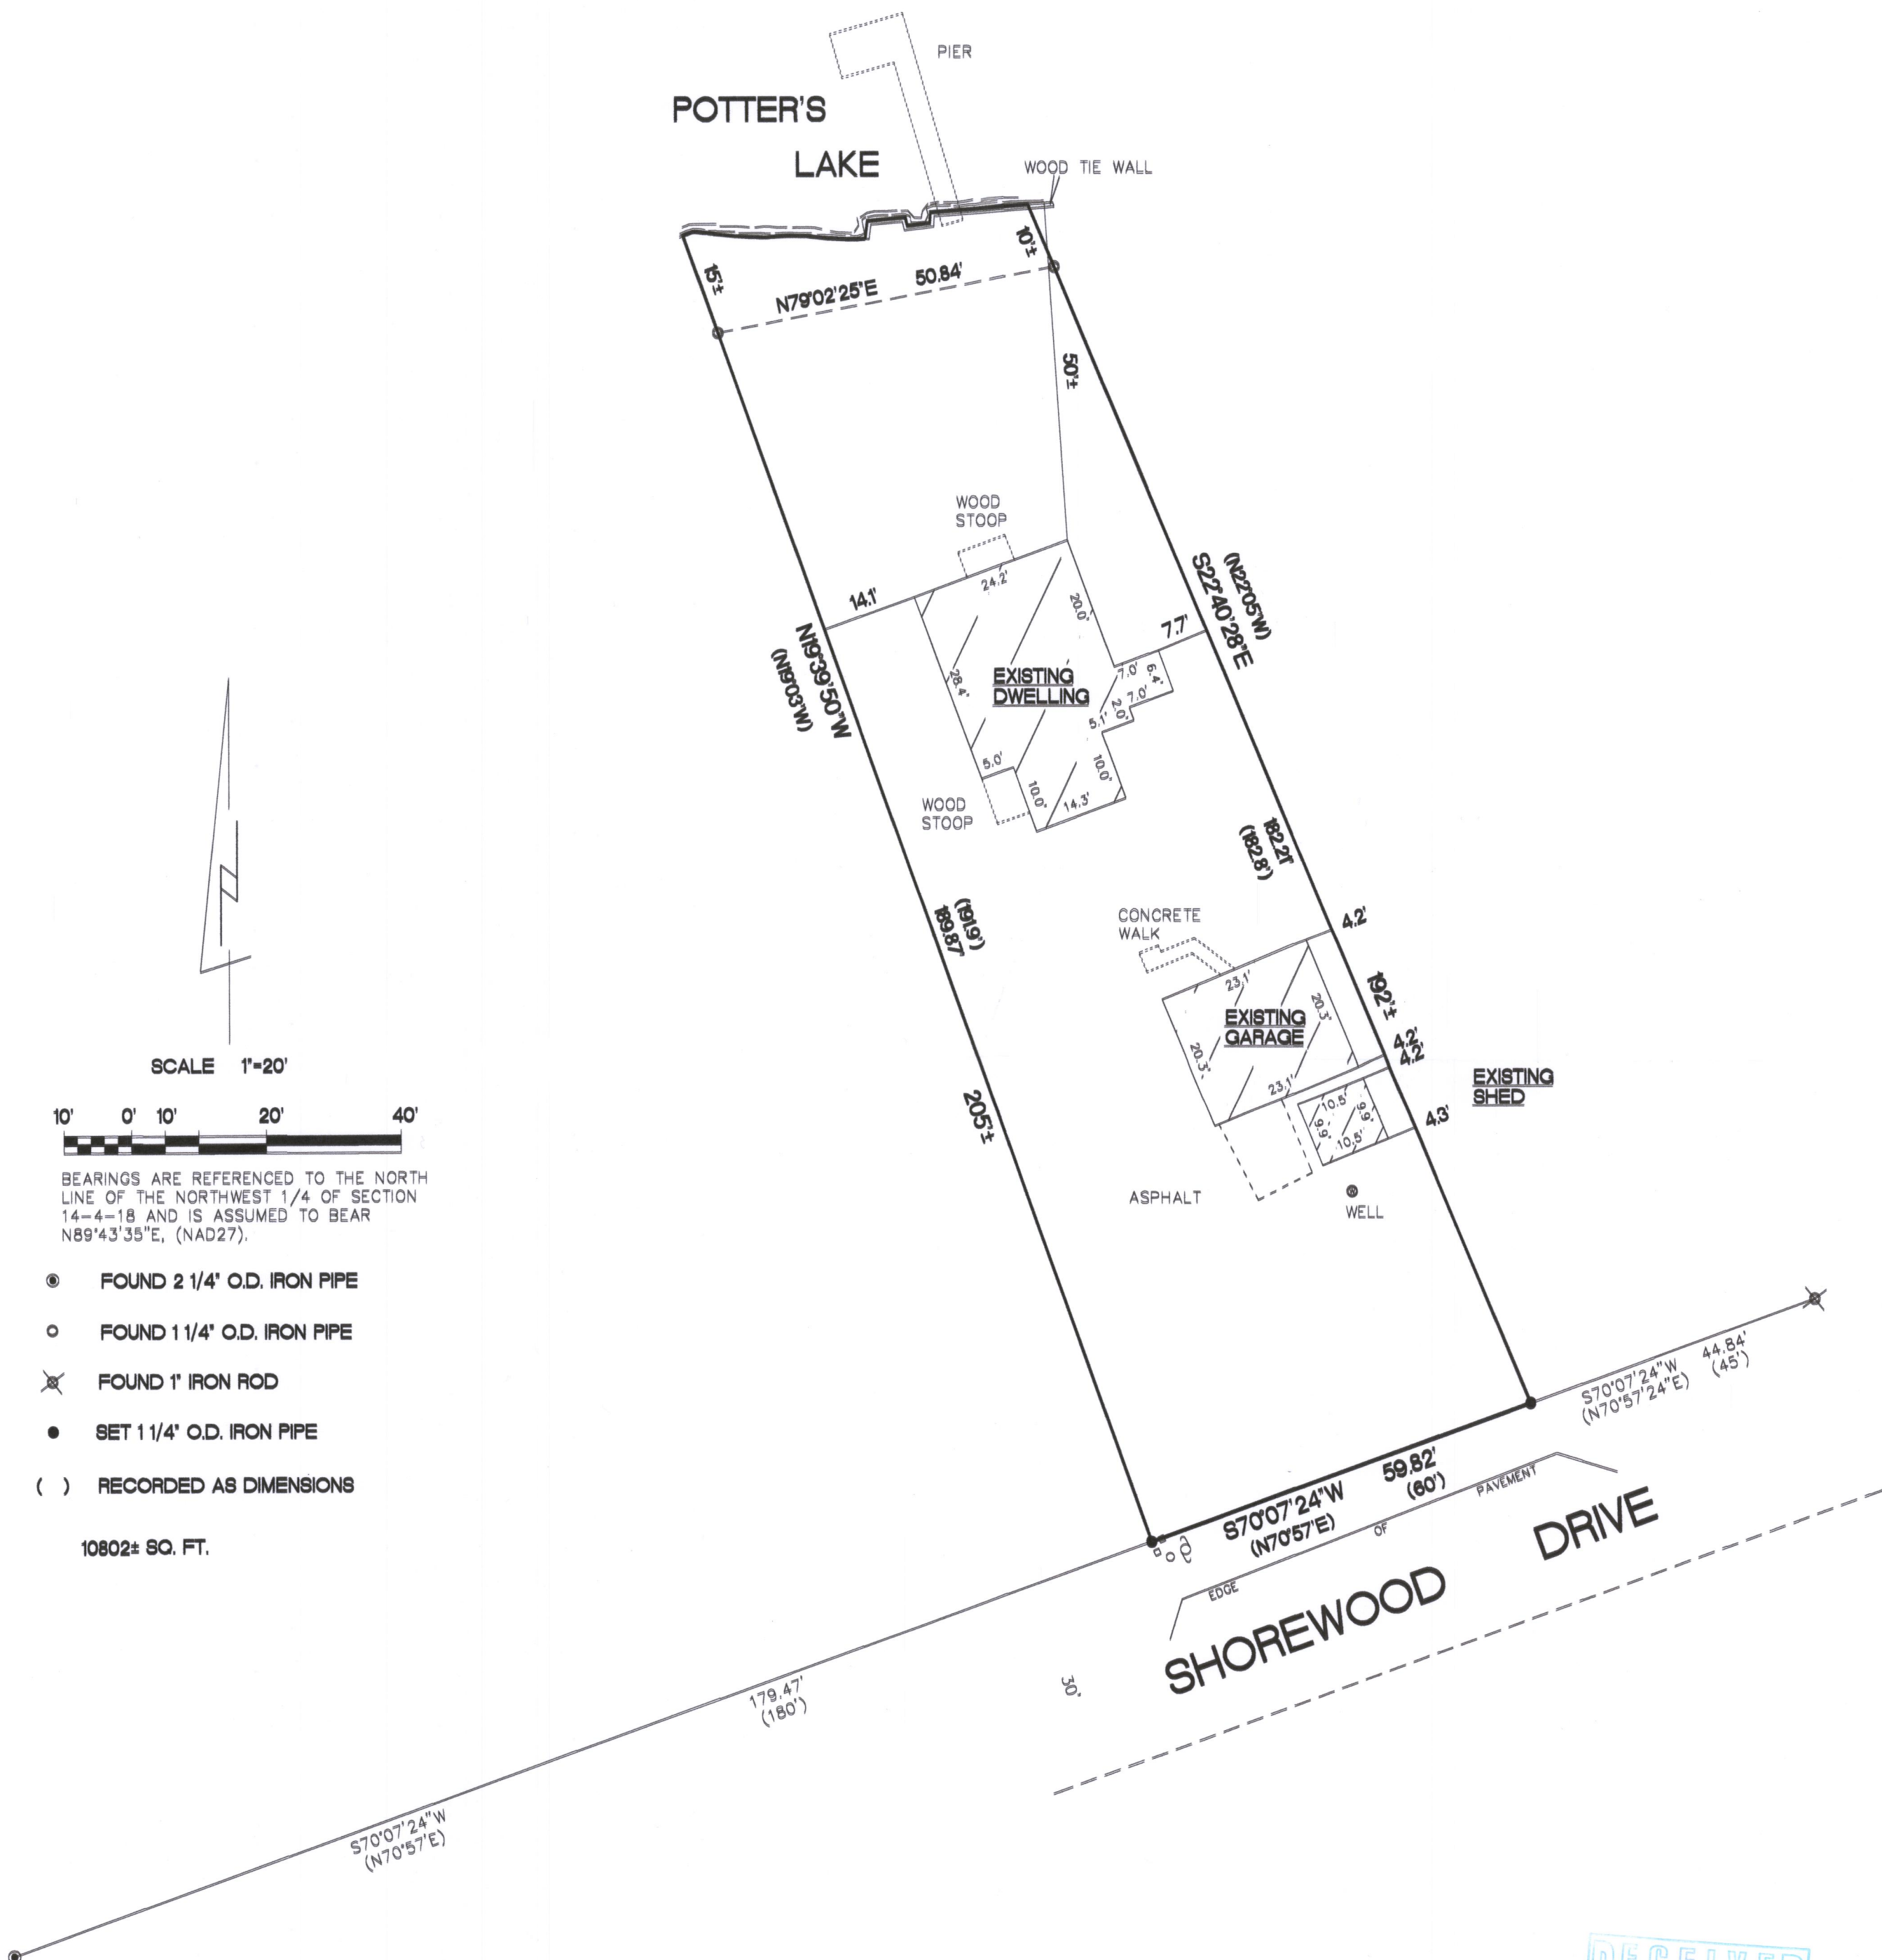

SCALE 1"=20'

10' 0' 10' 20' 40'

BEARINGS ARE REFERENCED TO THE NORTH LINE OF THE NORTHWEST 1/4 OF SECTION 14-4-18 AND IS ASSUMED TO BEAR N89°43'35"E, (NAD27).

- FOUND 2 1/4" O.D. IRON PIPE
- FOUND 1 1/4" O.D. IRON PIPE
- ✕ FOUND 1" IRON ROD
- SET 1 1/4" O.D. IRON PIPE
- () RECORDED AS DIMENSIONS

10802± SQ. FT.

RECEIVED
AUG 22 2018
By Jan

"I hereby certify that I have surveyed the above property and that the above map is a true representation thereof and shows the size and location of the property, its exterior boundaries, the location of all visible structures and dimensions of all principal buildings thereon, boundary fences, apparent easements, roadways and encroachments if any.

"This survey is made for the use of the present owners of the property, and also those who purchase, mortgage or guarantee the title thereto within one year from date hereof."

4/24/18
DATE

TEP
FIELD WORK BY

TEP
DRAWN BY

18042
JOB NUMBER

Kettle Moraine Surveying Inc.
P.O. Box 357
Eagle WI. 53119
(262)594-3484
kettlemorainesurveying.com

WISCONSIN
TERRANCE E. PISAREK
S-1930
EAGLE, WISCONSIN
LAND SURVEYOR

THIS IS NOT AN ORIGINAL SURVEY UNLESS THE SEAL IS RED.

ps-15 418-2622