


Plat of Survey

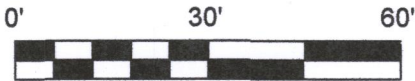

Property Description:
Lots 1 of Certified Survey Map NO. 1107 according to the recorded plat thereof,
recorded in Volume 5 of Certified Surveys on Page 120, as Document NO.
65801, located in the Northwest 1/4 of Section 4, Township 4 North, Range 18
East, Town of East Troy, Walworth County, Wisconsin.

PREPARED FOR:
Pete Hoffmann
W1652 County Road J
Mukwonago, WI, 53149

BEARINGS ARE REFERENCED TO
THE SOUTHERLY LINE CSM 1107
LOT 1 BEARS S 55°59'36" W


LEGEND

- 3/4"x18" SOLID IRON ROD SET
1.50Lbs./LINEAL FOOT.
- IRON PIPE FOUND AS NOTED
(Measured Outside Diam.)
- () INDICATES RECORDED AS
DISTANCES ARE MEASURED TO THE
NEAREST HUNDREDTH OF A FOOT.

Notes:

1. Building dimensions and associated
offset distances were measured along
the outside of the structure wall,
ground level.
2. This parcel may be subject to, or
benefit from, Easements or
agreements, written or otherwise, not
shown hereon.
3. Field work completed on 10-10-19.
4. Dam Failure Shadow Elev.= 810.82'


UNPLATTED LANDS

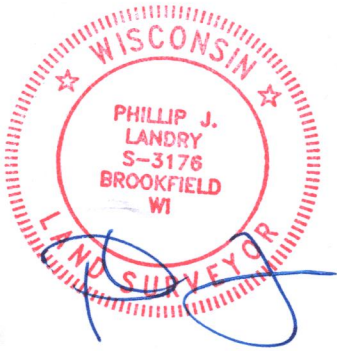

SURVEYOR'S CERTIFICATE

I, Phillip J. Landry, professional land surveyor for C3E Geomatics LLC,
hereby certify that we surveyed the property described above and that the map
is a true representation thereof and shows the size and location of the property,
it's exterior boundaries. Said survey meets the minimum standards for
property surveys of the Wisconsin Administrative Code (A-E7) and the map
hereon is correct to the best of my knowledge and belief. This Survey is solely
for the use of the present owners of the property at the date below.

Dated this 21st Day of October, 2019: Phillip J. Landry S-3176

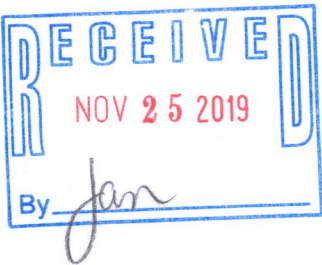

18575 Brookfield Lake Drive • Unit 61
Brookfield, WI 53045 • (262) 312-1034
c3egeomatics.com

Job# 19236

PA1107-1

418-2670