PLAT OF SURVEY

LOCATION:


Hidden Oaks Drive, East Troy, Wisconsin

LEGAL DESCRIPTION:

Lot 6 in HIDDEN OAKS, being a part of the Northeast 1/4 and Southwest 1/4 of the Southwest 1/4 of Section 3, Town 4 North, Range 18 East, Town of East Troy, Walworth County, Wisconsin.

December 26, 2019 April 7, 2020 Staked Proposed Garage

Survey No. 110627-B

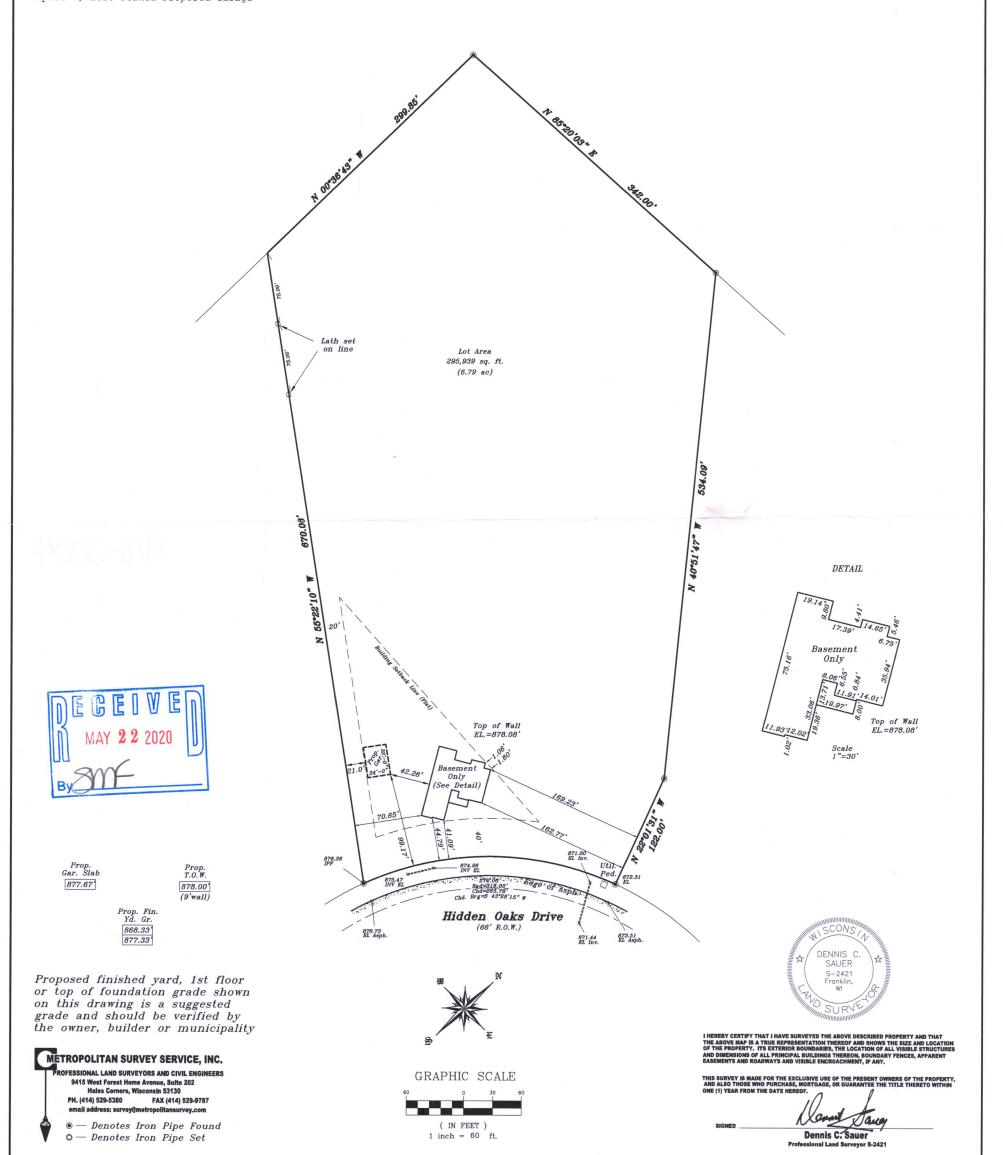

PHO-6

418-270