

PLAT OF SURVEY



THE SOUTH HALF OF LOT 4 AND ALL OF LOTS 5, 6 & 7, BLOCK 5, WILMER GROVE BEACH, LOCATED IN THE EAST HALF OF SECTION 18, T. 4 N., R. 18 E. OF THE 4TH P.M., TOWNSHIP OF EAST TROY, COUNTY OF WALWORTH, STATE OF WISCONSIN.

I HEREBY CERTIFY THAT I HAVE SURVEYED THE LAND DESCRIBED ABOVE AND THAT THE PLAT DRAWN HEREON IS A CORRECT REPRESENTATION OF SAID SURVEY.

*John F. Degen*  
JOHN F. DEGEN, LAND SURVEYOR #242  
589 N. PINE ST., BURLINGTON, WISCONSIN.

5-7-73

SCALE 1" = 30'  
o denotes iron pipe stake

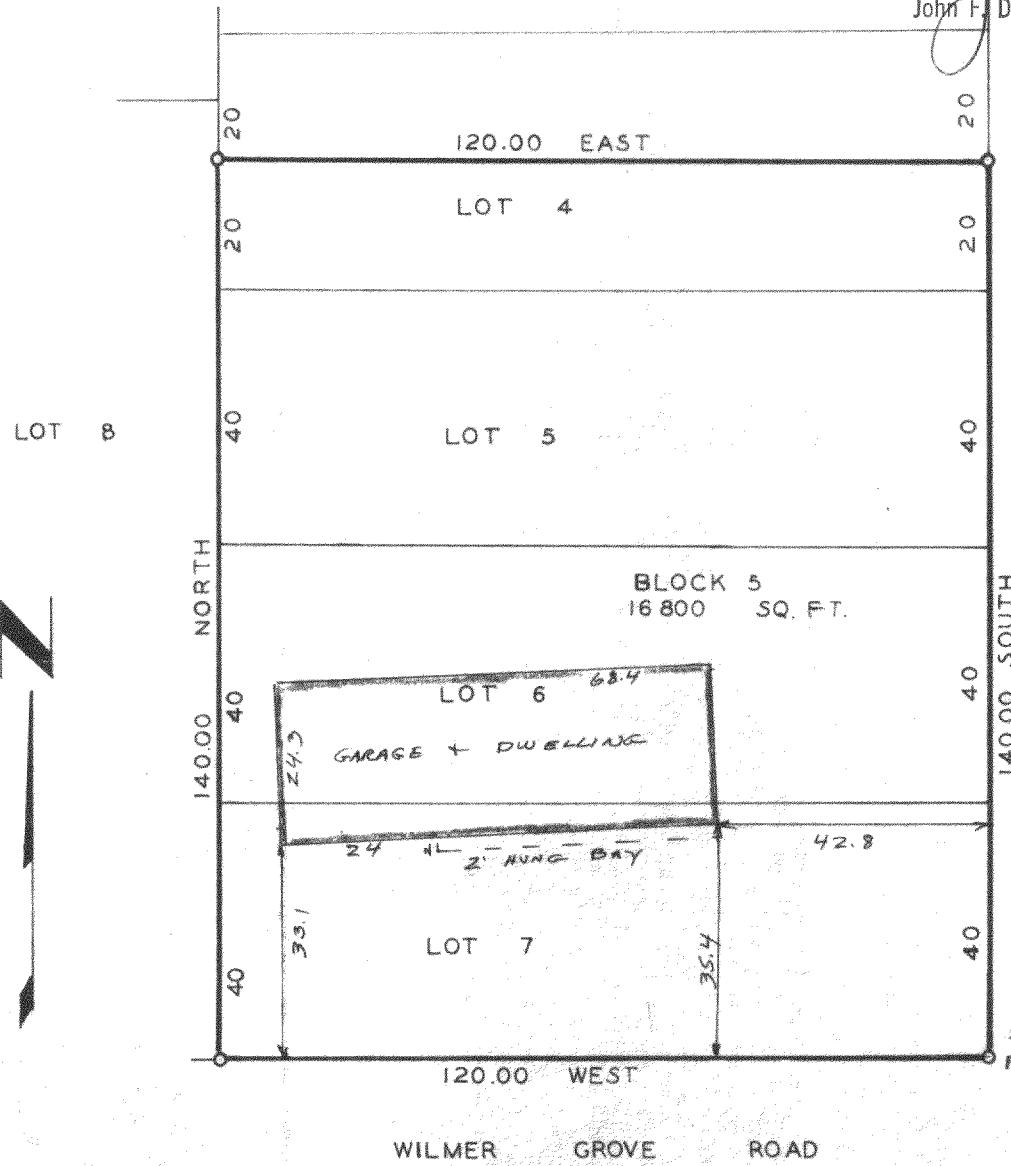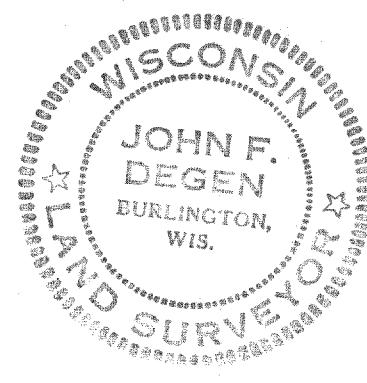

I have surveyed the above-described property, and the map hereon is a true representation thereof and shows the size and location of the property, its exterior boundaries, the location and dimensions of all visible structures thereon, fences, apparent easements and roadways and visible encroachments, if any.

This survey is made for the exclusive use of the present owners of the property, and also those who purchase, mortgage, or guarantee the title thereto, within one year from date hereof,

Dated at Burlington, this 30<sup>th</sup> day  
of JAN, 1973.

*John F. Degen*  
John F. Degen, Land Surveyor S 242

418-271

PW 10-43

REVISED 1-30-76 TO SHOW BLDG.

5-7-73 DRAWER 1-C-4

25