


LOCATION:  
N9185 Deer Path Road, East Troy, Wisconsin

PREPARED FOR:  
Lloyd S. McIndoe

OWNER:  
POT00004, POT00004A, POT00005, POT00006, POT00006A - Lloyd S. McIndoe

POT00007 - Lloyd S. McIndoe & Kathleen M. Karcher

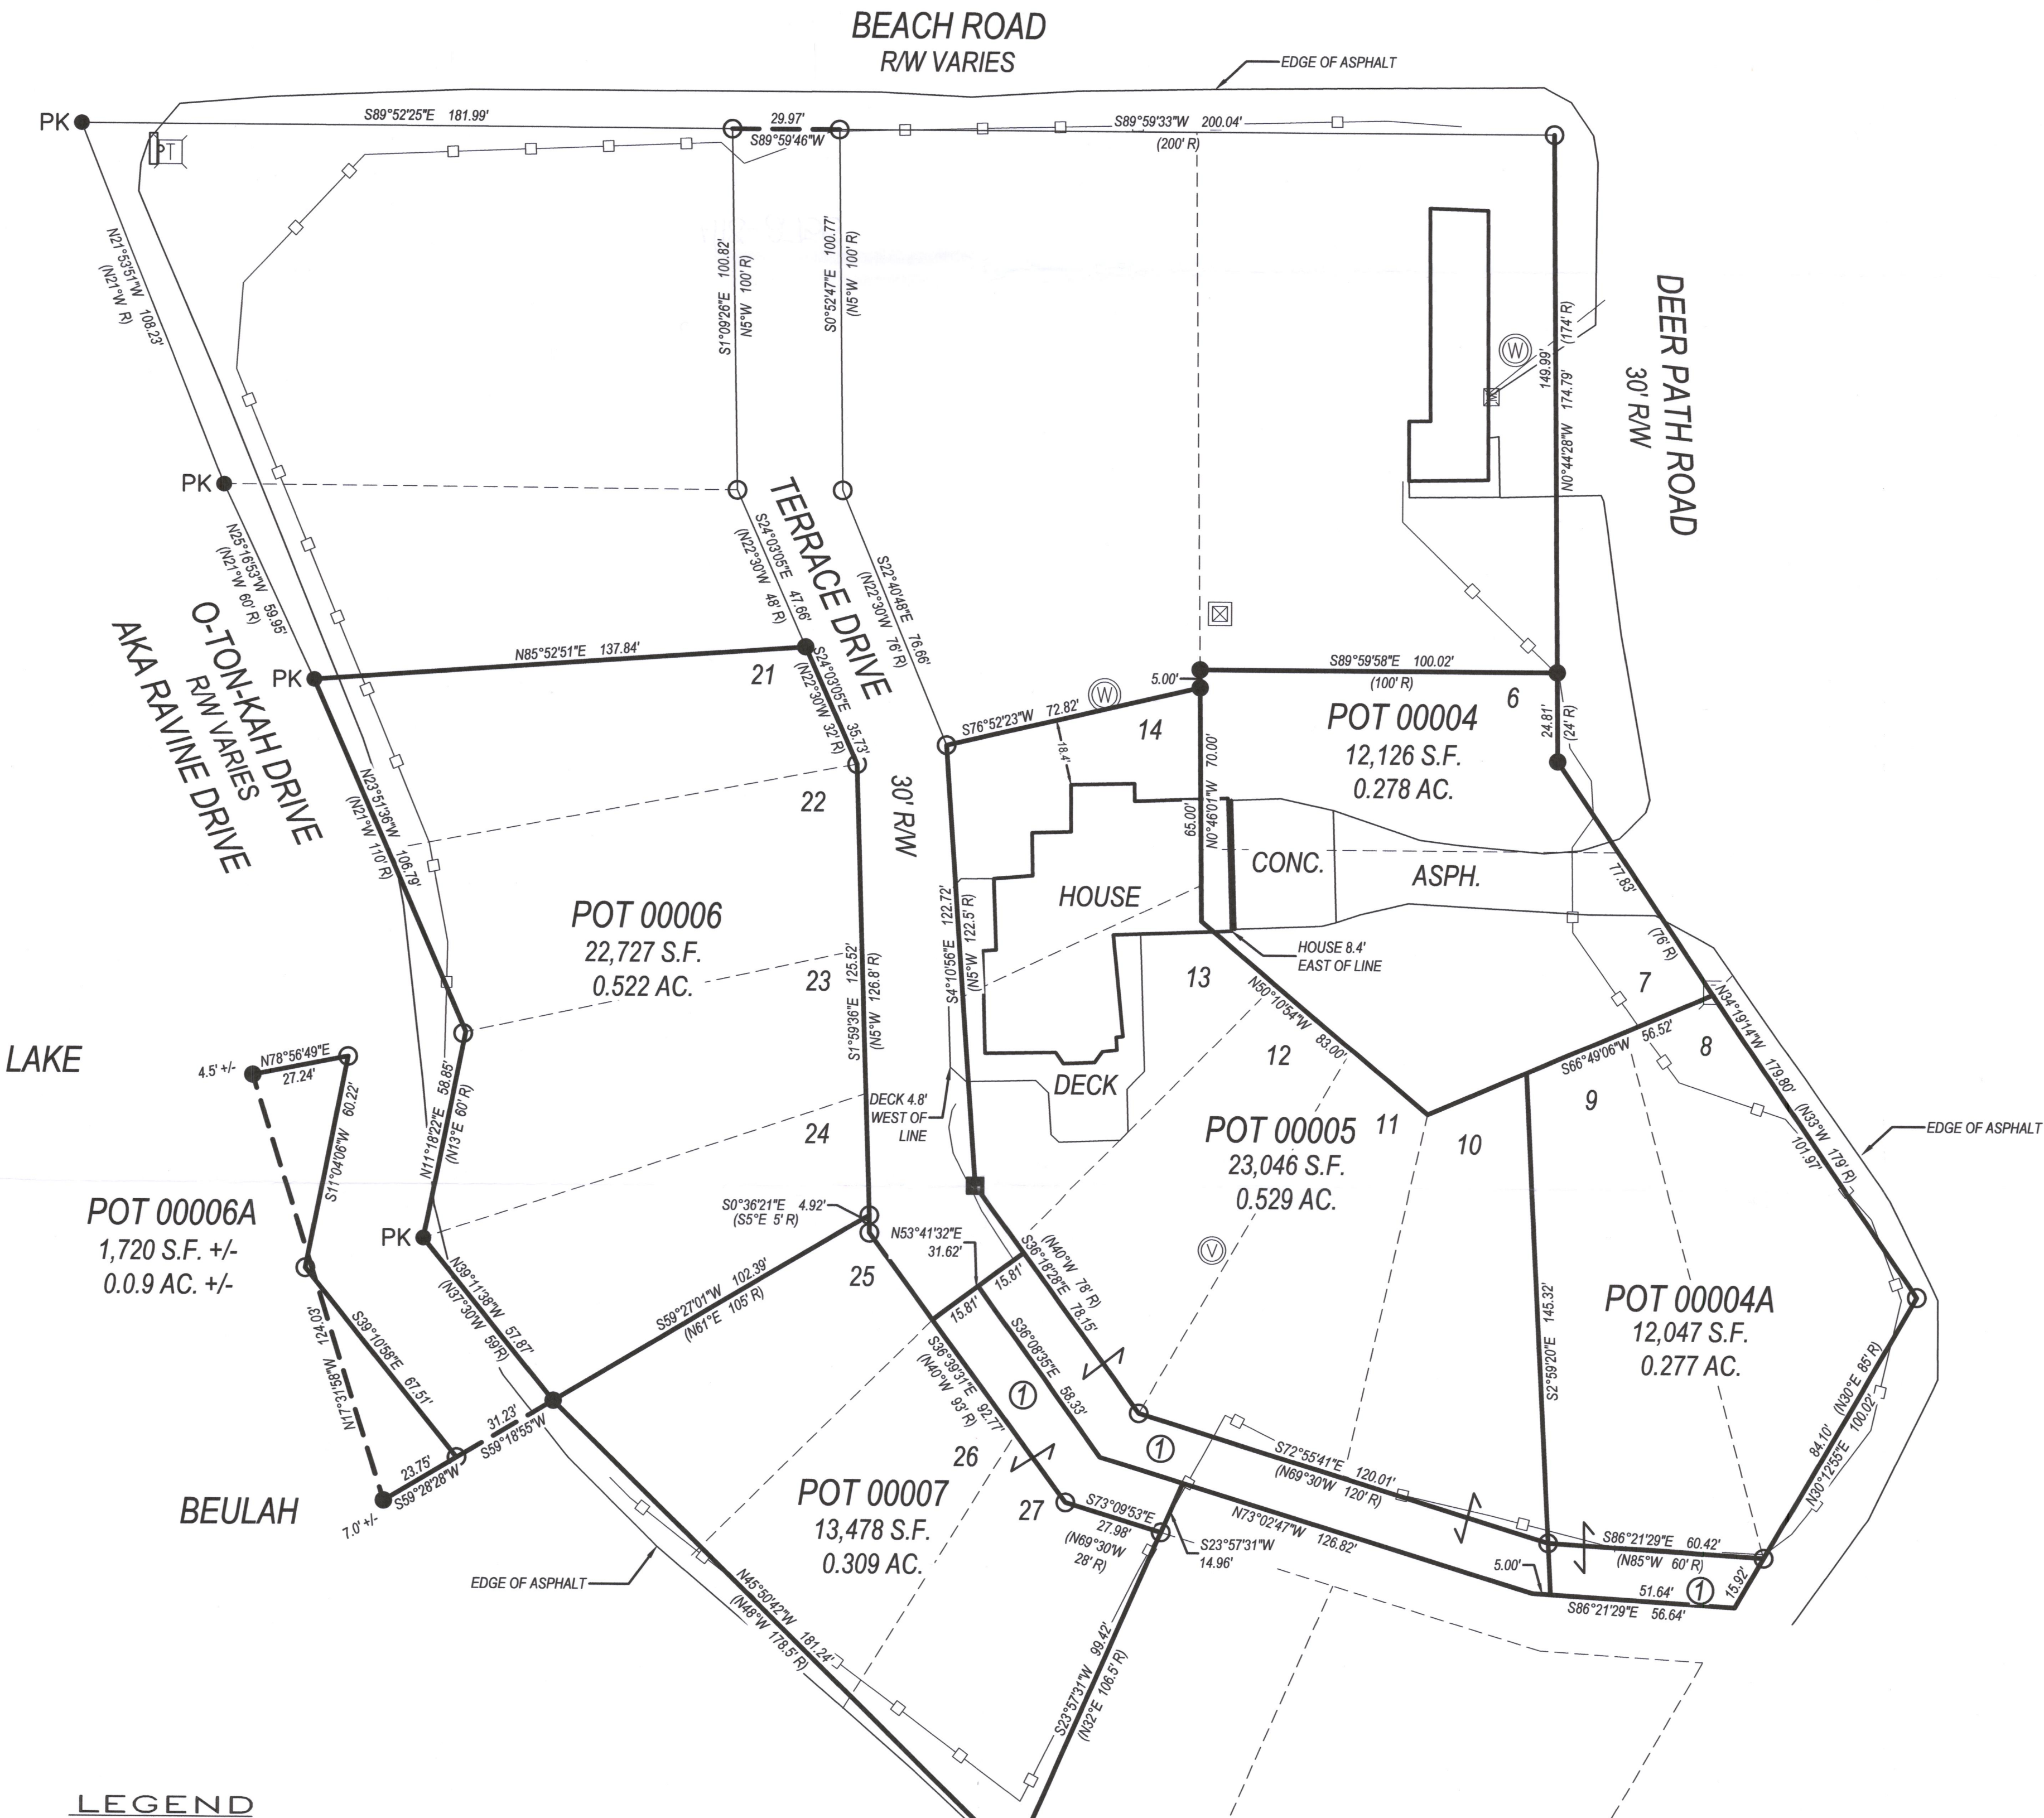

- LEGEND**
- 1" IRON PIPE – SET
  - 3/4" IRON BAR – SET
  - 1" IRON PIPE – FOUND
  - (R) RECORDED DATA
  - PK● PK NAIL – SET
  - ✕ CHISELED 'X'
  - ☒ ELECTRICAL TRANSFORMER
  - ⓐ MANHOLE – GAS
  - Ⓢ SEPTIC VENT
  - ☎ TELEPHONE PEDESTAL
  - Ⓢ WELL
  - Ⓢ SIGN



POT00004, POT00004A, POT00005, POT00006, POT00006A

**LEGAL DESCRIPTION:**  
Lots 6 to 14, both inclusive, and Lots 21 to 24, both inclusive, all in O-Ton-Kah Subdivision, according to the recorded Plat thereof, Walworth County, Wisconsin. O-Ton-Kah Subdivision Plat recorded as Document No. 262489 in the Walworth County Register of Deeds office.

Also, commencing at the SW corner of Lot 24 in O-Ton-Kah Subdivision, located in the Town of East Troy, according to the recorded Plat thereof, Thence continuing Southwesterly across the public highway to a point on the Westerly edge of said public highway, on a line forming the extension of the Southerly lot line of said Lot 24, said point being the Point Of Beginning, Thence continuing in a Southwesterly direction to the Water's edge, Thence running in a Northwesterly direction along the water's edge to a point on the water's edge which is the extension of the Northerly boundary line of Lot 23 in said O-Ton-Kah Subdivision, Thence East to the Westerly edge of the public highway, Thence in a Southeasterly direction along the Westerly edge of said public highway to the Place Of Beginning, meaning and intending to convey to grantees the property situated between the Westerly edge of said public highway and the water's edge in front of Lots 23 through 24 inclusive, O-Ton-Kah Subdivision.

POT00007

**LEGAL DESCRIPTION:**  
Lots 25, 26, and 27 in O-Ton-Kah Subdivision, Town of East Troy, Walworth County, Wisconsin, according to the recorded Plat thereof, recorded in Volume 8 of Plats on Pages 111 and 112, Document No. 262489 in the Walworth County Register of Deeds office.

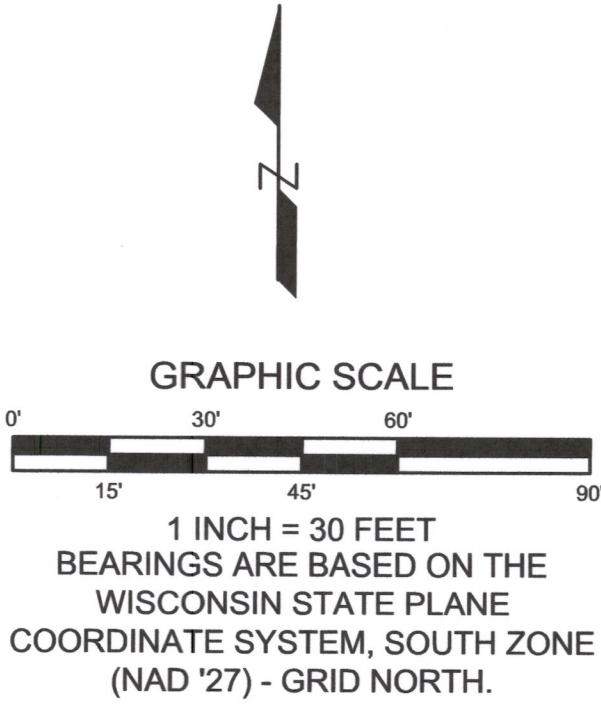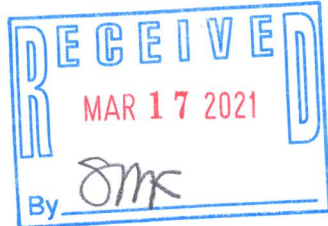

I have surveyed the above-described property and the above map is a true representation thereof and shows the size and location of the property, its exterior boundaries, the location and dimensions of all structures thereon, fences, apparent easements and roadways, and visible encroachments, if any.

No title commitment or results of a title search were provided to this office pertaining to this survey. This Plat Of Survey may not reflect easements of record, encumbrances, restrictions, ownership, title evidence, or other facts that a current and accurate title search may disclose.

This survey is made for the exclusive use of the present owners of the property, and also those who purchase, mortgage, or insure the title thereto within one (1) year from date hereof, and as to them I warrant the accuracy of said survey map.

PETER J. NIELSON, PROFESSIONAL LAND SURVEYOR, S-2527