


# PLAT OF SURVEY

LOT 3, CERTIFIED SURVEY MAP NO. 2091, BEING A PART OF THE SOUTHWEST 1/4 OF SECTION 18, TOWN 4 NORTH, RANGE 18 EAST, TOWN OF EAST TROY, WALWORTH COUNTY, WISCONSIN.

SURVEYED FOR: RUSSELL MARKESTAD



SURVEY ADDRESS: W2445 ST. PETERS ROAD

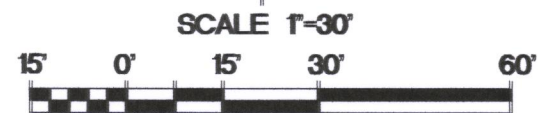

BEARINGS ARE REFERENCED TO THE SOUTH LINE OF THE SOUTHWEST 1/4 OF SECTION 18-4-18 AND IS ASSUMED TO BEAR N88°50'06"E, (NAD83).

✕ FOUND 3/4" IRON ROD  
( ) RECORDED AS DIMENSIONS

IMPROVEMENTS NOT LOCATED PER OWNERS REQUEST.

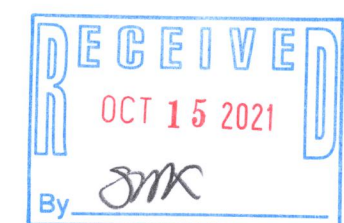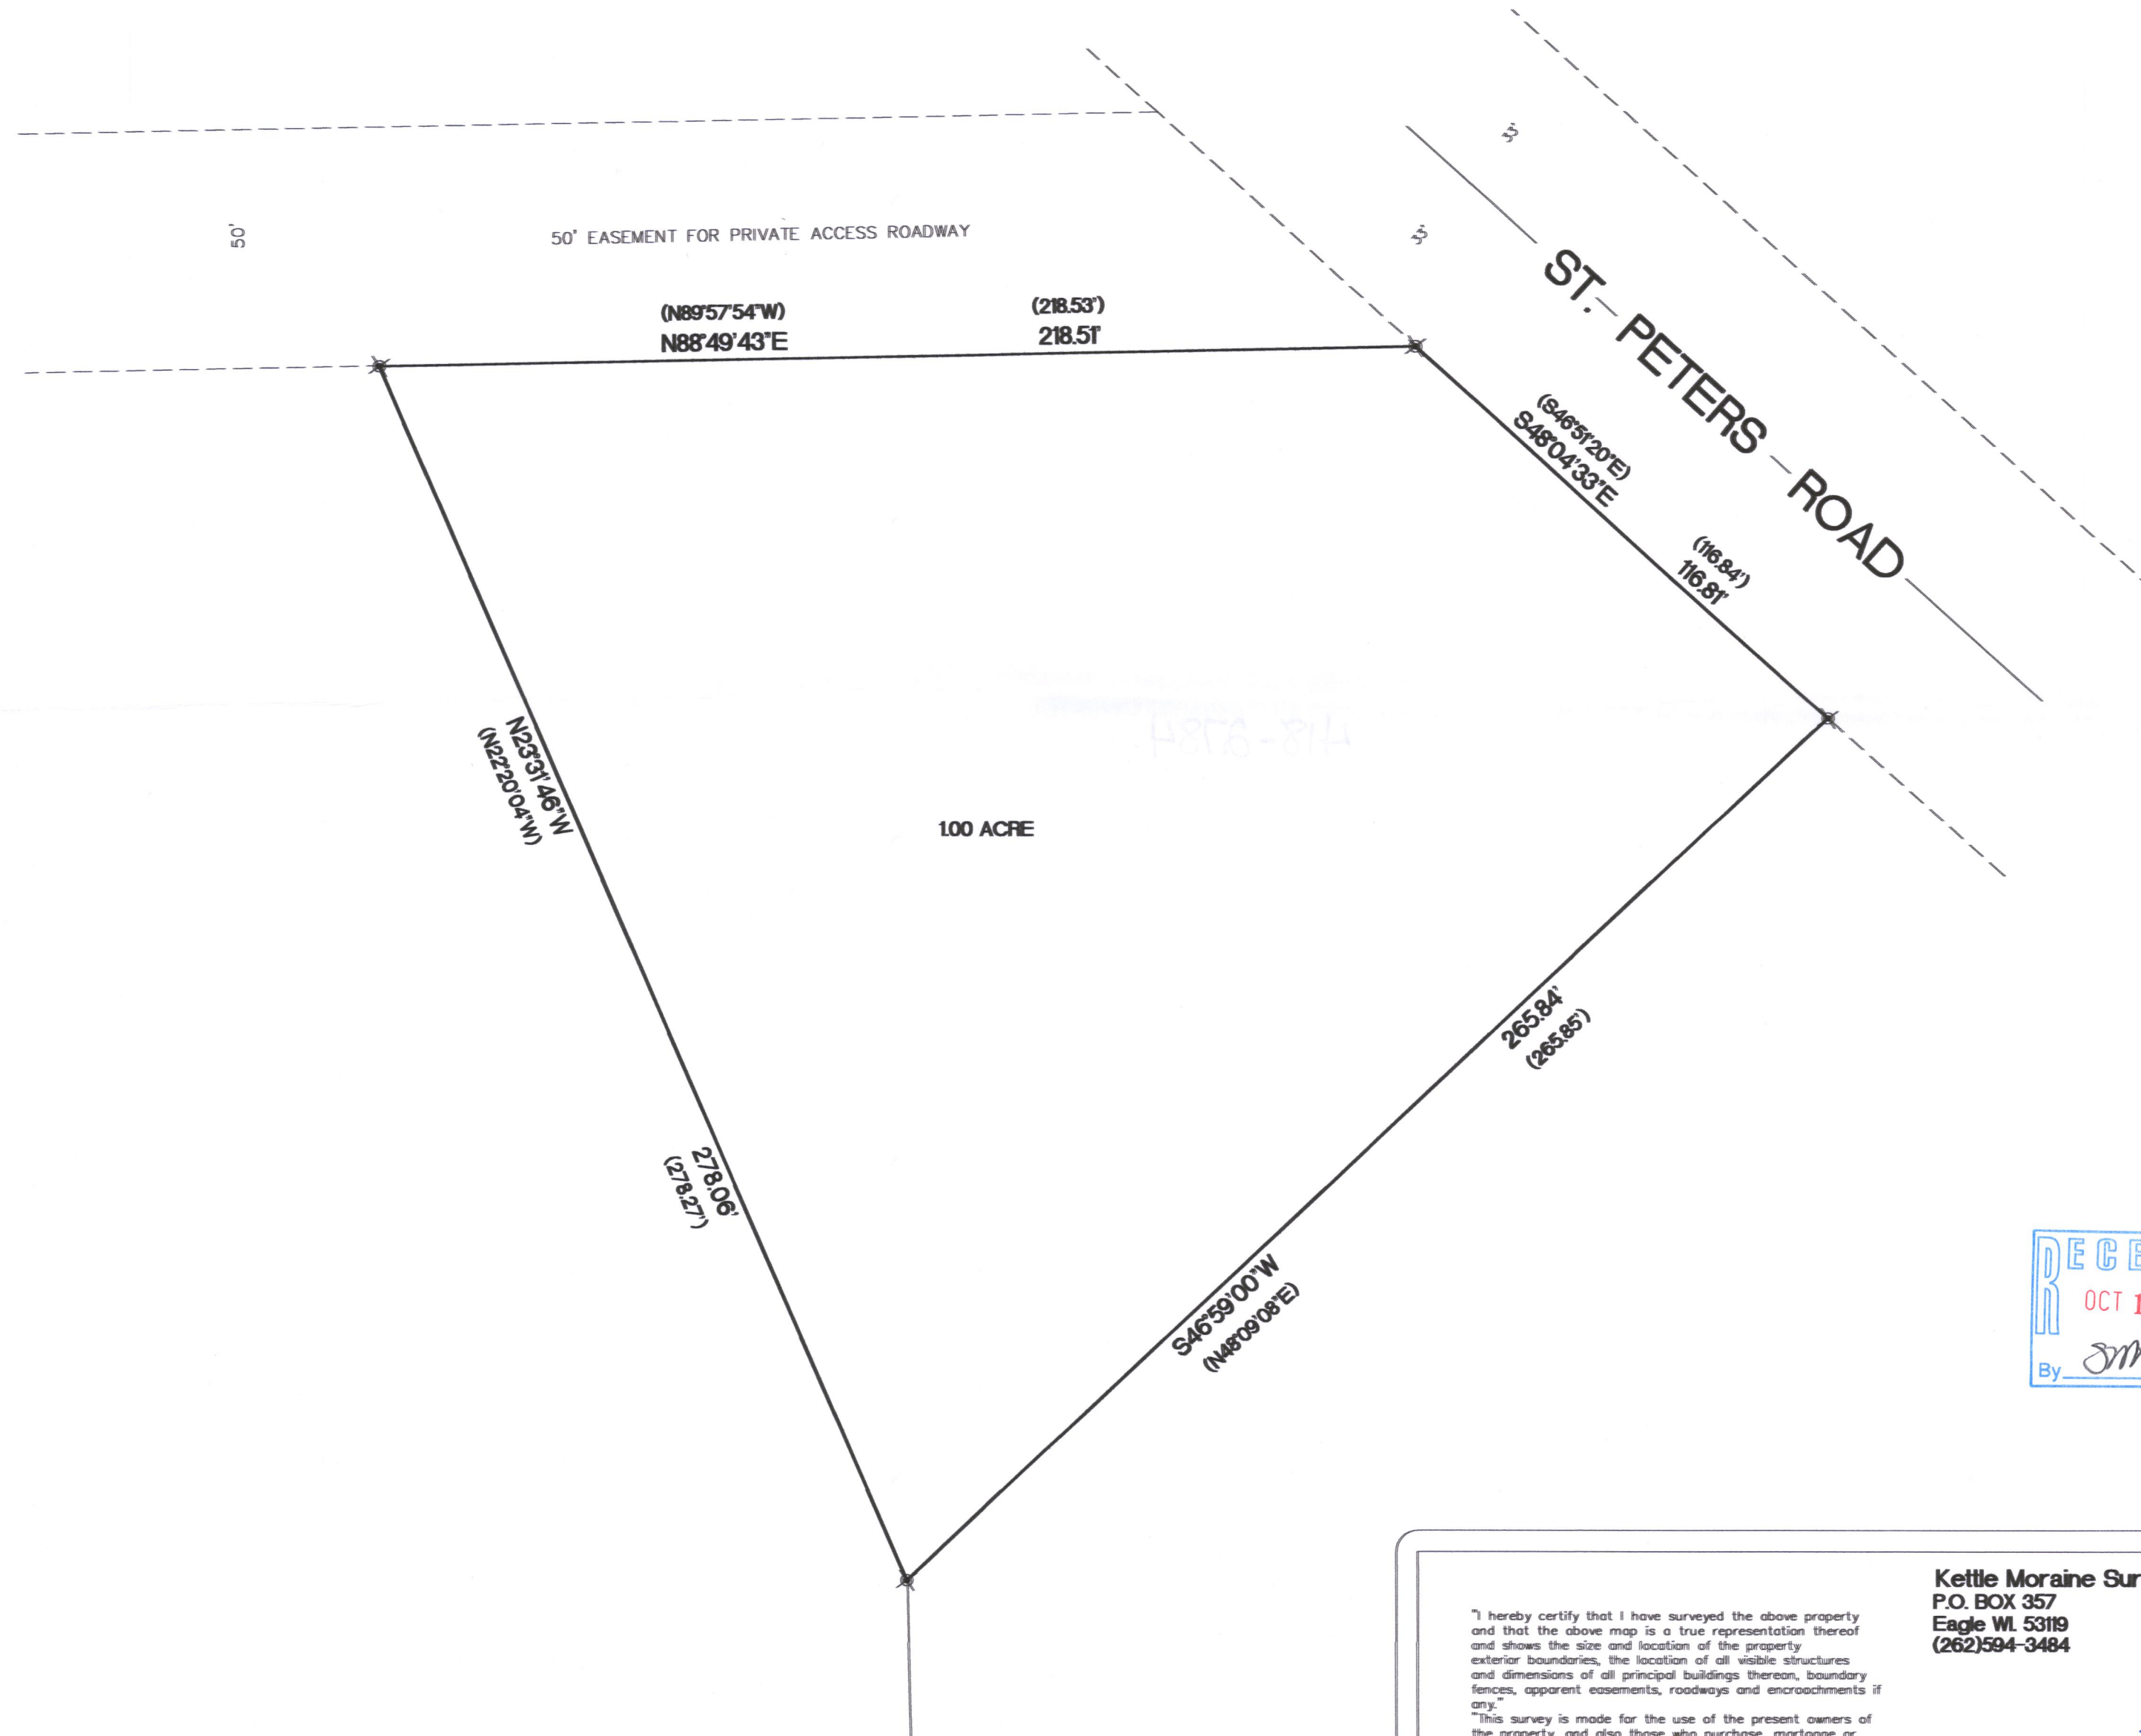

"I hereby certify that I have surveyed the above property and that the above map is a true representation thereof and shows the size and location of the property exterior boundaries, the location of all visible structures and dimensions of all principal buildings thereon, boundary fences, apparent easements, roadways and encroachments if any."  
"This survey is made for the use of the present owners of the property, and also those who purchase, mortgage or guarantee the title thereto within one year from date hereof."

Kettle Moraine Surveying Inc.  
P.O. BOX 357  
Eagle WI 53119  
(262)594-3484



THIS IS NOT AN ORIGINAL SURVEY UNLESS IT IS SIGNED BY THE SURVEYOR

10/11/2021 DATE TEP FIELD WORK BY TEP DRAWN BY 21131 JOB NUMBER

PA2091-3

418-2708

418-8184