



B.W. SURVEYING, INC.

LAND SURVEYS
MAPPING AND PLANNING
412 N. PINE STREET
BURLINGTON, WI 53105
(262)-767-0225


BEARINGS HEREON RELATE TO THE WEST LINE OF E. SHORE ROAD. ASSUMED BEARING SOUTH 06°30'00" EAST.

PLAT OF SURVEY -OF-

LOT 1, CERTIFIED SURVEY MAP NO. 1050, BEING A PART OF BLOCK 1, FREES PARK SUBDIVISION, LOCATED IN THE SOUTH 1/2 OF SECTION 4, TOWNSHIP 4 NORTH, RANGE 18 EAST IN THE TOWN OF EAST TROY, COUNTY OF WALWORTH AND STATE OF WISCONSIN.

SURVEY FOR: PATRICK KLINE

SURVEY ADDRESS: N9463 E. SHORE ROAD

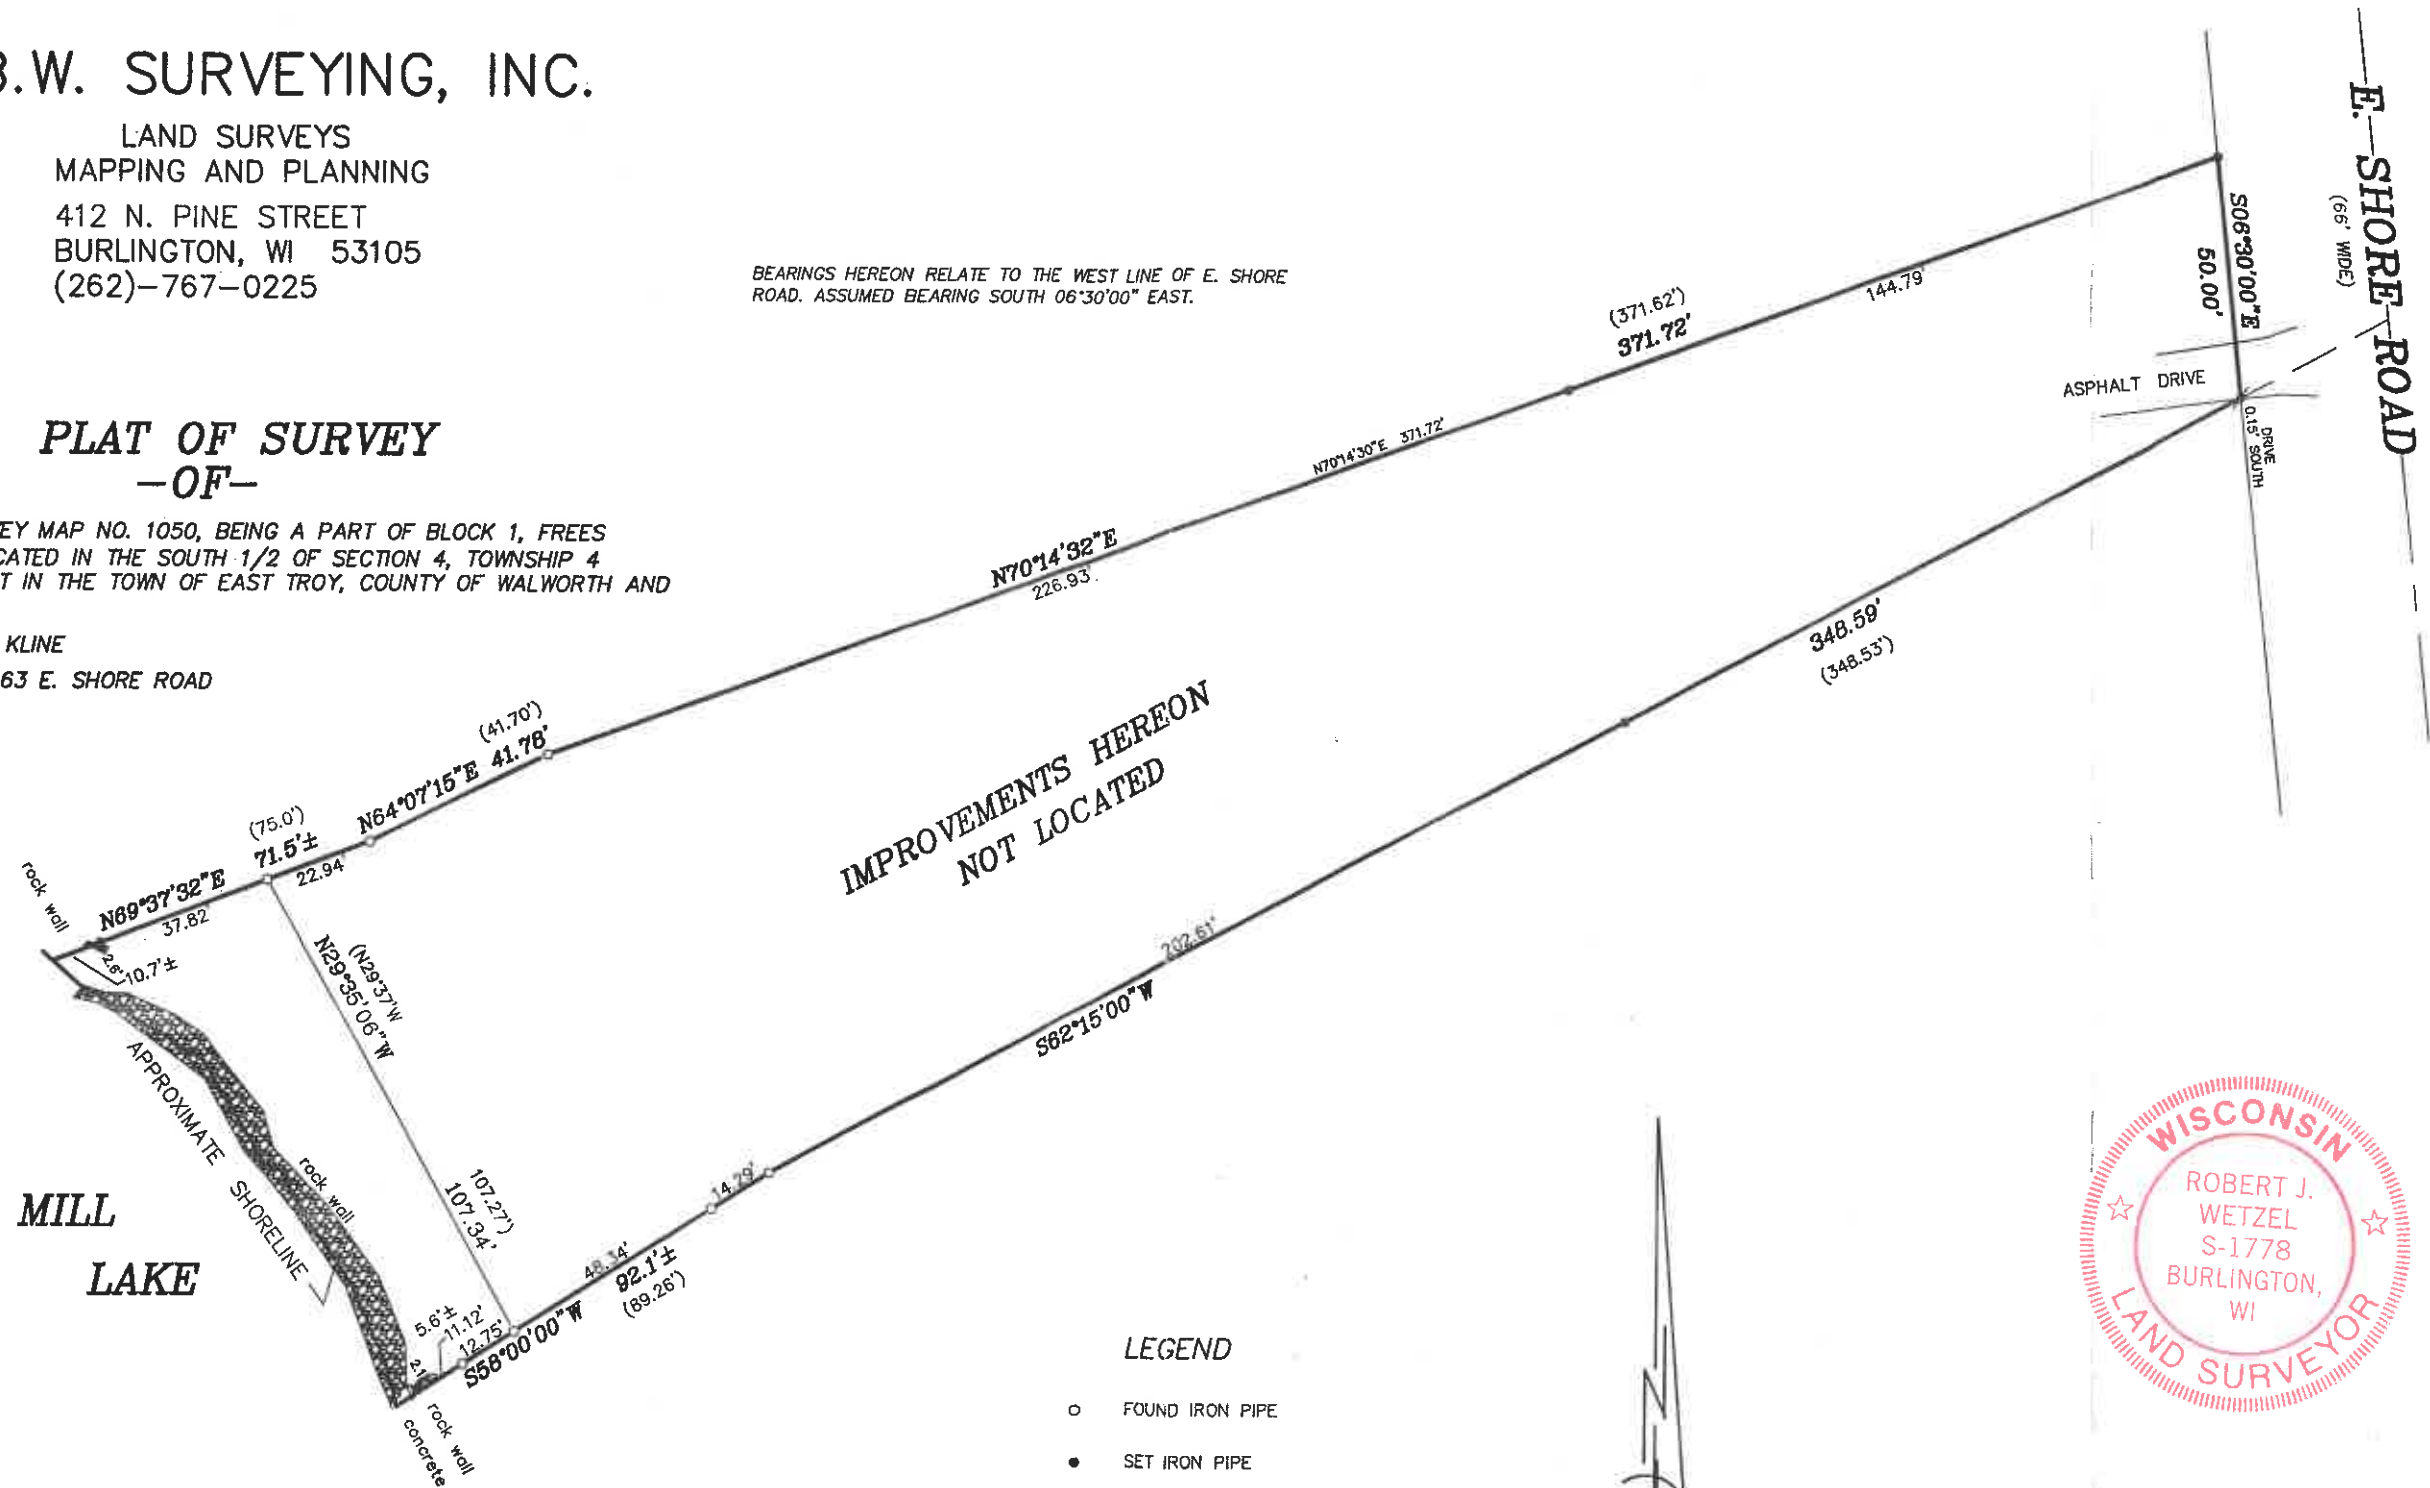

IMPROVEMENTS HEREON
NOT LOCATED

MILL
LAKE



LEGEND

- FOUND IRON PIPE
- SET IRON PIPE
- ✎ FOUND P.K. NAIL
- ✎ SET 10' SPIKE



SCALE 1" = 40'

GRAPHIC SCALE

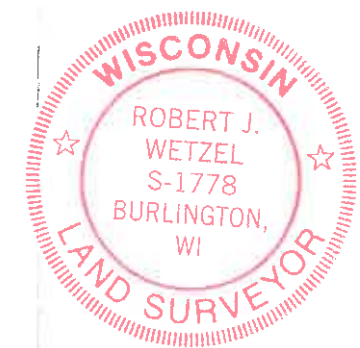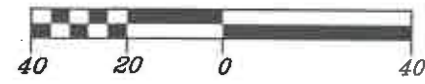

THIS IS NOT AN ORIGINAL PRINT
UNLESS THIS SEAL IS RED.

Robert J. Wetzel
ROBERT J. WETZEL S-1778

"I hereby certify that I have surveyed the above described property and that the above map is a correct representation thereof and shows the size and location of the property, and its exterior boundaries.

"This survey is made for the use of the present owners of the property, and those who purchase, mortgage, or guarantee the title thereto within one year from date hereof."

OCTOBER 22, 2021
DATE

10534
JOB NUMBER